

Name: GIGI DANIEL
 Street Address: 5020 WATERLOO RD
 City, State, Zip: ELLCOTT CITY, MD 2043
 Date: 2/1/19

Amendment, Permit # B17003792

Ms. Debbie Whalen
 Division of Plan Review
 Department of Inspections, Licenses and Permits
 Howard County Government
 3430 Court House Dr
 Ellicott City, MD 21043

Dear Ms. Whalen:

I am requesting to amend Permit # B17003792 at
5020 WATERLOO RD, Bed Room #1 to 3 and #5 to 9 into
Storage Room #1 to 3 and #5 to 9

Also, plan to convert all Storage Rooms into Bed Rooms
before obtaining the ALF permit

Enclosed:

✓ Fee: \$25.00 CK # 852 - (Gigi Daniel)
 _____ Plot Plans
2 Sets of Construction Drawings
 _____ Other: _____


If there is anything we can do to assist you, please let me know.

Sincerely,


CC: Health

Name: GIGI DANIEL
 Title: Owner
 Phone: 267 253 4849
 Email: gigilinda@gmail.com


B17003792

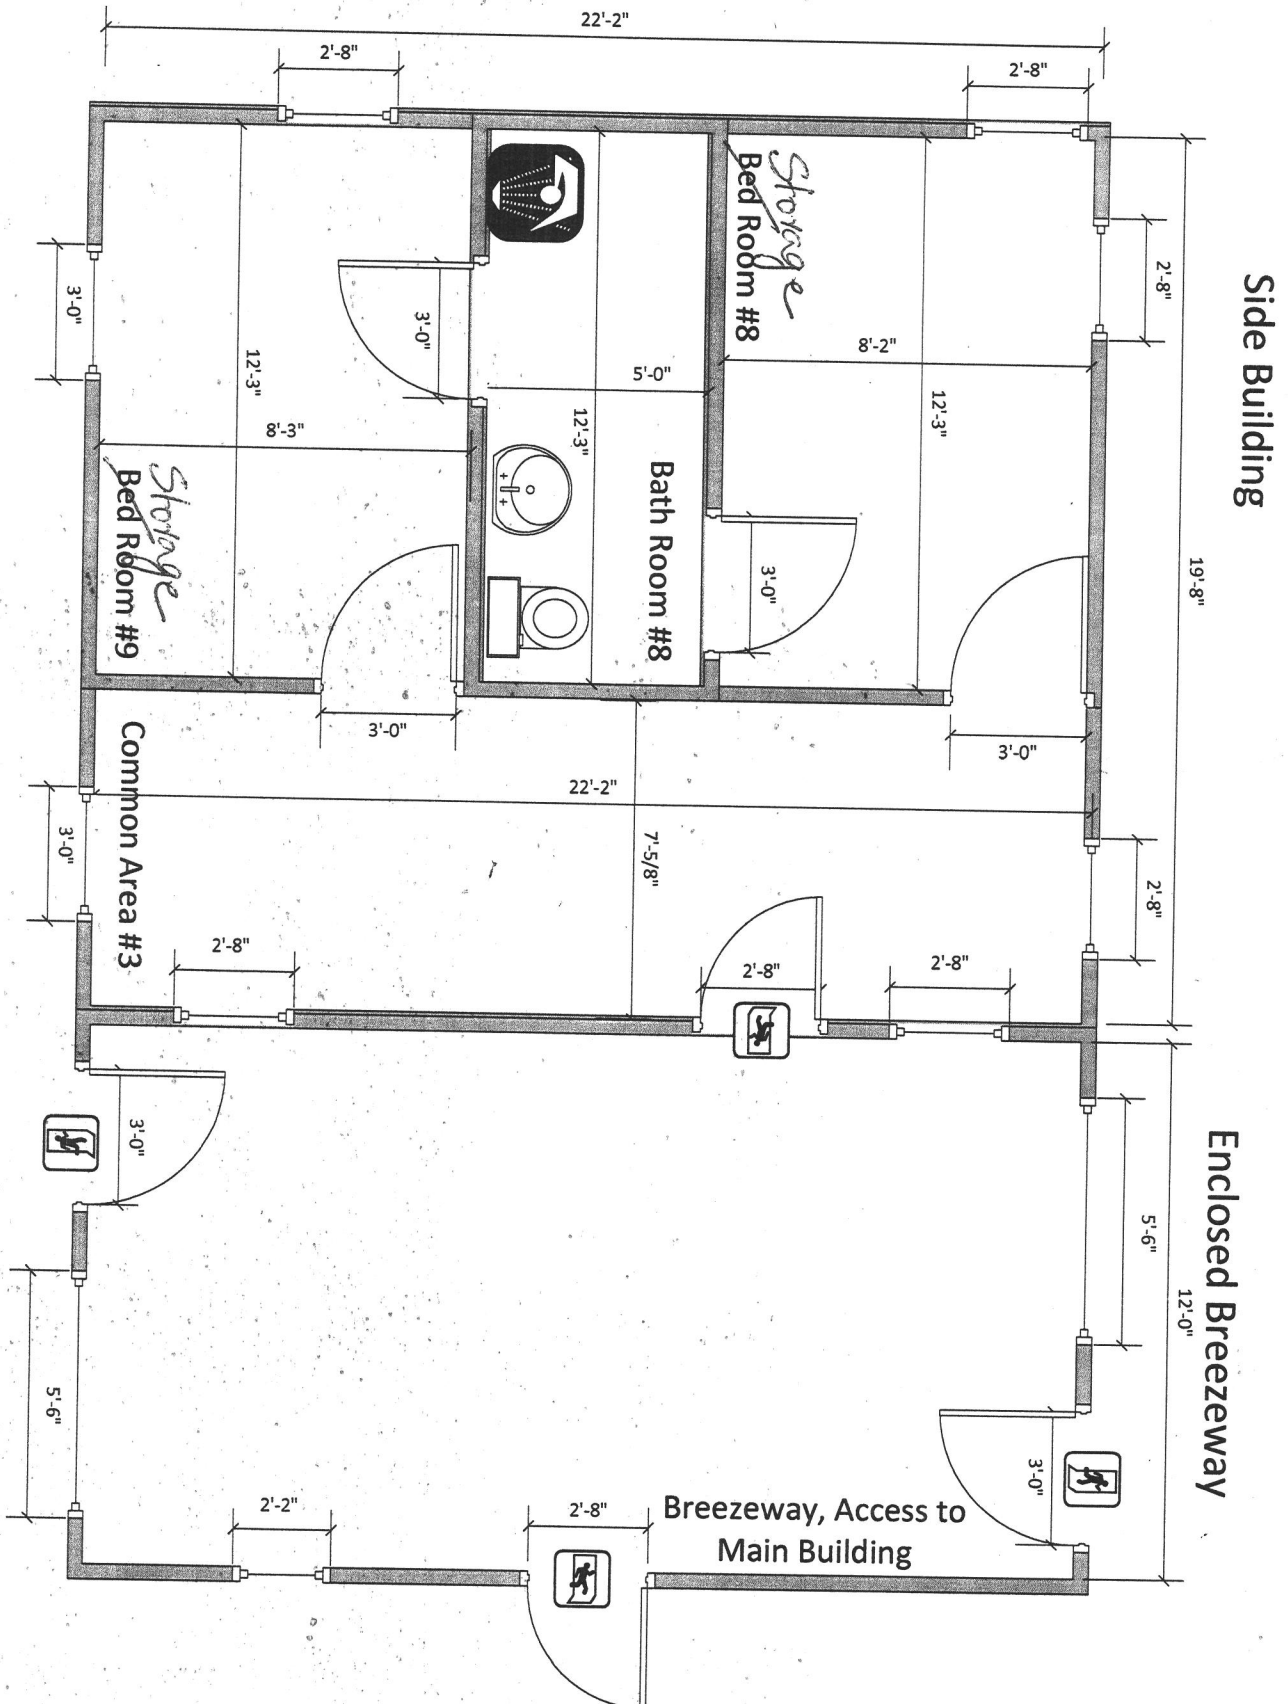

Main Floor/Building

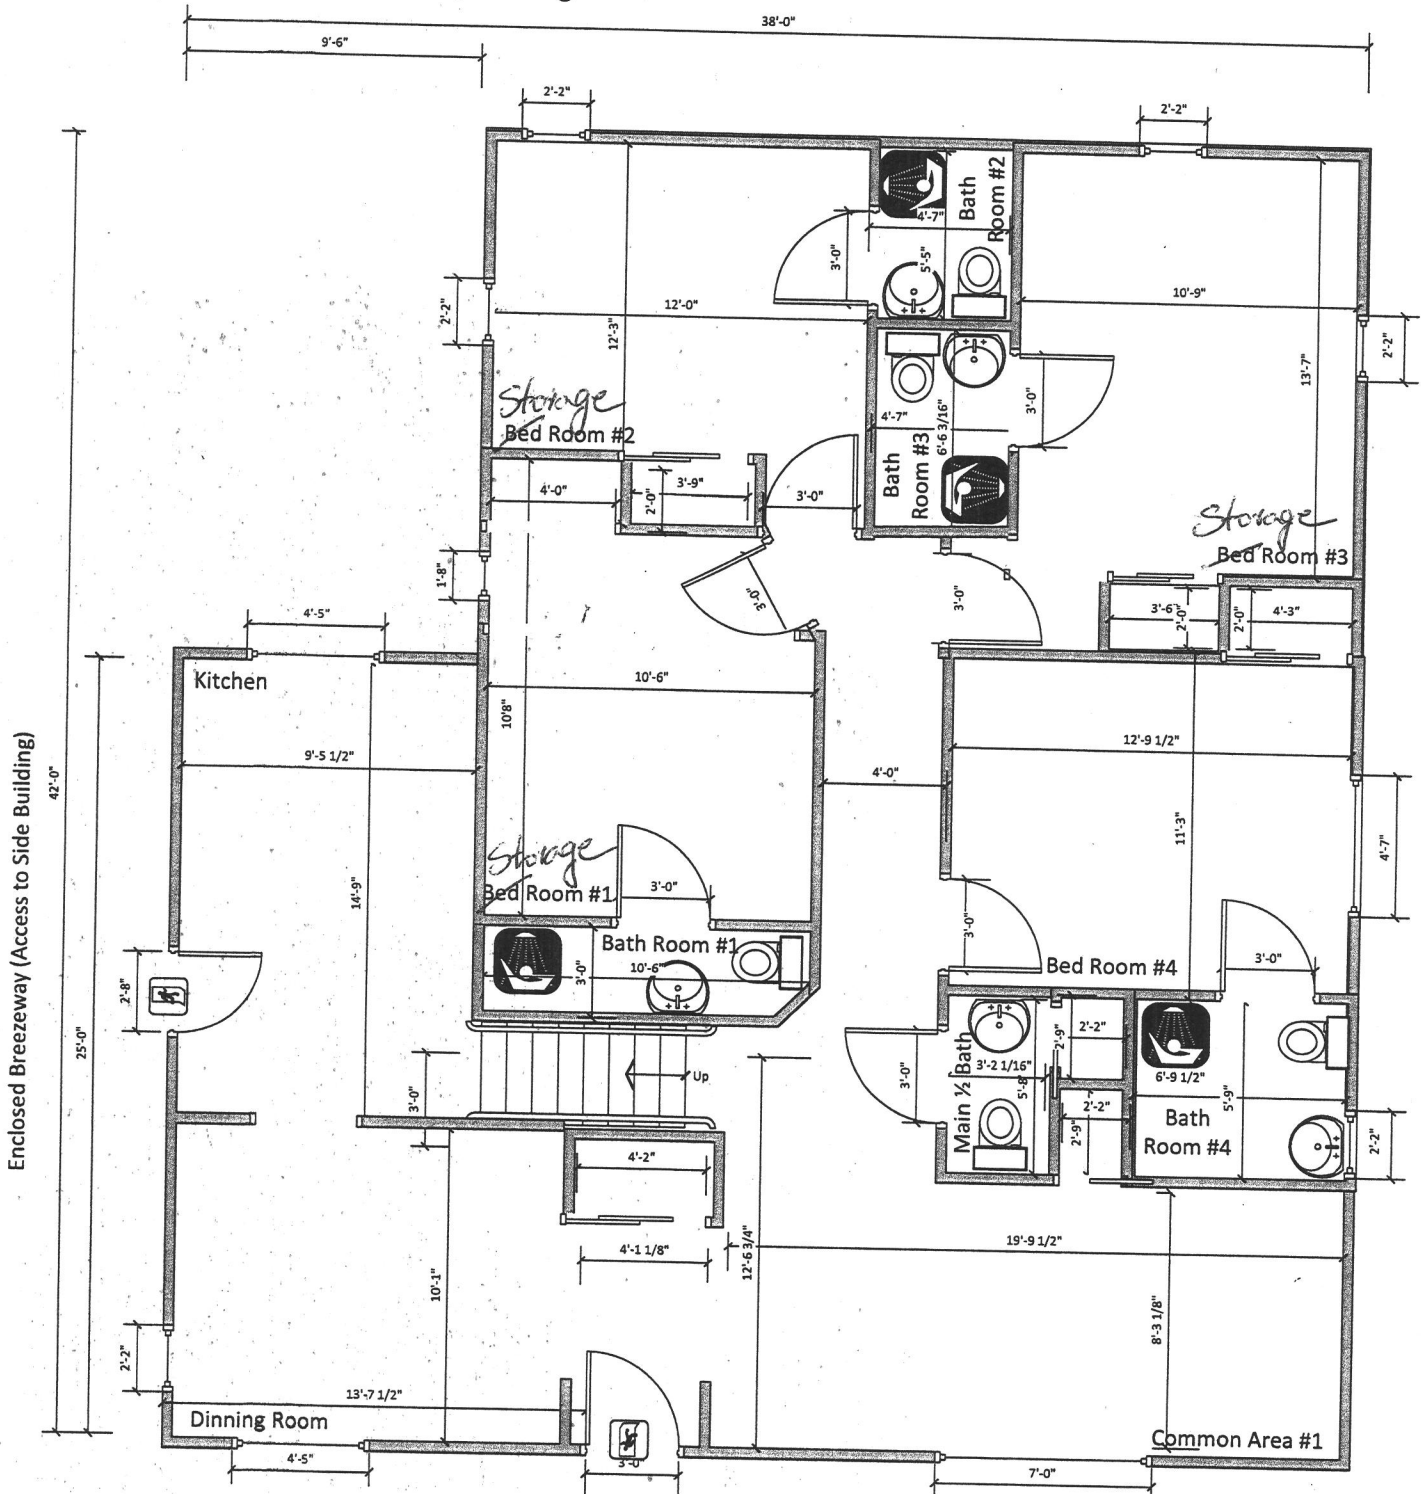

Basement - Main Building

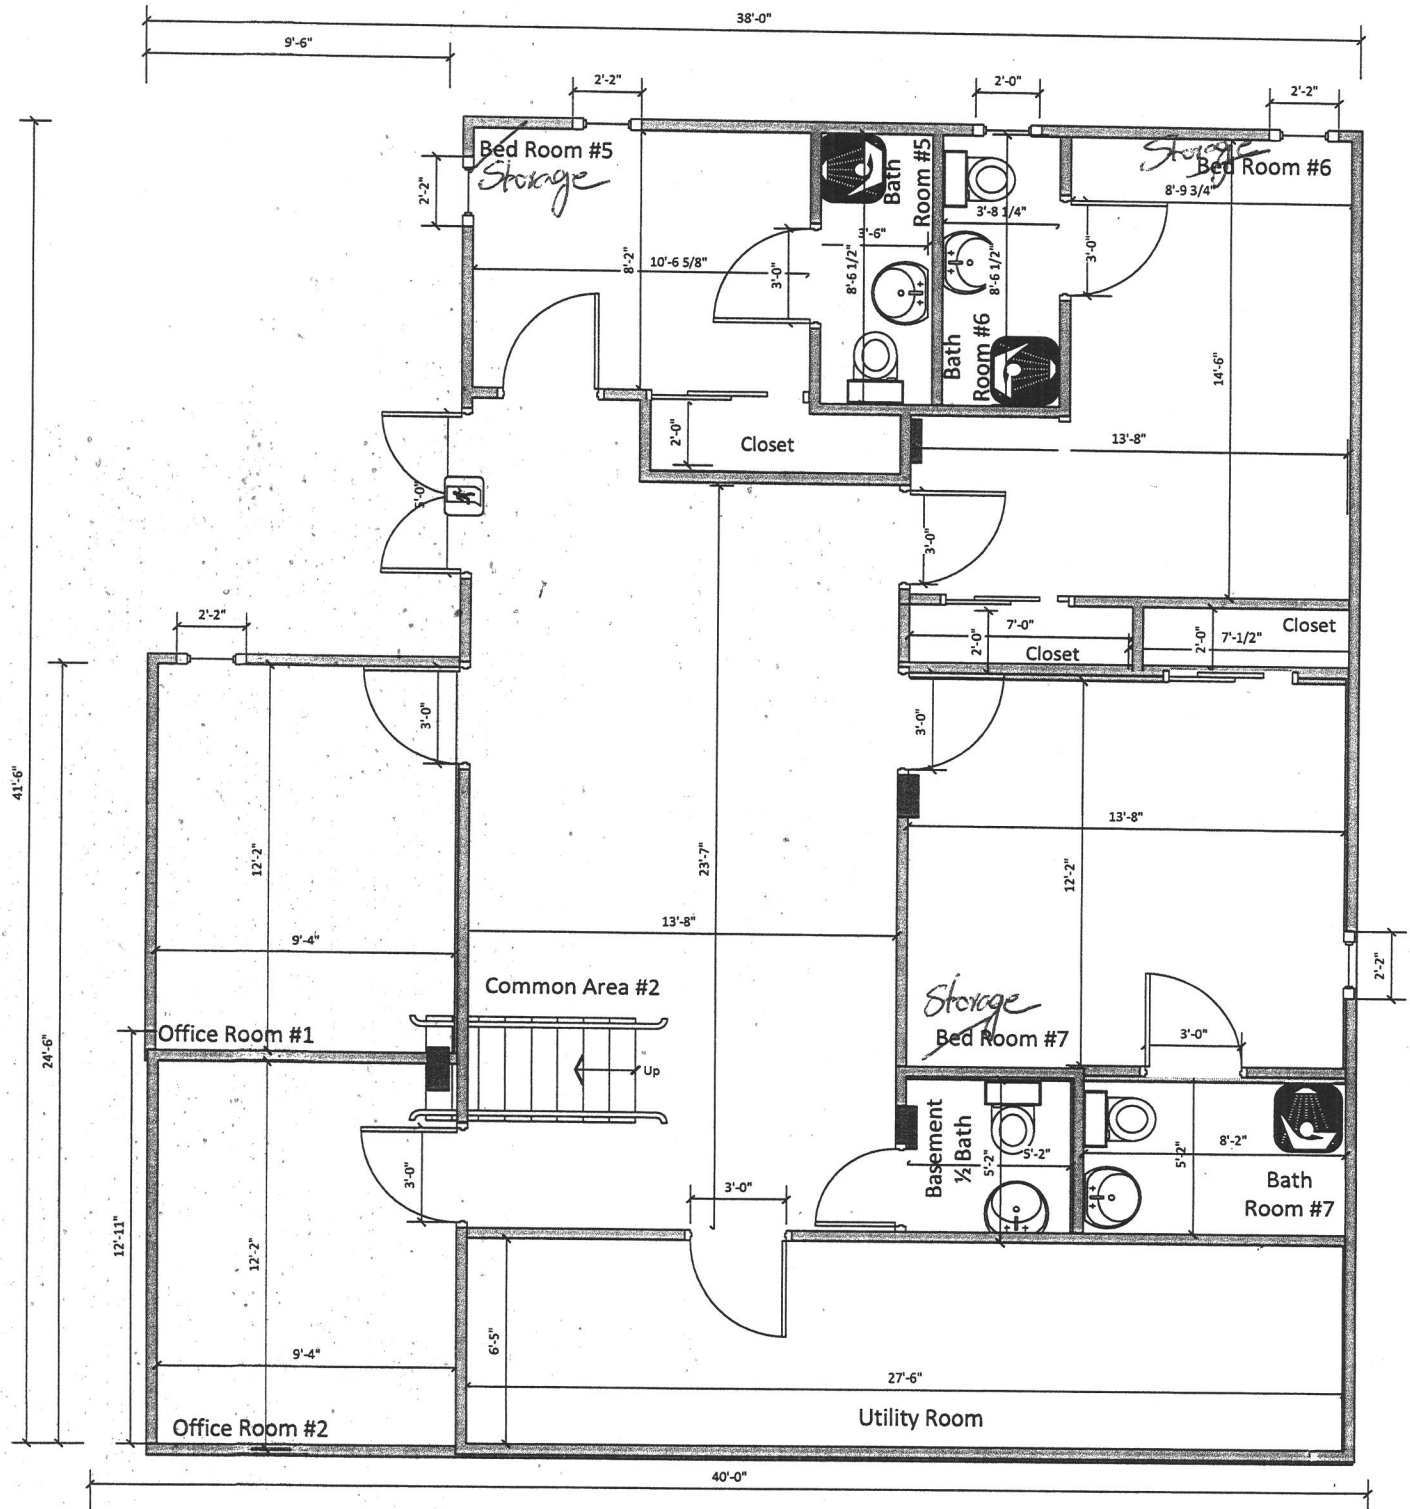

B17003792

Attic-Main Building

