

APPLICATION

PERCOLATION TESTING

A NO FEE

P _____

HOWARD COUNTY HEALTH DEPARTMENT

BUREAU OF ENVIRONMENTAL HEALTH

3525-H ELLICOTT MILLS DRIVE/ELLICOTT CITY, MARYLAND 21043
TELEPHONE: 313-2640

DISTRICT _____

DATE 10/2/01

TO: THE COUNTY HEALTH OFFICER
ELLICOTT CITY, MARYLAND

I HEREBY APPLY FOR THE NECESSARY TEST PRIOR TO APPLICATION FOR PERMIT TO CONSTRUCT (OR RECONSTRUCT) A SEWAGE DISPOSAL SYSTEM.

PROPERTY OWNER _____

ADDRESS _____ PHONE _____

AGENT OR PROSPECTIVE BUYER _____

ADDRESS _____ PHONE _____

PROPERTY LOCATION:

SUBDIVISION Buice Property, Sec 1 LOT NO. 3

ROAD AND DESCRIPTION _____

TAX MAP _____ PARCEL # _____

SIZE OF LOT _____ TYPE BLDG. _____
(SINGLE FAMILY DWELLING OR COMMERCIAL)

THE SYSTEM INSTALLED UNDER THIS APPLICATION IS ACCEPTABLE ONLY UNTIL PUBLIC FACILITIES BECOME AVAILABLE. I FULLY UNDERSTAND THE FEE CONNECTED WITH THE FILING OF THIS PERC TEST APPLICATION IS NON-REFUNDABLE UNDER ANY CIRCUMSTANCES. I ALSO AGREE TO COMPLY WITH ALL M.O.S.H.A. REQUIREMENTS IN TESTING THIS LOT.

(SIGNATURE OF APPLICANT) _____

APPROVED BY _____ FOR _____ DATE _____

DISAPPROVED BY _____ FOR _____ DATE _____

HOLD PENDING FURTHER TESTS _____

REASONS FOR REJECTION OR HOLDING _____

PERCOLATION TEST PLAT/PRELIMINARY PLAT - TITLE OR I.D. # _____ DATE _____

SITE DEVELOPMENT PLAN/FINAL PLAT - TITLE OR I.D. # _____ DATE _____

THIS IS NOT A PERMIT

COUNTY #

SOIL PROFILE


0' 5004
 6" brown topsoil
 orange-brown sandy lm
 4' tan beige sandy loam
 20-30% Rock FRAGS
 13' HARD

5003B


12" brown topsoil
 tan-sandy loam
 20-30% Rock FRAGS
 13' HARD

5003

4" brown topsoil
 tan loam
 2' orange-brown denser sandy loam
 4' orange-tan sandy loam
 6' pocket of rock
 40-70% flaggy rock
 13'

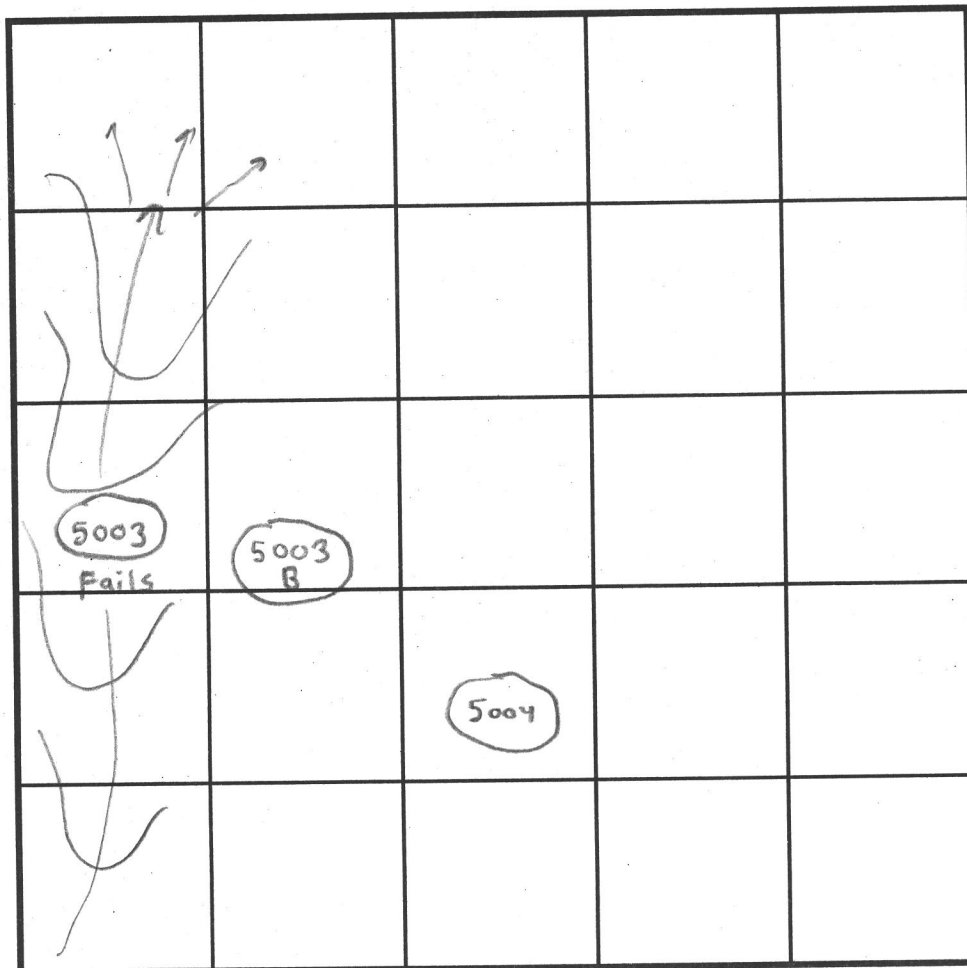

SOIL PROFILE

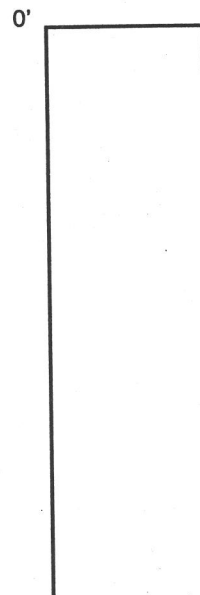

INDICATE NORTH - NAME ADJOINING ROADWAY AS BASE LINE.

DATE	TEST NO.	DEPTH	PRE-WET		TEST - 1" DROP		TIME	
			START	STOP	START	STOP		
10/2/01	5004	4'6" T 13' V	1:24pm	1:28pm	1:28pm	1:31pm	3min	OK
	5003B	6' T 13' V	3:44pm	3:46pm	3:46pm	3:49pm	3min	OK
	5003	4'6" T 13' V	1:07pm	1:08pm	1:08pm	1:09pm	1min	F
	Treatment Zone →	Repour 7' T	2:31:00	2:31:05	NA	NA	5sec	F
		Visual holes within perc holes						

REMARKS

TYPE OF SOIL

Manor

TESTED BY

SRK/SO

Mike Johnson = Backhoe

Willie = Helper

ALSO PRESENT

TRENCH DESIGN DATA: AVERAGE PERCOLATION TIME

TRENCH WIDTH

INLET DEPTH

2-3'

MAXIMUM BOTTOM DEPTH

5'

SQ. FT/BEDROOM

APPLICATION

PERCOLATION TESTING

A 59935A

P _____

HOWARD COUNTY HEALTH DEPARTMENT

BUREAU OF ENVIRONMENTAL HEALTH

3525-H ELLICOTT MILLS DRIVE/ELLICOTT CITY, MARYLAND 21043
TELEPHONE: 313-2640

DISTRICT _____

DATE 4/13/98

TO: THE COUNTY HEALTH OFFICER
ELLICOTT CITY, MARYLAND

I HEREBY APPLY FOR THE NECESSARY TEST PRIOR TO APPLICATION FOR PERMIT TO CONSTRUCT (OR RECONSTRUCT) A SEWAGE DISPOSAL SYSTEM.

PROPERTY OWNER ROBERT P. BUICE

ADDRESS 7979 MUNCASTER MILL ROAD PHONE 410-975-0200

AGENT OR PROSPECTIVE BUYER DONALD R. REWIRE LAND DESIGN & DEV INC.

ADDRESS 10805 HICKORY RIDGE ROAD PHONE 410-740-2100
COLUMBIA, MD 21044

PROPERTY LOCATION:

SUBDIVISION BUICE PROPERTY, Sec 1 LOT NO. 2

ROAD AND DESCRIPTION EAST SIDE OLD ROXBURY ROAD

JUST EAST OF INTERSECTION OF RT 97 & ROXBURY MILL ROAD

TAX MAP 21 PARCEL # 84 GRID 20

SIZE OF LOT ONE ACRE TYPE BLDG. SF D
(SINGLE FAMILY DWELLING OR COMMERCIAL)

THE SYSTEM INSTALLED UNDER THIS APPLICATION IS ACCEPTABLE ONLY UNTIL PUBLIC FACILITIES BECOME AVAILABLE. I FULLY UNDERSTAND THE

FEE CONNECTED WITH THE FILING OF THIS PERC TEST APPLICATION IS NON-REFUNDABLE UNDER ANY CIRCUMSTANCES. I ALSO AGREE TO

COMPLY WITH ALL M.O.S.H.A. REQUIREMENTS IN TESTING THIS LOT. DONALD R. REWIRE JR
(SIGNATURE OF APPLICANT)

APPROVED BY _____ FOR _____ DATE _____

DISAPPROVED BY _____ FOR _____ DATE _____

HOLD PENDING FURTHER TESTS _____

REASONS FOR REJECTION OR HOLDING _____

PERCOLATION TEST PLAT/PRELIMINARY PLAT - TITLE OR I.D. # _____ DATE _____

SITE DEVELOPMENT PLAN/FINAL PLAT - TITLE OR I.D. # _____ DATE _____

THIS IS NOT A PERMIT

59935A

COUNTY #

SOIL PROFILE

0'

554

Orange
brown
clay
loamWater
seeping
in at
cave-in
5.0'
WATER

9.0'

553

Orange
clay
loam

4.5'


tan
orange
SCLM
rock
outcrop
6.0' some
large boulders
20%
rock
frags

11.0'

556

red/
brown
clay
loamRock
+
Water

4.0'

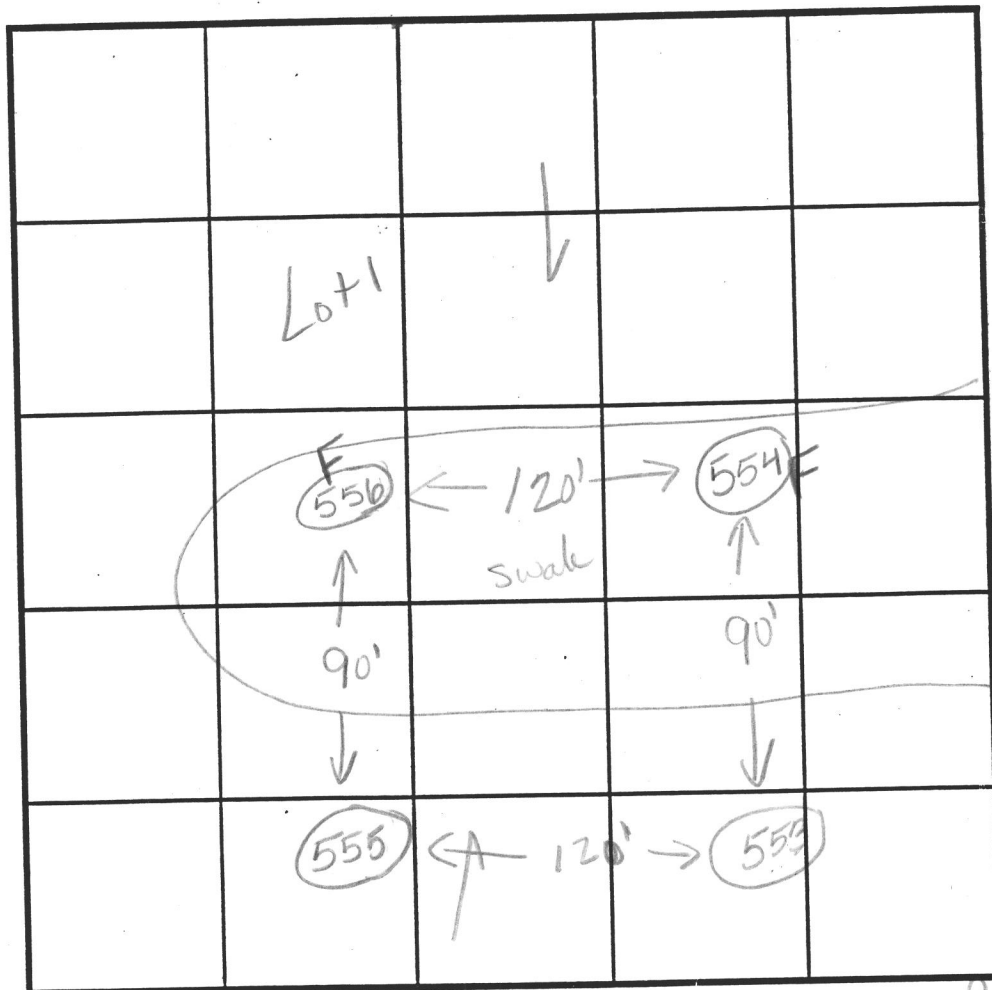

INDICATE NORTH - NAME ADJOINING ROADWAY AS BASE LINE.

Old Roxbury Rd.

SOIL PROFILE

0'

555

orange
brown
clay loam

5.0'

brown/
orange
SCLM
manganese
oxide
15%
rock
frags

11.5'

DATE	TEST NO.	DEPTH	PRE-WET		TEST - 1" DROP		TIME
			START	STOP	START	STOP	
6.3.98	554	FAILED DUE TO WATER					F
		(WATER AT 4.0' AT 4:30)					
	553	4.0'S	11:54 ₂₀	11:56	11:56	11:59	3min
		11.0'D	Visual	ok - see profile			
	556	4.0'D	FAILED	DUE TO ROCK + H ₂ O			F
	555	5.5'S	12:17 ₅₀	12:22	12:22	12:34	12min
		11.5'D	Visual	ok - see profile			

REMARKS test holes staked by surveyor

TYPE OF SOIL Manor

TESTED BY Kim Maisie

ALSO PRESENT Mike + Sam

TRENCH DESIGN DATA: AVERAGE PERCOLATION TIME TRENCH WIDTH

INLET DEPTH MAXIMUM BOTTOM DEPTH SQ. FT/BEDROOM

APPLICATION

PERCOLATION TESTING

A NO FEE

P _____

HOWARD COUNTY HEALTH DEPARTMENT
BUREAU OF ENVIRONMENTAL HEALTH
3525-H ELLICOTT MILLS DRIVE/ELLICOTT CITY, MARYLAND 21043
TELEPHONE: 313-2640

DISTRICT _____

DATE 5/30/02

TO: THE COUNTY HEALTH OFFICER
ELLICOTT CITY, MARYLAND

I HEREBY APPLY FOR THE NECESSARY TEST PRIOR TO APPLICATION FOR PERMIT TO CONSTRUCT (OR RECONSTRUCT) A SEWAGE DISPOSAL SYSTEM.

PROPERTY OWNER _____

ADDRESS _____ PHONE _____

AGENT OR PROSPECTIVE BUYER _____

ADDRESS _____ PHONE _____

PROPERTY LOCATION:

SUBDIVISION Buice Sec 1 LOT NO. 3

ROAD AND DESCRIPTION _____

TAX MAP _____ PARCEL # _____

SIZE OF LOT _____ TYPE BLDG. _____
(SINGLE FAMILY DWELLING OR COMMERCIAL)

THE SYSTEM INSTALLED UNDER THIS APPLICATION IS ACCEPTABLE ONLY UNTIL PUBLIC FACILITIES BECOME AVAILABLE. I FULLY UNDERSTAND THE
FEE CONNECTED WITH THE FILING OF THIS PERC TEST APPLICATION IS NON-REFUNDABLE UNDER ANY CIRCUMSTANCES. I ALSO AGREE TO
COMPLY WITH ALL M.O.S.H.A. REQUIREMENTS IN TESTING THIS LOT. _____
(SIGNATURE OF APPLICANT)

APPROVED BY _____ FOR _____ DATE _____

DISAPPROVED BY _____ FOR _____ DATE _____

HOLD PENDING FURTHER TESTS _____

REASONS FOR REJECTION OR HOLDING _____

PERCOLATION TEST PLAT/PRELIMINARY PLAT - TITLE OR I.D. # _____ DATE _____


SITE DEVELOPMENT PLAN/FINAL PLAT - TITLE OR I.D. # _____ DATE _____

THIS IS NOT A PERMIT


NOT TO SCALE

COUNTY #



SOIL PROFILE

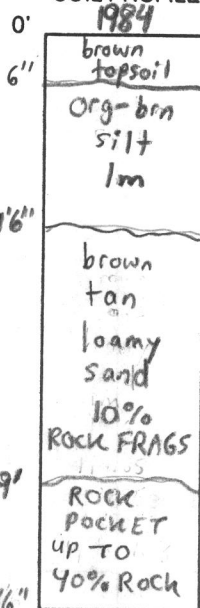

1985

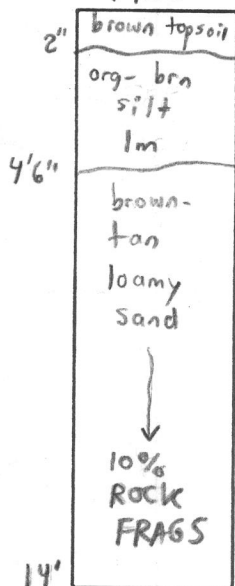


1986

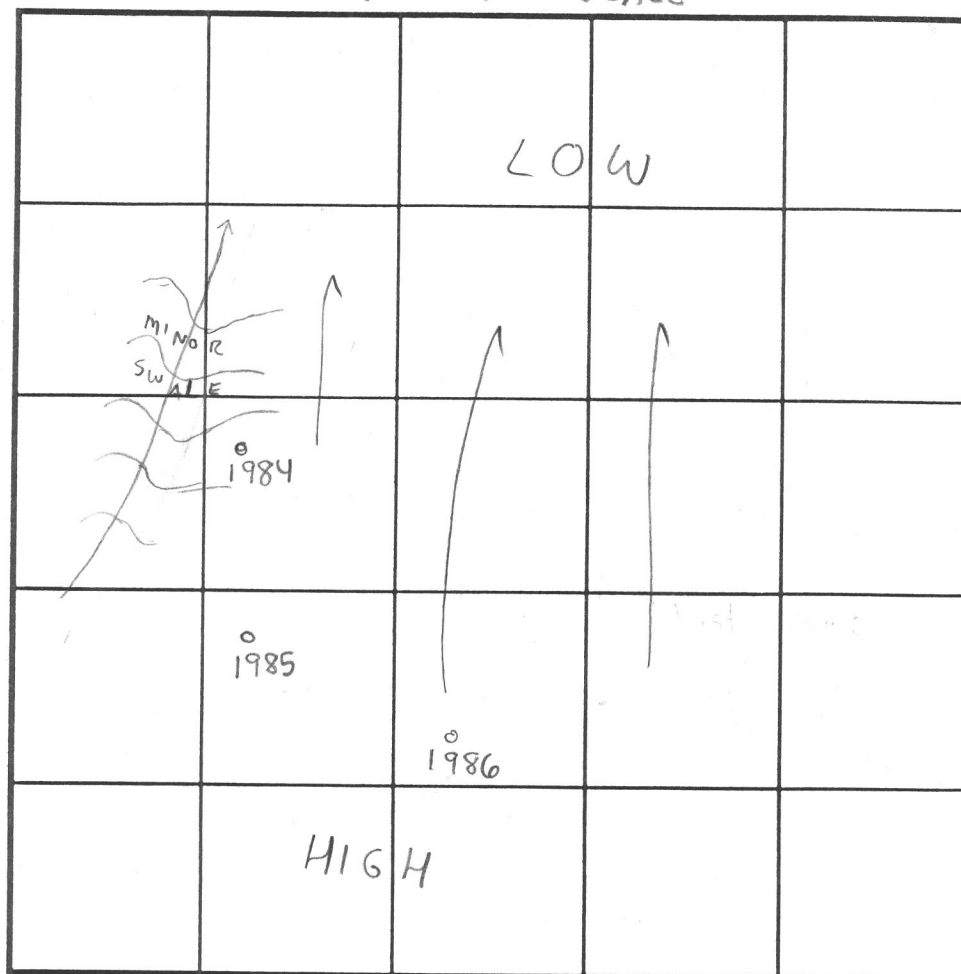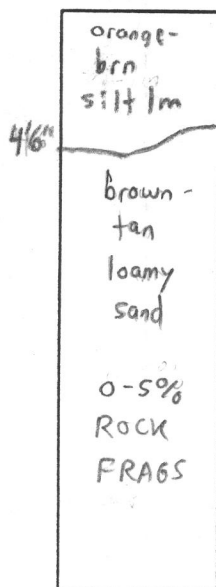

INDICATE NORTH - NAME ADJOINING ROADWAY AS BASE LINE.

SOIL PROFILE

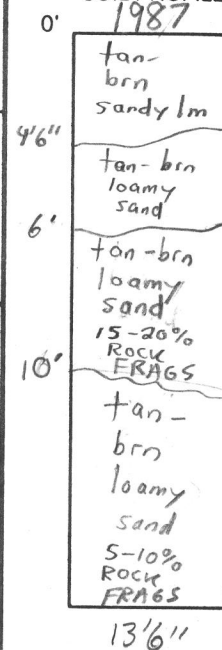

DATE	TEST NO.	DEPTH	PRE-WET		TEST - 1" DROP		TIME	
			START	STOP	START	STOP		
5/30/02	1984	13'6" V	(VISUAL OK SEE SOIL PROFILE)		NA		OK	
	1985	5'6" T 14' V	11:58am	12:01pm	12:01pm	12:08pm	7min	OK
	1986	5' T 13' V	12:12am	12:14am	12:14am	12:19am	5min	OK
	1987	13'6" V	(VISUAL OK SEE SOIL PROFILE)		NA		OK	

REMARKS

TYPE OF SOIL

Manor

TESTED BY

SRK, John Boris & Barry Glotfelty

ALSO PRESENT

John Komsa, Bob Buice
Mike Johnson

TRENCH DESIGN DATA: AVERAGE PERCOLATION TIME

TRENCH WIDTH

INLET DEPTH

MAXIMUM BOTTOM DEPTH

SQ. FT/BEDROOM

13'

APPLICATION

PERCOLATION TESTING

A 59935

P _____

HOWARD COUNTY HEALTH DEPARTMENT

BUREAU OF ENVIRONMENTAL HEALTH

3525-H ELLICOTT MILLS DRIVE/ELLICOTT CITY, MARYLAND 21043
TELEPHONE: 313-2640

DISTRICT _____

DATE 4/13/98

TO: THE COUNTY HEALTH OFFICER
ELLICOTT CITY, MARYLAND

I HEREBY APPLY FOR THE NECESSARY TEST PRIOR TO APPLICATION FOR PERMIT TO CONSTRUCT (OR RECONSTRUCT) A SEWAGE DISPOSAL SYSTEM.

PROPERTY OWNER ROBERT P. BUICE

ADDRESS 7979 MUNCASTER MILL ROAD PHONE 410-975-0200

AGENT OR PROSPECTIVE BUYER DONALD R. REWIER LAND DESIGN & DEV INC.

ADDRESS 10805 HICKORY RIDGE ROAD PHONE 410-740-2100
COLUMBIA, MD 21044

PROPERTY LOCATION:

SUBDIVISION BUICE PROPERTY, Sec 1 LOT NO. 34

ROAD AND DESCRIPTION EAST SIDE OLD ROXBURY ROAD

JUST EAST OF INTERSECTION OF RT 97 & ROXBURY MILL ROAD

TAX MAP 21 PARCEL # 84 GRID 20

SIZE OF LOT ONE ACRE TYPE BLDG. SF D
(SINGLE FAMILY DWELLING OR COMMERCIAL)

THE SYSTEM INSTALLED UNDER THIS APPLICATION IS ACCEPTABLE ONLY UNTIL PUBLIC FACILITIES BECOME AVAILABLE. I FULLY UNDERSTAND THE FEE CONNECTED WITH THE FILING OF THIS PERC TEST APPLICATION IS NON-REFUNDABLE UNDER ANY CIRCUMSTANCES. I ALSO AGREE TO COMPLY WITH ALL M.O.S.H.A. REQUIREMENTS IN TESTING THIS LOT. DONALD R. REWIER JR
(SIGNATURE OF APPLICANT)

APPROVED BY _____ FOR _____ DATE _____

DISAPPROVED BY _____ FOR _____ DATE _____

HOLD PENDING FURTHER TESTS _____

REASONS FOR REJECTION OR HOLDING _____

PERCOLATION TEST PLAT/PRELIMINARY PLAT - TITLE OR I.D. # _____ DATE _____

SITE DEVELOPMENT PLAN/FINAL PLAT - TITLE OR I.D. # _____ DATE _____

THIS IS NOT A PERMIT

59935 C

COUNTY #

SOIL PROFILE

0' 706
orange
brown
cl 1m
2' brown/
burnt
orange
sac 1m
greater
than 50%
rock at
8'

706 A


3' brown/
orange
cl 1m

12' beige/
light
tan
sac 1m
10%
rx
frags

705/704

4.0' orange
cl 1m

10' beige
sac 1m
20%
rock
frags
↓

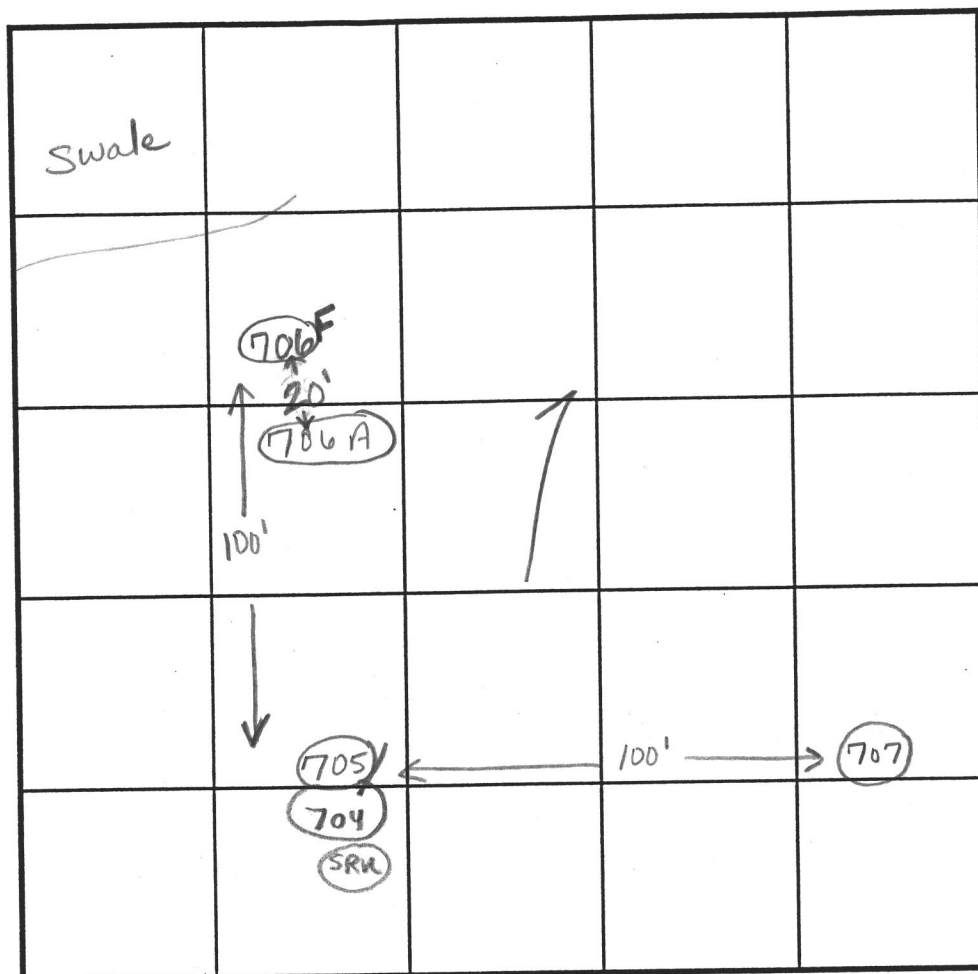

INDICATE NORTH - NAME ADJOINING ROADWAY AS BASE LINE.

SOIL PROFILE

0' 707
orange/
brown
cl 1m
large
rx bldrs
at 1-3'
3' beige/
tan
sac 1m
10%
rock
frags
↓
11'

DATE	TEST NO.	DEPTH	PRE-WET		TEST - 1" DROP		TIME
			START	STOP	START	STOP	
10/29/98	705	4.0'S	11:58	12:15	12:15	SLOW	
	704	10.0'D	visual	ok	see profile		
	(redug) 706	5.0'S	12:54	12:5530	12:5530	12:5830	3
	706	3.0'S	11:2750	11:3030	11:3030	11:39	B30
		11.0'D	FAILED DUE TO ROCK				
	706 A	12.0'D	visual	ok	-see profile		
	707	11.0'D	visual	only	-ok see profile		
		11.0'D					

REMARKS wooded lot

TYPE OF SOIL Manor

TESTED BY Kim Maiste

ALSO PRESENT Sam

TRENCH DESIGN DATA: AVERAGE PERCOLATION TIME 6 min

TRENCH WIDTH


INLET DEPTH

MAXIMUM BOTTOM DEPTH

SQ. FT/BEDROOM

EX DELIVERY TO REMAIN
FOR FARM USE

Part of Parcel 74

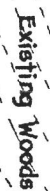

Lot 4.3 Holes


5004	✓	P	—	} INSDA
5003 B	✓	P	—	
704/705	✓	P	—	
706 A	✓	P	—	
SSS	✓	P	—	
706	✓	F		
5003	✓	F		
1984	✓	P	—	} INSDA
1985	✓	P	—	
1986	✓	P	—	
1987	✓	P		


SHALLOW

SYSTEM

ONLY BOTTOM

AT 5' OK

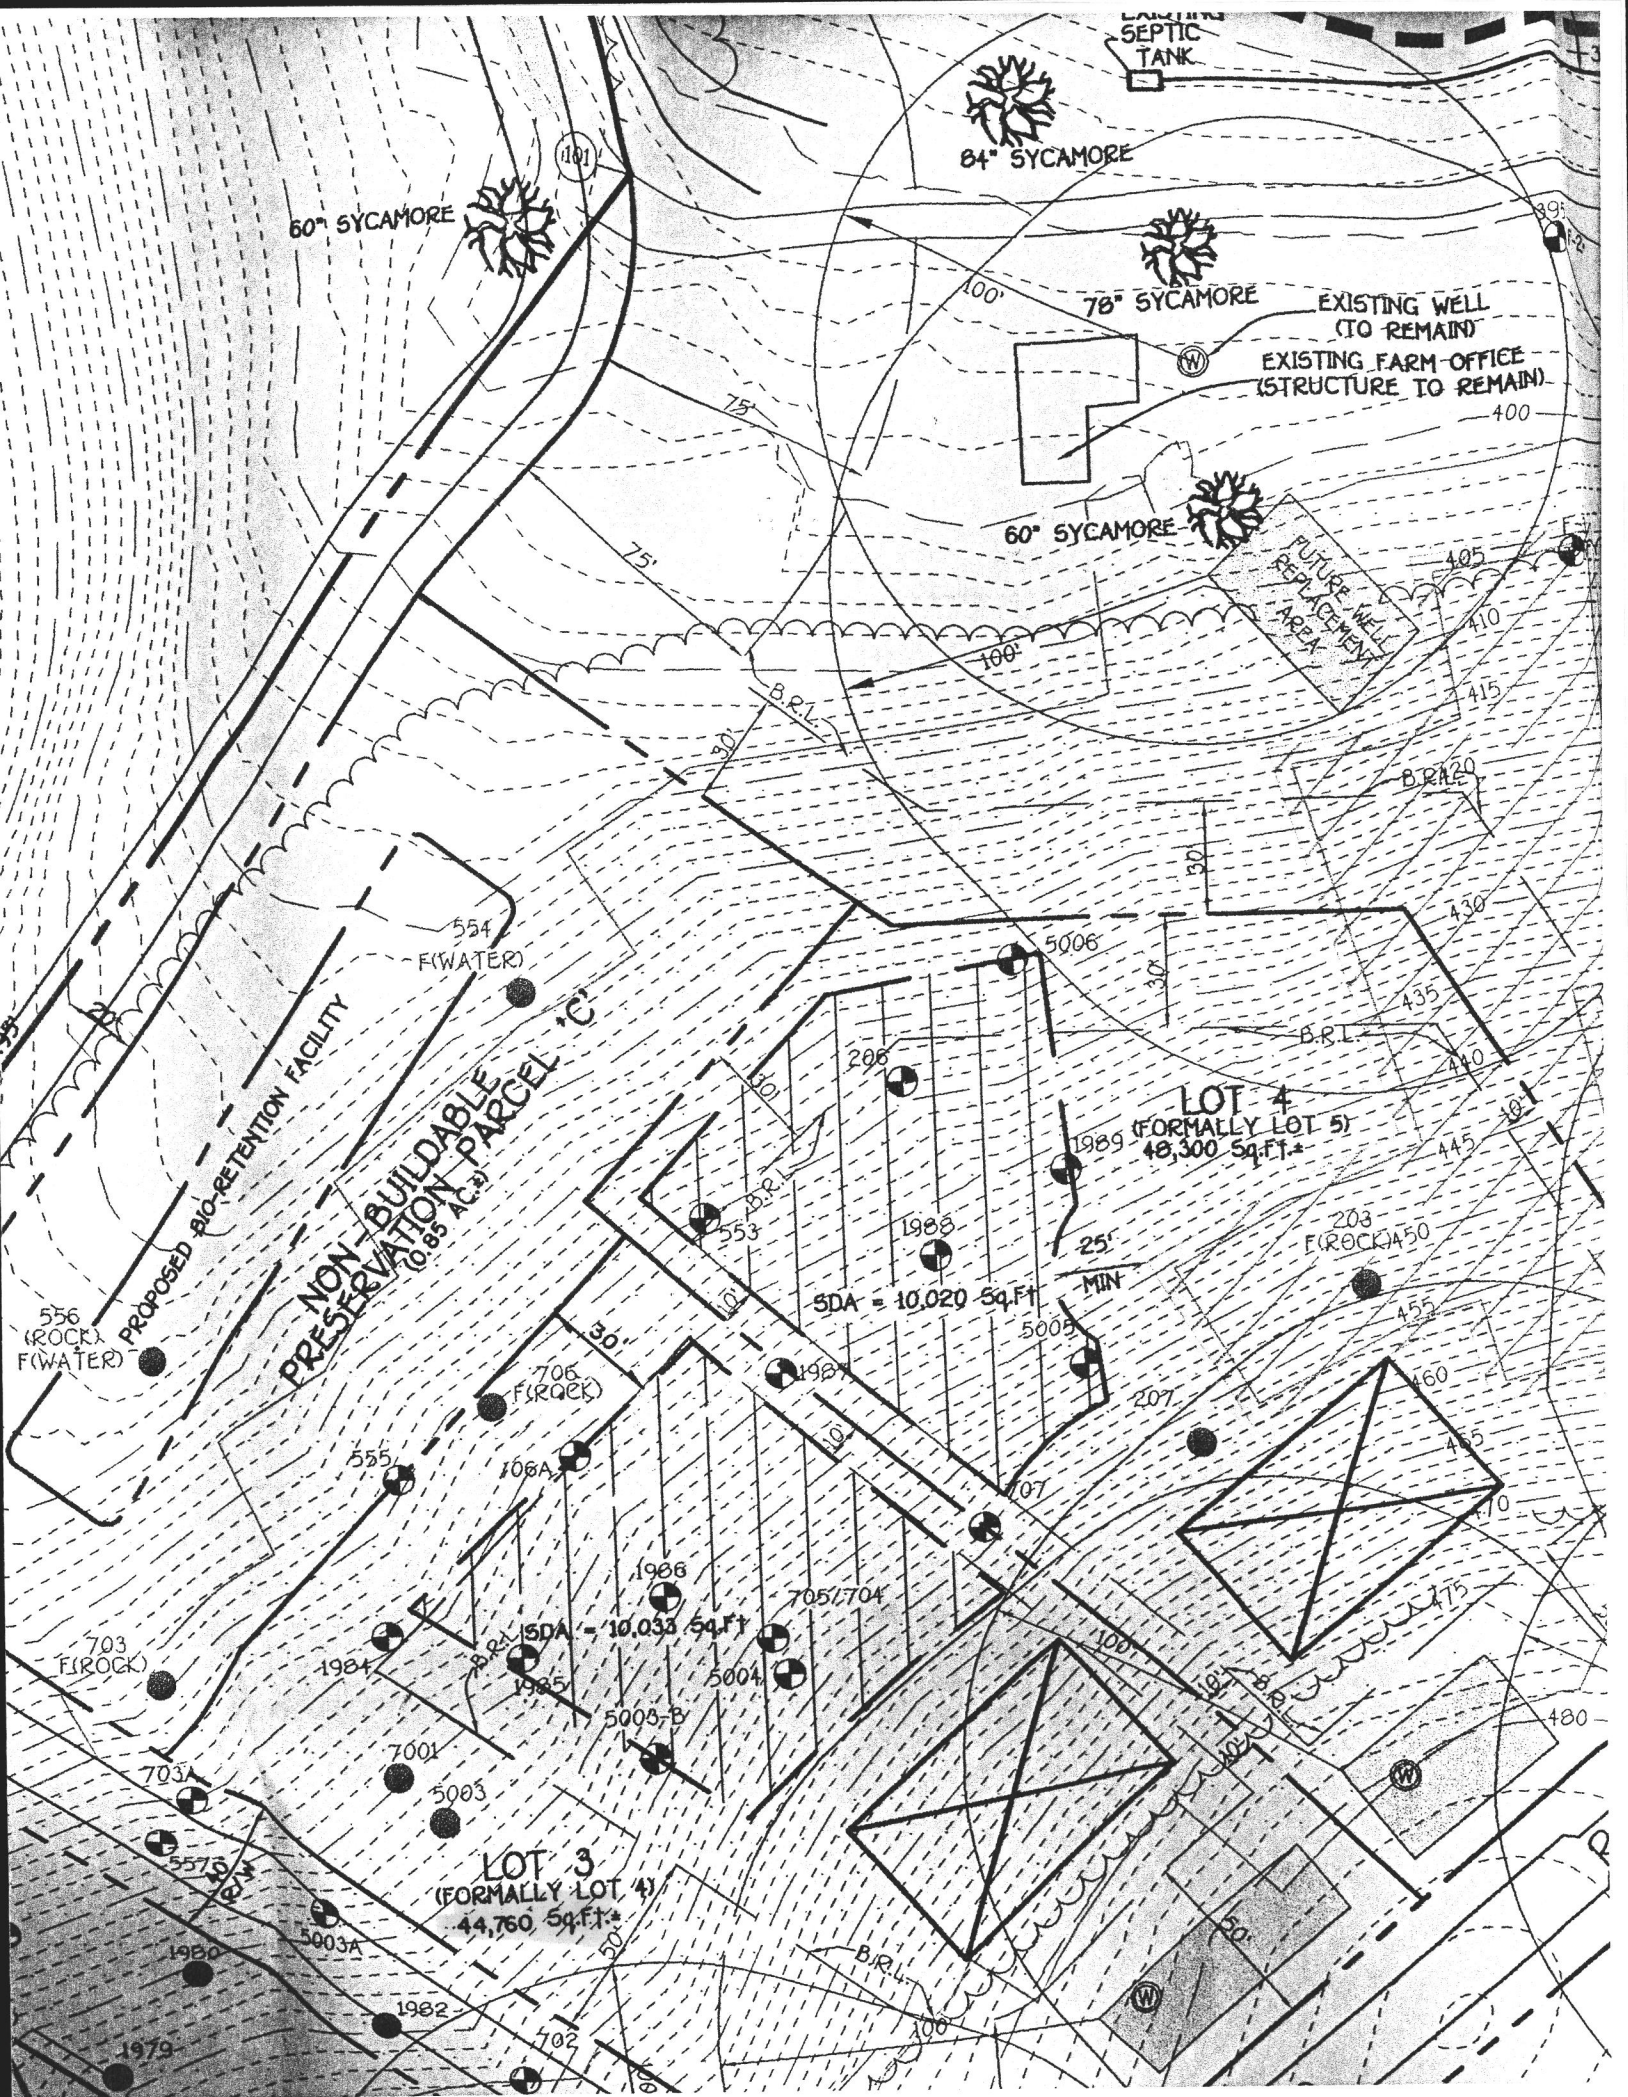

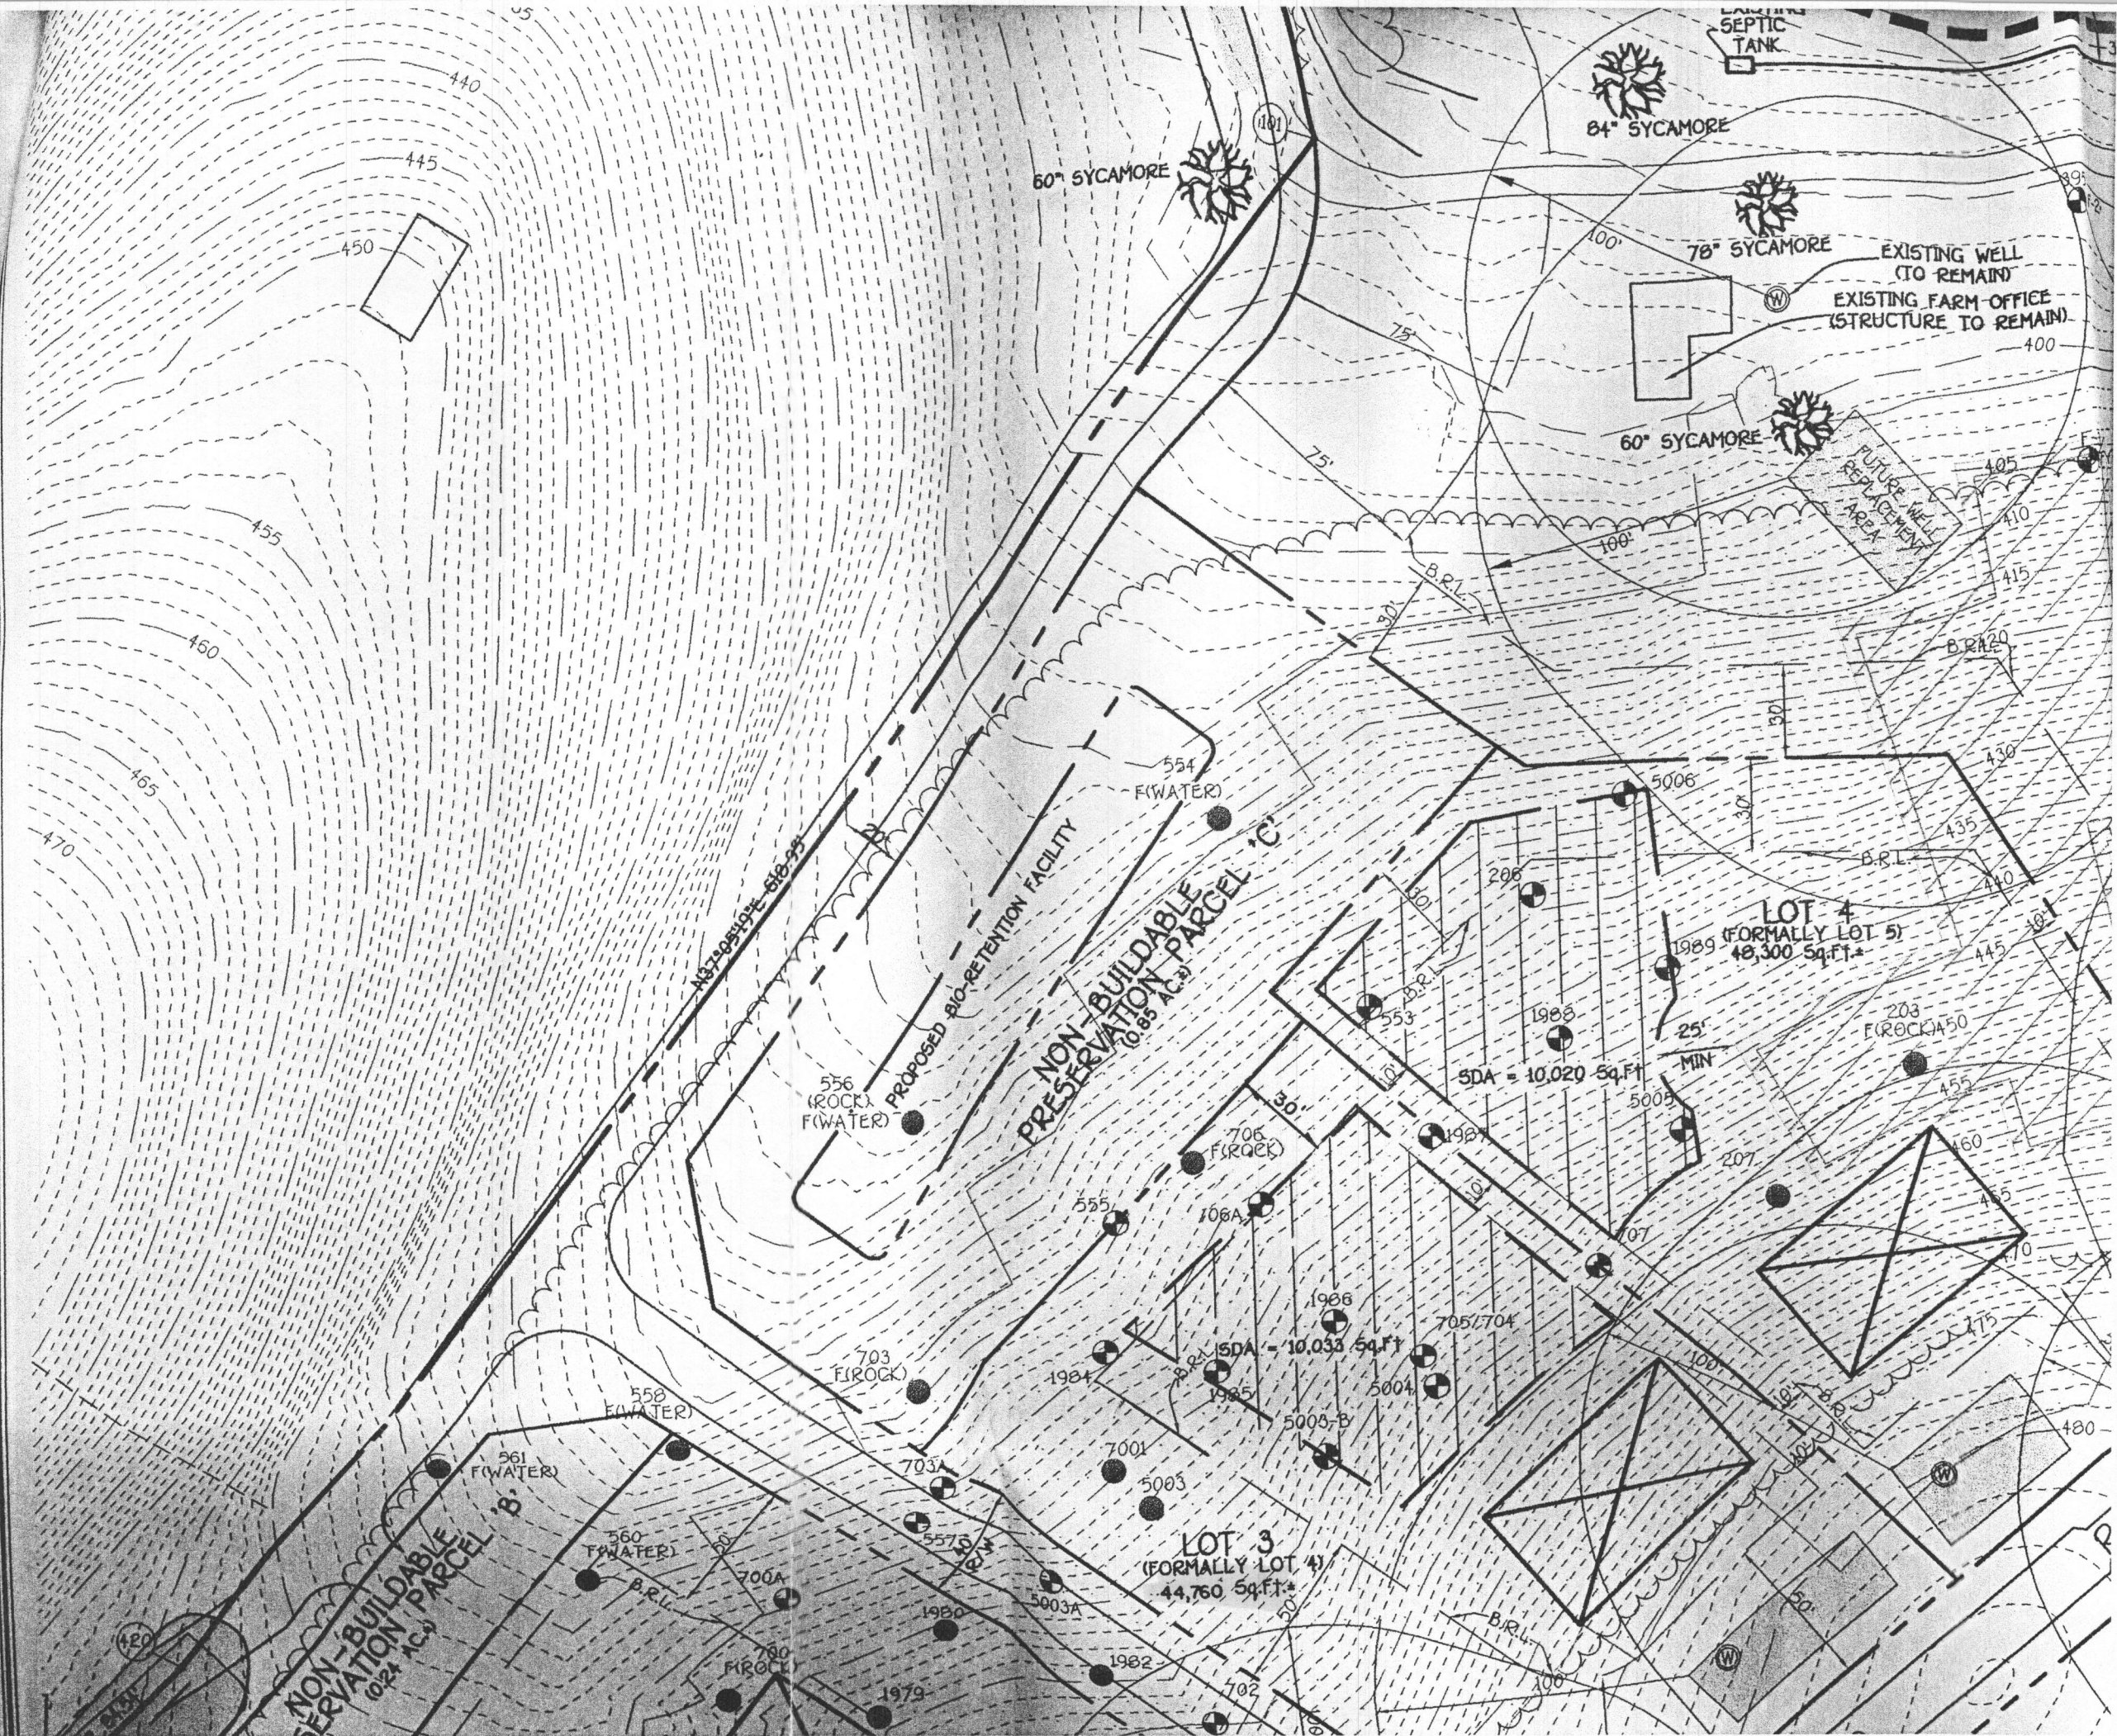

APPLICATION

PERCOLATION TESTING

A _____

P _____

HOWARD COUNTY HEALTH DEPARTMENT

BUREAU OF ENVIRONMENTAL HEALTH

3525-H ELLICOTT MILLS DRIVE/ELLICOTT CITY, MARYLAND 21043
TELEPHONE: 313-2640

DISTRICT _____

DATE _____

TO: THE COUNTY HEALTH OFFICER
ELLICOTT CITY, MARYLAND

I HEREBY APPLY FOR THE NECESSARY TEST PRIOR TO APPLICATION FOR PERMIT TO CONSTRUCT (OR RECONSTRUCT) A SEWAGE DISPOSAL SYSTEM.

PROPERTY OWNER Robert P. Buice

ADDRESS 7979 Muncaster Mill Rd. PHONE 410-975-0200

AGENT OR PROSPECTIVE BUYER Donald Rewver

ADDRESS 10805 Hickory Ridge Rd. PHONE 410-740-2100

PROPERTY LOCATION: Columbia

SUBDIVISION Buice, Sec 1 LOT NO. 242 Pres. Parcel 'A'

ROAD AND DESCRIPTION Old Roxbury Rd

TAX MAP 21 PARCEL # 84 Grid 20

SIZE OF LOT _____ TYPE BLDG. _____
(SINGLE FAMILY DWELLING OR COMMERCIAL)

THE SYSTEM INSTALLED UNDER THIS APPLICATION IS ACCEPTABLE ONLY UNTIL PUBLIC FACILITIES BECOME AVAILABLE. I FULLY UNDERSTAND THE FEE CONNECTED WITH THE FILING OF THIS PERC TEST APPLICATION IS NON-REFUNDABLE UNDER ANY CIRCUMSTANCES. I ALSO AGREE TO COMPLY WITH ALL M.O.S.H.A. REQUIREMENTS IN TESTING THIS LOT. Donald Rewver
(SIGNATURE OF APPLICANT)

APPROVED BY _____ FOR _____ DATE _____

DISAPPROVED BY _____ FOR _____ DATE _____

HOLD PENDING FURTHER TESTS _____

REASONS FOR REJECTION OR HOLDING _____

PERCOLATION TEST PLAT/PRELIMINARY PLAT - TITLE OR I.D. # _____ DATE _____

SITE DEVELOPMENT PLAN/FINAL PLAT - TITLE OR I.D. # _____ DATE _____

THIS IS NOT A PERMIT

COUNTY #

SOIL PROFILE

0'

3'

9'

orange/
tan
cl lm

orange/
beige/
tan
silm
greater
than 50%
rock at 7'

203

orange/
beige
silm
greater
than
50%
rock
↓


45'

201

grey/
orange
sac lm
50%
rock
frags
↓

4'


slope appears to be greater
than 25% in designated
perc area. (km)

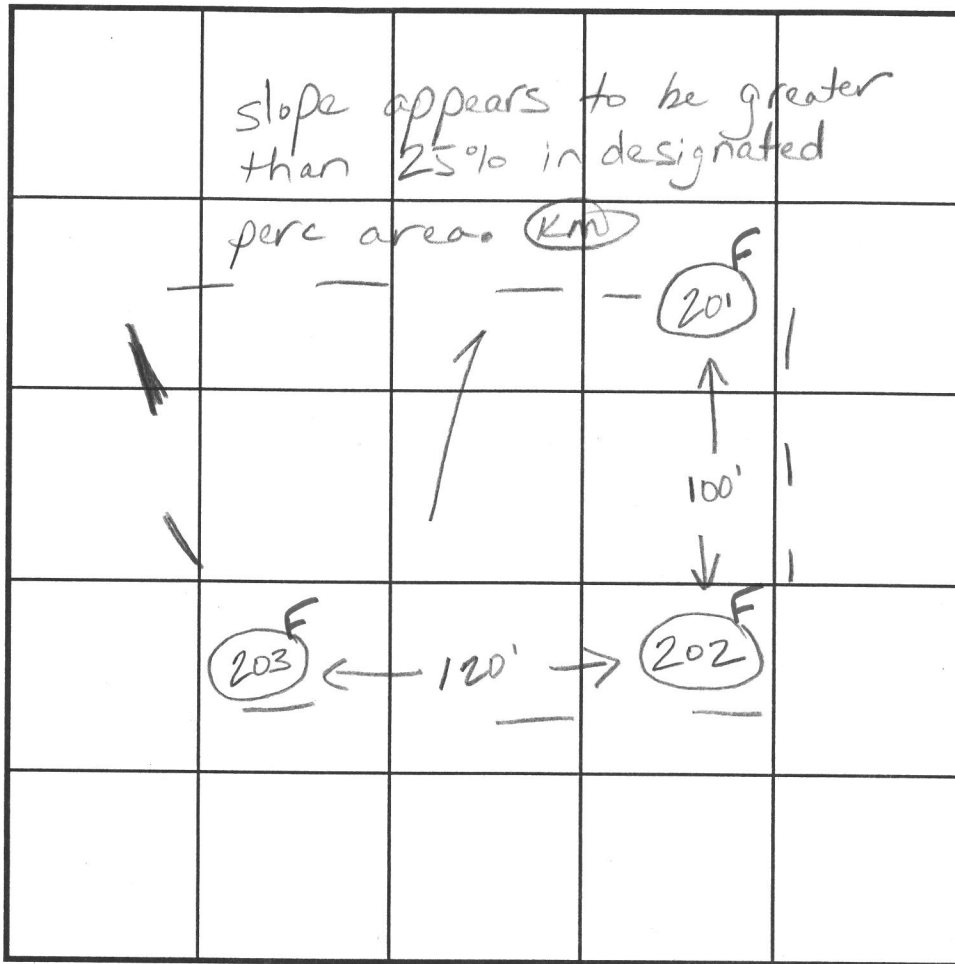

INDICATE NORTH - NAME ADJOINING ROADWAY AS BASE LINE.

SOIL PROFILE

0'

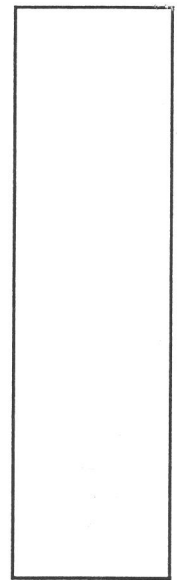

DATE	TEST NO.	DEPTH	PRE-WET		TEST - 1" DROP		TIME
			START	STOP	START	STOP	
2-19-99	201	4.0'D	FAILED	DUE TO	ROCK		F
	202	9.0'D	FAILED	DUE TO	ROCK		F
	203	4.5'D	FAILED	DUE TO	ROCK		F

REMARKS test holes staked (thick woods)

TYPE OF SOIL Manor

TESTED BY Kim Maiste

ALSO PRESENT Mike Johnson

TRENCH DESIGN DATA: AVERAGE PERCOLATION TIME _____ TRENCH WIDTH _____

INLET DEPTH _____ MAXIMUM BOTTOM DEPTH _____ SQ. FT/BEDROOM _____