
WATER WELL ABANDONMENT-SEALING REPORT FORM

SUBMIT COPIES OF COMPLETED FORM TO:

- * COUNTY ENVIRONMENTAL AGENCY (contact MDE, WMA if address needed)
- * WELL OWNER
- * MDE, WATER MANAGEMENT ADMINISTRATION, WELL PROGRAM

APPROVED
10/16/2017
(Signature)

DATE WELL ABANDONED: January 30, 2018 (month/day/year)

* PERMIT NUMBER OF ABANDONED WELL (if any)

HO-95-2487

* PERMIT NUMBER OF REPLACEMENT WELL:

* PERSON ABANDONING WELL: Bruce Thompson


WELL DRILLER'S LICENSE NUMBER:

CIRCLE: MWD / MSD / MGD

* OWNER'S NAME: Howard County DPW

SITE LOCATION MAP

* WELL LOCATION:
COUNTY: Howard
NEAREST TOWN: Glenelg
TAX MAP _____ BLOCK _____ PARCEL _____
SUBDIVISION: _____
SECTION: _____ LOT: _____
STREET ADDRESS: 4301 Route 32

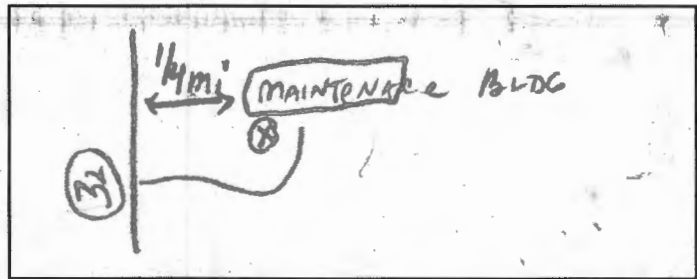

LATITUDE 39.250652

LONGITUDE 76.977651

LOG OF SEALING MATERIAL

* TYPE OF WELL BEING ABANDONED:
 DRILLED _____ JETTED _____
_____ BORED _____ HAND DUG _____
_____ OTHER (specify) _____

MATERIAL	FEET	
	FROM	TO
<u>Bentonite</u>	<u>175</u>	<u>2</u>
<u>Cement</u>	<u>2</u>	<u>0</u>

* USE CODE:
_____ DOMESTIC _____ MUNICIPAL/PUBLIC
_____ IRRIGATION _____ INDUSTRIAL
_____ TEST/OBSERVATION _____ GEOTHERMAL _____

VOLUME OF MATERIAL USED

500# Bentonite as dug - 200# cement

* TYPE OF CASING:
 STEEL _____ PLASTIC _____
_____ CONCRETE _____ OTHER (specify) _____

SIZE OF CASING: 6 INCHES IN DIAMETER

DEPTH OF WELL: 175 FEET DEEP

WAS ANY CASING REMOVED? YES _____ NO _____
If yes, length removed, in feet: 2

WAS CASING RIPPED OR PERFORATED? _____ YES NO

Bruce F. Esterling 040
SIGNATURE-MASTER WELL DRILLER OR SUPERVISING SANITARIAN LICENSE#

MWD MSD / MGS 2-22-18
CIRCLE ONE DATE

COUNTY

Pursuant to § 10-624 of the State Govt. Article of the Maryland Code, personal info requested on this form is used in processing this form pursuant to COMAR 26.04.04. Failure to provide the info may result in this form not being processed. You have the right to inspect, amend, or correct this form. The Maryland Department of the Environment is subject to the Maryland Public Information Act. This form may be made available on the Internet via MDE's website and is subject to inspection or copying, in whole or in part, by the public and other governmental agencies, if not protected by federal or State Law.

Real Property Data Search (w3)

Search Result for HOWARD COUNTY

View Map		View GroundRent Redemption				View GroundRent Registration				
Tax Exempt: None		Special Tax Recapture: None								
Exempt Class: None										
Account Identifier:		District - 05 Account Number - 391687								
Owner Information										
Owner Name:		HOWARD COUNTY MARYLAND DEPT PUBLIC WORKS				Use: Principal Residence:		EXEMPT COMMERCIAL NO		
Mailing Address:		COURT HOUSE DRIVE ELLCOTT CITY MD 21043				Deed Reference:		/01075/ 00270		
Location & Structure Information										
Premises Address:		4300 ROUTE 32 GLENELG 21737-0000				Legal Description:		31.000 A 4300 ROUTE 32 GLENELG		
Map:	Grid:	Parcel:	Neighborhood:	Subdivision:	Section:	Block:	Lot:	Assessment Year:	Plat No:	Plat Ref:
0028	0003	0164	20000.14	0000				2020		
Special Tax Areas: None						Town:		None		
						Ad Valorem:		103		
						Tax Class:		None		
Primary Structure Built		Above Grade Living Area		Finished Basement Area		Property Land Area		County Use		
						31.0000 AC				
Stories	Basement	Type	Exterior	Quality	Full/Half Bath	Garage	Last Notice of Major Improvements			
			/							
Value Information										
		Base Value		Value		Phase-in Assessments				
				As of		As of		As of		
				01/01/2017		07/01/2019		07/01/2020		
Land:		4,092,200		4,092,200						
Improvements		812,300		812,300						
Total:		4,904,500		4,904,500		4,904,500				
Preferential Land:		0								
Transfer Information										
Seller: FLOYD WILLIAM				Date: 10/20/1981				Price: \$115,600		
Type: ARMS LENGTH IMPROVED				Deed1: /01075/ 00270				Deed2:		
Seller:				Date:				Price:		
Type:				Deed1:				Deed2:		
Seller:				Date:				Price:		
Type:				Deed1:				Deed2:		
Exemption Information										
Partial Exempt Assessments:		Class		07/01/2019		07/01/2020				
County:		500		4,904,500.00						
State:		500		4,904,500.00						
Municipal:		500		0.00		0.00				
Tax Exempt: None		Special Tax Recapture: None								
Exempt Class: None										
Homestead Application information										
Homestead Application Status: No Application										
Homeowners' Tax Credit Application Information										