

MARYLAND DEPARTMENT OF THE ENVIRONMENT, WATER MANAGEMENT ADMINISTRATION
1800 Washington Blvd., Baltimore, Maryland 21230 (410) 537-3784

WATER WELL ABANDONMENT-SEALING REPORT FORM

SUBMIT COPIES OF COMPLETED FORM TO:

- * COUNTY ENVIRONMENTAL AGENCY (contact MDE, WMA if address needed)
- * WELL OWNER
- * MDE, WATER MANAGEMENT ADMINISTRATION, WELL PROGRAM

DATE WELL ABANDONED: July 13, 2017 (month/day/year)

* PERMIT NUMBER OF ABANDONED WELL (if any) _____

* PERMIT NUMBER OF REPLACEMENT WELL: _____

* PERSON ABANDONING WELL: Bruce Thompson WELL DRILLER'S LICENSE NUMBER: JSD 038


* OWNER'S NAME: The Dirt Express CIRCLE: MWD / MSD / MGD

* WELL LOCATION:
COUNTY: Howard
NEAREST TOWN: ELKRIDGE
TAX MAP _____ BLOCK _____ PARCEL _____
SUBDIVISION: PATAPSCO STATE PARK
SECTION: _____ LOT: _____
STREET ADDRESS: 6115 RIVER RD

LATITUDE 3 9.226707

LONGITUDE 7 6.729592

SITE LOCATION MAP

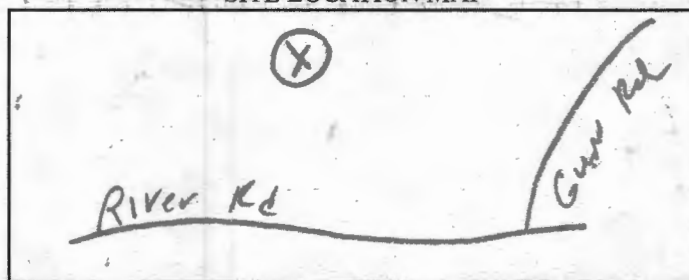

LOG OF SEALING MATERIAL

MATERIAL	FEET	
	FROM	TO
Bentonite	100	2
DIRT	2	0
VOLUME OF MATERIAL USED		
450 # Bentonite As slurry		

* TYPE OF WELL BEING ABANDONED:

☒ DRILLED ☐ JETTED
☐ BORED ☐ HAND DUG
☐ OTHER (specify) _____

* USE CODE:

☒ DOMESTIC ☐ MUNICIPAL/PUBLIC
☐ IRRIGATION ☐ INDUSTRIAL
☐ TEST/OBSERVATION ☐ GEOTHERMAL

* TYPE OF CASING:

☒ STEEL ☐ PLASTIC
☐ CONCRETE ☐ OTHER (specify) _____

SIZE OF CASING: 6 INCHES IN DIAMETER

DEPTH OF WELL: 100 FEET DEEP

WAS ANY CASING REMOVED? ☒ YES ☐ NO

If yes, length removed, in feet: 2

WAS CASING RIPPED OR PERFORATED? ☒ YES ☐ NO

SIGNATURE-MASTER WELL DRILLER OR SUPERVISING SANITARIAN LICENSE#

COUNTY

Pursuant to § 10-624 of the State Govt. Article of the Maryland Code, personal info requested on this form is used in processing this form pursuant to COMAR 26.04.04. Failure to provide the info may result in this form not being processed. You have the right to inspect, amend, or correct this form. The Maryland Department of the Environment is subject to the Maryland Public Information Act. This form may be made available on the Internet via MDE's website and is subject to inspection or copying, in whole or in part, by the public and other governmental agencies, if not protected by federal or State Law.

CIRCLE ONE MSD / MGS

CIRCLE ONE

7-28-17

DATE

Real Property Data Search (w3)

Search Result for HOWARD COUNTY

View Map		View GroundRent Redemption		View GroundRent Registration	
Tax Exempt: None		Special Tax Recapture: None			
Exempt Class: None					
Account Identifier:		District - 01 Account Number - 186485			
Owner Information					
Owner Name:		DEPARTMENT OF FOREST & PARKS ST MD		Use: Principal Residence:	EXEMPT NO
Mailing Address:		ST OFFICE BLDG ANNAPOLIS MD 21404		Deed Reference:	/00520/ 00050
Location & Structure Information					
Premises Address:		ROCKBUN SEC PATAPSCO ELKRIDGE 21075-0000		Legal Description:	204.478 AR ROCKBUN SEC PATAPSCO RIV
Map:	Grid:	Parcel:	Neighborhood:	Subdivision:	Section: Block: Lot: Assessment Year: Plat No: Plat Ref:
0032	0013	0098	1010101.14	0000	2018
Special Tax Areas: None				Town:	None
				Ad Valorem:	103
				Tax Class:	None
Primary Structure Built		Above Grade Living Area		Finished Basement Area	
				Property Land Area 204.4700 AC	
Stories	Basement	Type	Exterior	Quality	Full/Half Bath
			/		
Last Notice of Major Improvements					
Value Information					
		Base Value	Value	Phase-in Assessments	
			As of 01/01/2018	As of 07/01/2019	As of 07/01/2020
Land:		16,102,000	16,102,000		
Improvements		0	0		
Total:		16,102,000	16,102,000	16,102,000	16,102,000
Preferential Land:		0			0
Transfer Information					
Seller:		Date:		Price:	
Type:		Deed1:		Deed2:	
Seller:		Date:		Price:	
Type:		Deed1:		Deed2:	
Seller:		Date:		Price:	
Type:		Deed1:		Deed2:	
Exemption Information					
Partial Exempt Assessments:		Class	07/01/2019	07/01/2020	
County:		220	16,102,000.00	16,102,000.00	
State:		220	16,102,000.00	16,102,000.00	
Municipal:		220	0.00 0.00	0.00 0.00	
Tax Exempt: None		Special Tax Recapture: None			
Exempt Class: None					
Homestead Application Information					
Homestead Application Status: No Application					