

MARYLAND DEPARTMENT OF THE ENVIRONMENT, WATER MANAGEMENT ADMINISTRATION

1800 Washington Blvd., Baltimore, Maryland 21230 (410) 537-3784

WATER WELL ABANDONMENT-SEALING REPORT FORM

SUBMIT COPIES OF COMPLETED FORM TO:

- * COUNTY ENVIRONMENTAL AGENCY (contact MDE, WMA if address needed)
- * WELL OWNER
- * MDE, WATER MANAGEMENT ADMINISTRATION, WELL PROGRAM

DATE WELL ABANDONED: 10/6/2017 (month/day/year)

* PERMIT NUMBER OF ABANDONED WELL (if any) _____

* PERMIT NUMBER OF REPLACEMENT WELL: _____

* PERSON ABANDONING WELL: Michael Isam WELL DRILLER'S LICENSE NUMBER: 162

CIRCLE: MWD / MSD / MGD

* OWNER'S NAME: Thomas Kuckuda

* WELL LOCATION:

COUNTY: Howard

NEAREST TOWN: Laurel

TAX MAP 50 BLOCK 1 PARCEL 361

SUBDIVISION: _____


SECTION: _____ LOT: _____

STREET ADDRESS: 9130 Riverhill Road

LATITUDE 39.11592

LONGITUDE 76.87038

SITE LOCATION MAP

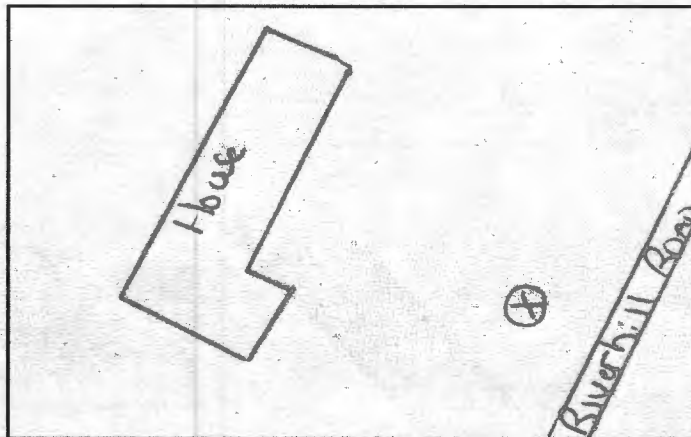

* TYPE OF WELL BEING ABANDONED:

DRILLED JETTED
BORED HAND DUG
OTHER (specify) _____

* USE CODE:

DOMESTIC MUNICIPAL/PUBLIC
IRRIGATION INDUSTRIAL
TEST/OBSERVATION GEOTHERMAL

* TYPE OF CASING:

STEEL PLASTIC
CONCRETE OTHER (specify) _____

SIZE OF CASING: 6 INCHES IN DIAMETER

DEPTH OF WELL: 200 FEET DEEP

WAS ANY CASING REMOVED? YES NO

If yes, length removed, in feet: _____

WAS CASING RIPPED OR PERFORATED? YES NO

LOG OF SEALING MATERIAL

MATERIAL	FEET	
	FROM	TO
Cement Grout	200	0
VOLUME OF MATERIAL USED		
3600 lbs Cement Grout		

SIGNATURE-MASTER WELL DRILLER OR SUPERVISING SANITARIAN LICENSE# 162

MWD / MSD / MGS
 CIRCLE ONE

10/6/17 DATE

COUNTY