

MARYLAND DEPARTMENT OF THE ENVIRONMENT, WATER MANAGEMENT ADMINISTRATION
1800 Washington Blvd., Baltimore, Maryland 21230 (410) 537-3784

WATER WELL ABANDONMENT-SEALING REPORT FORM

SUBMIT COPIES OF COMPLETED FORM TO:

- * COUNTY ENVIRONMENTAL AGENCY (contact MDE, WMA if address needed)
- * WELL OWNER
- * MDE, WATER MANAGEMENT ADMINISTRATION, WELL PROGRAM

DATE WELL ABANDONED: 8/28/17 (month/day/year)

* PERMIT NUMBER OF ABANDONED WELL (if any)

* PERMIT NUMBER OF REPLACEMENT WELL:

* PERSON ABANDONING WELL: Michael Barlow WELL DRILLER'S LICENSE NUMBER: 355

* OWNER'S NAME: Land Design + Development

CIRCLE: MWD / MSD / MGD

* WELL LOCATION:

COUNTY: Howard

NEAREST TOWN: Lavel

TAX MAP 50 BLOCK 1 PARCEL 359

SUBDIVISION:


SECTION: LOT:

STREET ADDRESS: 9147 River Hill Rd

LATITUDE 39.11592

LONGITUDE 76.86864

SITE LOCATION MAP

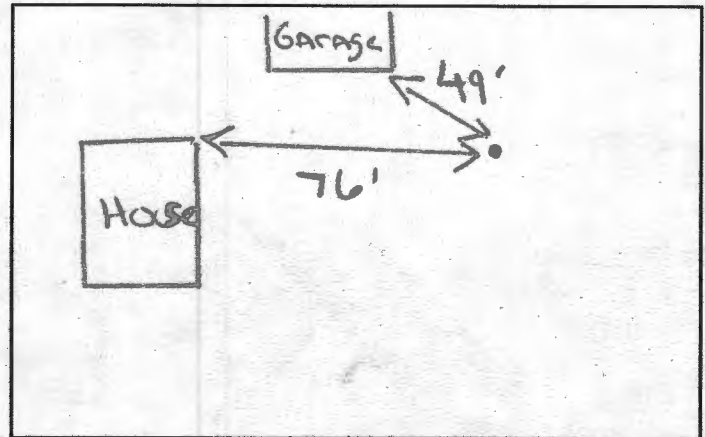

* TYPE OF WELL BEING ABANDONED:

DRILLED JETTED
BORED HAND DUG
OTHER (specify)

* USE CODE:

DOMESTIC MUNICIPAL/PUBLIC
IRRIGATION INDUSTRIAL
TEST/OBSERVATION GEOTHERMAL

* TYPE OF CASING:

STEEL PLASTIC
CONCRETE OTHER (specify)

SIZE OF CASING: 6 INCHES IN DIAMETER

DEPTH OF WELL: 220 FEET DEEP

WAS ANY CASING REMOVED? YES NO

If yes, length removed, in feet:

WAS CASING RIPPED OR PERFORATED? YES NO

SIGNATURE-MASTER WELL DRILLER OR SUPERVISING SANITARIAN 355 LICENSE#

CIRCLE ONE MWD / MSD / MGS

DATE 8/29/17

COUNTY

LOG OF SEALING MATERIAL

MATERIAL	FEET	
	FROM	TO
Cement Grout	220	0
VOLUME OF MATERIAL USED		
3750 lbs Cement Grout		

Real Property Data Search (w4)

Search Result for HOWARD COUNTY

View Map		View GroundRent Redemption				View GroundRent Registration			
Tax Exempt: None		Special Tax Recapture: None							
Exempt Class: None									
Account Identifier:		District - 06 Account Number - 542379							
Owner Information									
Owner Name:		ASHBY DAVID F ASHBY TERRIE M				Use: Principal Residence:		RESIDENTIAL YES	
Mailing Address:		9147 RIVER HILL RD LAUREL MD 20723-				Deed Reference:		/02252/ 00284	
Location & Structure Information									
Premises Address:		9147 RIVER HILL RD LAUREL 20723-0000				Legal Description:		LOT 21 32,670 SQ 9147 RIVER HILL RD HONEYSUCKLE RIDGE	
Map:	Grid:	Parcel:	Neighborhood:	Subdivision:	Section:	Block:	Lot:	Assessment Year:	Plat No: Plat Ref:
0050	0001	0474	6020202.14	2002			21	2020	10769
Special Tax Areas: None						Town:		None	
						Ad Valorem:		104	
						Tax Class:		None	
Primary Structure Built		Above Grade Living Area		Finished Basement Area		Property Land Area		County Use	
1996		2,508 SF				32,670 SF			
Stories	Basement	Type	Exterior	Quality	Full/Half Bath	Garage	Last Notice of Major Improvements		
2	YES	STANDARD UNIT	SIDING/ FRAME	4	2 full/ 1 half	1Att/1Det			
Value Information									
		Base Value		Value		Phase-in Assessments			
				As of		As of		As of	
				01/01/2017		07/01/2019		07/01/2020	
Land:		126,200		126,200					
Improvements		316,000		316,000					
Total:		442,200		442,200		442,200			
Preferential Land:		0							
Transfer Information									
Seller:		Date:				Price: \$0			
Type:		Deed1: /02252/ 00284				Deed2:			
Seller:		Date:				Price:			
Type:		Deed1:				Deed2:			
Seller:		Date:				Price:			
Type:		Deed1:				Deed2:			
Exemption Information									
Partial Exempt Assessments:		Class		07/01/2019		07/01/2020			
County:		000		0.00					
State:		000		0.00					
Municipal:		000		0.00		0.00			
Tax Exempt: None		Special Tax Recapture: None							
Exempt Class: None									
Homestead Application Information									
Homestead Application Status: Approved 03/09/2018									
Homeowners' Tax Credit Application Information									