

City Health Dept.
P. O. Box 476
Ellicott City, Maryland 21043

APPLICATION

A 18619

SEWAGE DISPOSAL TESTING

P _____

STATE OF MARYLAND - DEPARTMENT OF HEALTH AND MENTAL HYGIENE

HOWARD COUNTY HEALTH DEPARTMENT
ENVIRONMENTAL HEALTH SERVICES

DISTRICT 3rd

P. O. BOX 476, ELLICOTT CITY, MARYLAND 21043
TELEPHONE: 465-5000, EXT. 356

DATE June 22, 1973

TO: THE COUNTY HEALTH OFFICER
ELLICOTT CITY, MARYLAND

I, HEREBY, APPLY FOR THE NECESSARY TEST IN ORDER TO CONSTRUCT (OR RECONSTRUCT) A SEWAGE DISPOSAL SYSTEM.

PROPERTY OWNER Irwin L. Chatlin

ADDRESS 13850 River Mill Rd. PHONE _____

PROPERTY LOCATION Glenely, Md. 21227 644-7031
(Baltimore)

SUBDIVISION _____ LOT NO. _____

ROAD AND DESCRIPTION River Mill Rd. off Pfefferkorn Rd. off Rt 144
(house on left side)

SIZE OF LOT 1 acre or less TYPE BLDG. 3

IF NOT SINGLE RESIDENCE DESCRIBE _____ NUMBER OF BEDROOMS _____

THE SYSTEM INSTALLED UNDER THIS APPLICATION IS ACCEPTABLE ONLY UNTIL PUBLIC FACILITIES BECOME AVAILABLE.

SIGNATURE OF APPLICANT Irwin L. Chatlin

APPROVED BY _____ FOR _____ DATE _____

(KIND OF SYSTEM)

REJECTED BY _____ FOR _____ DATE _____

(KIND OF SYSTEM)

HOLD PENDING FURTHER TESTS _____ DATE _____

REASONS FOR REJECTION OR HOLDING _____

THIS IS NOT A PERMIT

Howard County Health Dept. - Sanitation

APPLICATION

A 18619

P _____

SEWAGE DISPOSAL TESTING

STATE OF MARYLAND - DEPARTMENT OF HEALTH AND MENTAL HYGIENE

HOWARD COUNTY HEALTH DEPARTMENT
ENVIRONMENTAL HEALTH SERVICES
P. O. BOX 476, ELLICOTT CITY, MARYLAND 21043
TELEPHONE: 463-5000, EXT. 336

DISTRICT 3rd
DATE June 27, 1973

TO: THE COUNTY HEALTH OFFICER
ELLICOTT CITY, MARYLAND

I, HEREBY, APPLY FOR THE NECESSARY TEST IN ORDER TO CONSTRUCT (OR RECONSTRUCT) A SEWAGE DISPOSAL SYSTEM.

PROPERTY OWNER Irwin L. Chatlin

ADDRESS 13850 Lower Mill Rd. PHONE 644-7031

PROPERTY LOCATION: Glenn, Md. 21727 (Baltimore)

SUBDIVISION _____ LOT NO. ✓

ROAD AND DESCRIPTION directions: Lower Mill Rd. off Pfefferkorn Rd. off Hwy 4
(house on left side) (Don Young property)

SIZE OF LOT 1 acre of 8 acres TYPE BLDG. 3

NUMBER OF BEDROOMS

IF NOT SINGLE RESIDENCE DESCRIBE _____

THE SYSTEM INSTALLED UNDER THIS APPLICATION IS ACCEPTABLE ONLY UNTIL PUBLIC FACILITIES BECOME AVAILABLE.

SIGNATURE OF APPLICANT Irwin L. Chatlin

APPROVED BY _____ FOR _____ DATE _____

(KIND OF SYSTEM)


REJECTED BY _____ FOR _____ DATE _____

(KIND OF SYSTEM)

HOLD PENDING FURTHER TESTS _____ DATE _____

REASONS FOR REJECTION OR HOLDING _____

THIS IS NOT A PERMIT

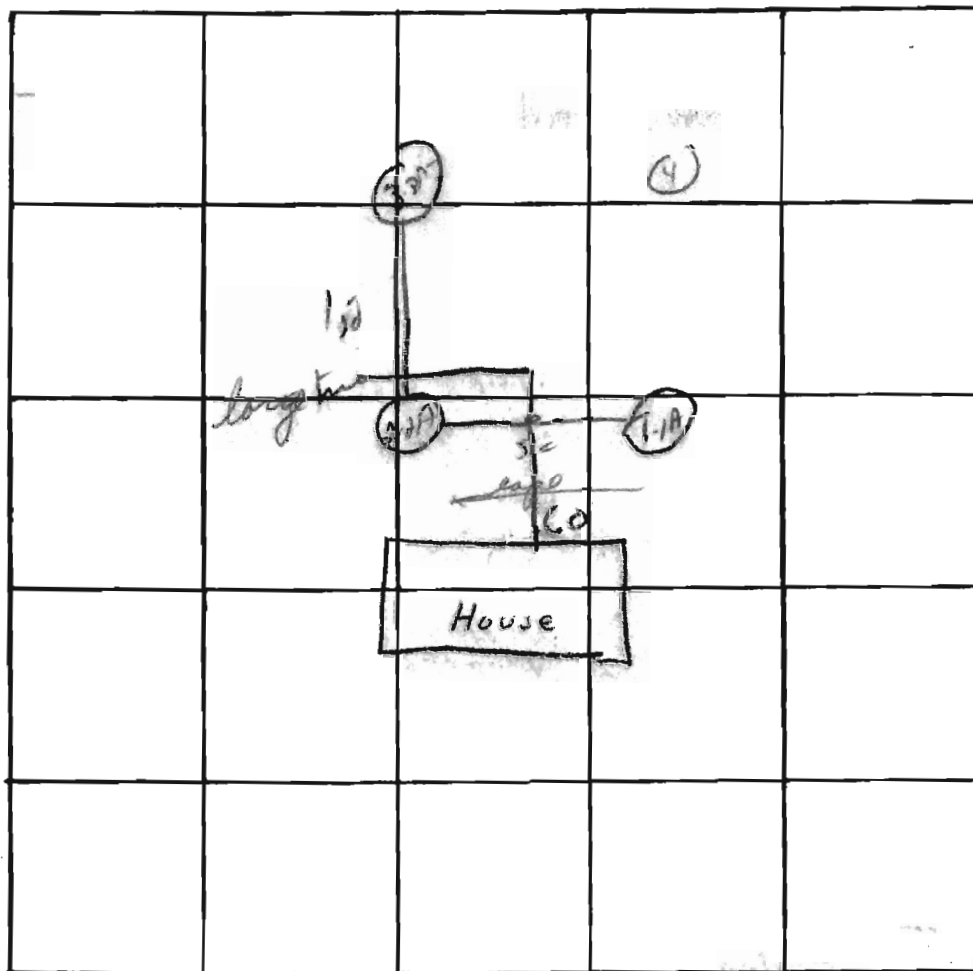

INDICATE NORTH. - NAME ADJOINING ROADWAY AS BASE LINE

DATE	TEST NO.	DEPTH	PRE-WET		TEST - 1" DROP		TIME
			START	STOP	START	STOP	
7/30/0	1	4 1/2'	9 52	9 56	9 56	10 02	6 min
	1A	11'	good soil				
	2	11'	9 53	10 02	10 00	10 12	12 min
	2A	4'	same soil				
	3	4'	10 03	10 04	10 04	10 06	2 min
	3A	11'	10 04	10 07	10 07		
	4	100' soil					

REMARKS _____

TYPE OF SOIL _____

Irwin Chatler



I hereby certify that the plan shown hereon is correct, and that corners are in place as shown

Elwood L. Renn
ELWOOD L. RENN
R.L.S. MD. #3383



Parcel 6-A
Being part of Parcel 6 in division of the Pfefferkorn property and described as follows:
Beginning for the same at a point in the center of Rover Mill Road at the end of the third line of Parcel 6 and running thence with outlines of said Parcel and leaving said road S 27° 46' 30" W 340.45 feet thence, S 59° 41' 30" E 249.00 feet then, with part of the sixth line S 24° 20' 50" W 200.0 feet thence, crossing said Parcel 6 to include a part thereof N 66° 55' 36" W 752.43 feet to a point in Old Rover Road at the end of 282.96 feet on the eleventh line of said Parcel 6 thence with said road N 17° 24' 10" E 527.04 feet to a point thence, S 79° 21' 00" E 330.00 feet to a point thence, S 25° 00' W 30.00 feet to the centerline of Rover Mill Road then with road S 68° 01' 24" E 268.63 feet to place of beginning, containing 8.2738 acres of land.