

APPLICATION

PERCOLATION TESTING

A 58471E

P _____

HOWARD COUNTY HEALTH DEPARTMENT
BUREAU OF ENVIRONMENTAL HEALTH
P.O. BOX 476 ELLICOTT CITY, MARYLAND 21043
TELEPHONE 461-9933

DISTRICT 4

DATE 5/19/97

TO: THE COUNTY HEALTH OFFICER
ELLICOTT CITY, MARYLAND

I, HEREBY, APPLY FOR THE NECESSARY TEST IN ORDER TO CONSTRUCT (OR RECONSTRUCT) A SEWAGE DISPOSAL SYSTEM.

PROPERTY OWNER IRWIN CHATLIN AND GERALDINE B. AZEK

ADDRESS 221 WASHINGTON STREET 21613 PHONE (410) 228-4446

PROSPECTIVE BUYER CFCL PARTNERSHIP

ADDRESS P.O. Box 1371 ELLICOTT CITY, MD. 21041 PHONE (410) 442-5613

PROPERTY LOCATION:

SUBDIVISION CHATLIN PROPERTY LOT NO. # 3 Sec II

ROAD AND DESCRIPTION SOUTH SIDE ROVER MILL ROAD 850' WEST OF PFEFFERKORN RD.
(13487 Rover Mill Road)

TAX MAP 15 PARCEL # 180 + 181

SIZE OF LOT 46,513 SQ. FT. ± TYPE BLDG SINGLE FAMILY DWELLING
(SINGLE FAMILY DWELLING OR COMMERCIAL)

BLDG. PERMIT SIGNED

AND RETURNED 3-17-99

Serial # BRO 116542

4600

SINGLE FAMILY DWELLING

THE SYSTEM INSTALLED UNDER THIS APPLICATION IS ACCEPTABLE ONLY UNTIL PUBLIC FACILITIES BECOME AVAILABLE. I FULLY UNDERSTAND THE FEE CONNECTED WITH THE FILING OF THIS PERC TEST APPLICATION IS NON-REFUNDABLE UNDER ANY CIRCUMSTANCES. I ALSO AGREE TO COMPLY WITH ALL M.O.S.H.A. REQUIREMENTS IN TESTING THIS LOT.

Donald S. O'Neil
(SIGNATURE OF APPLICANT)

APPROVED BY _____ FOR _____ DATE _____

REJECTED BY _____ FOR _____ DATE _____

HOLD PENDING FURTHER TESTS _____ DATE _____

REASONS FOR REJECTION OR HOLDING _____

BLDG. PERMIT SIGNED

AND RETURNED 3-17-99

Serial # BRO 116542

5100-412

THIS IS NOT A PERMIT

SOIL PROFILE

Orange/
brown
clay
loam

tan/or
orange
silty lm
10-15%
shale
frags

3.5'

12.0'

⑥

red/or
cl lm

tan/
orange
silty
lm
10%
shale

4.0'

13.0'

④


red/or
clay lm

or/br
silty lm
10% shale

12.0'

9.5'

indeter-
minate
mottles

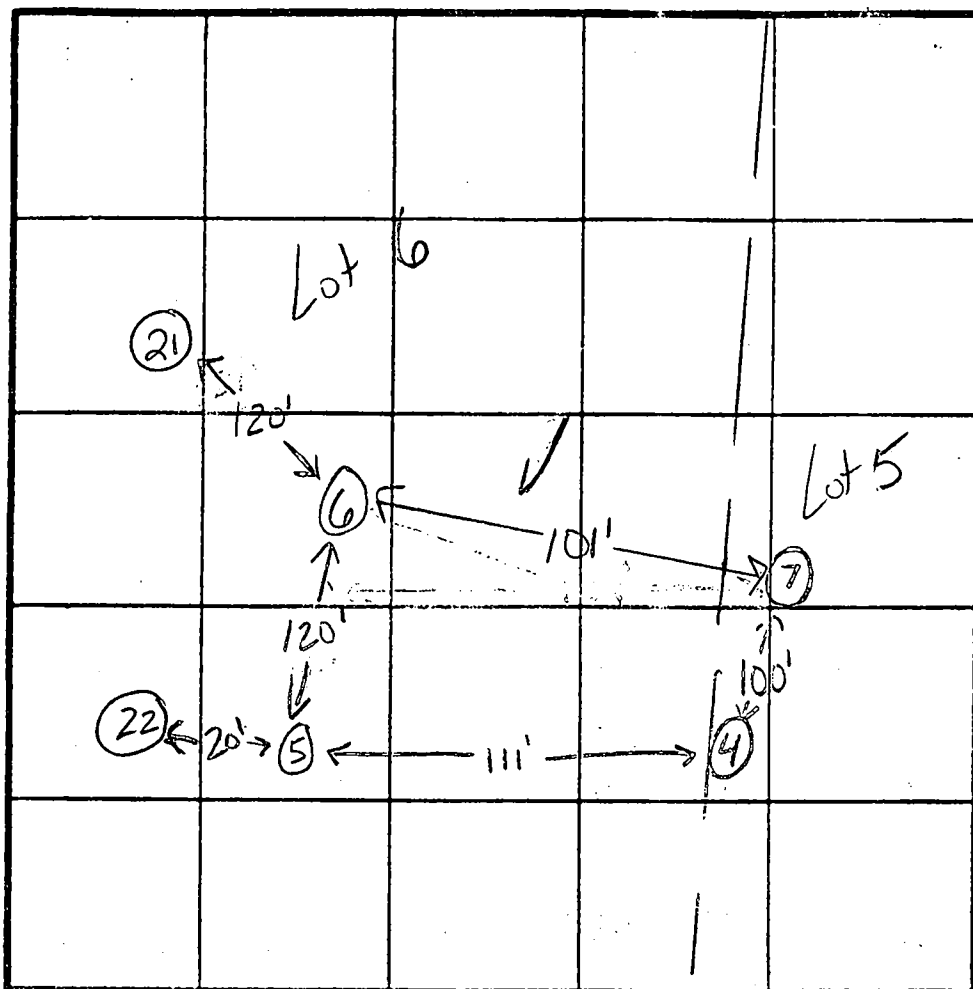

INDICATE NORTH - NAME ADJOINING ROADWAY AS BASE LINE.

Rover Mill Road

or/br
clay lm

4.0'

tan/or
silty
lm

10.0'

indeter-
minate
mottles

13.0'

②①

Same
as
hole
#6

②②

Same
as
hole
#5

DATE	TEST NO.	DEPTH	PRE-WET		TEST - 1' DROP		TIME
			START	STOP	START	STOP	
6-9-97	5	4.5'S	10:46	10:48	10:48	10:50	2min
		12.0'D	visual	ok - see profile			
	6	4.5'S	10:56	10:59 ₃₀	10:59 ₃₀	10:03	3½min
		8.5'S	10:54 ₃₀	10:58	10:58	10:03	5min
		13.0'D	visual	ok - see profile			
	4	5.5'S	10:34	10:36	10:36	10:41	5min
		12.0'D	visual	ok - see profile			
	7	13.0'D	visual	only - ok see profile			
	21	12.0'D	visual	only - ok see profile			
	22	4.0'S	12:55 ₃₀	12:56 ₃₀	12:56 ₃₀	12:58 ₃₀	2min

REMARKS

test holes staked

TYPE OF SOIL

TESTED BY

Kim Maiste / Amy McMillen

ALSO PRESENT

Ron Carter / Olen Ketterman

195

Ba

 MgC_2

M1D2

Ba

MINOR COLLECTOR

EX. 1
WELL

MIE
BUILDABLE
PRESERVATION
PARCEL 'B'
4.756 AC.*

M1D2

~~Mid2~~

APPROX. C
OF EXISTING
SWALE

N89°41'45"W 140°00'