

PERMIT

SEWAGE DISPOSAL SYSTEM

MARYLAND STATE DEPARTMENT OF HEALTH

HOWARD COUNTY
BUREAU OF ENVIRONMENTAL HEALTH
992-2330

03-309371
INDEXED

ELLICOTT CITY

DISTRICT 5th

DATE 9/25/85

A 32984

7-19-83
approved
S. Hall

WP1
OK

Pat Lendrim

IS PERMITTED TO INSTALL X ALTER

ADDRESS 14010 Forsythe Road, Sykesville, Maryland 21784 PHONE 442-2416

SUBDIVISION Donald Berilla ROAD 12556 Folly Quarter LOT 2

PROPERTY OWNER Linda A. Biddison

ADDRESS

IF GARBAGE GRINDER IS USED INCREASE SEPTIC TANK CAPACITY BY 50% AND ABSORPTION AREA BY 22%.

GARBAGE GRINDER? YES NO X

SEPTIC TANK CAPACITY 1000 GALLONS NUMBER OF BEDROOMS 3

TRENCHES - 158 sq. ft. per bedroom. Trench to be 3 feet wide. Inlet 3 feet below original grade. Bottom maximum depth 4½ feet below original grade. Effective area begins at 3 feet below original grade. 1½ feet of stone below distribution pipe. LOCATION: Start first trench 125 feet from back lot line and 40 feet from left lot line, as seen when facing the property from Folly Quarter Road. Run trench(s) along level ground toward right lot line. NOTE: No trench to exceed 100 feet in length. If more than one trench used, a distribution box is required. Call for inspection of trench(s) before gravel is installed. Provide 6" - 8" diameter cleanout and cap to grade or above on septic tank.

BLDG. PERMIT SIGNED

AND RETURNED

WP1 Access 4.5' Below Grade

New Line 5' Below Grade

9/25/85
Serial # BR/02221
replace duck & pipe

PLANS APPROVED BY C. Williams DATE 9/21/83

COVER NO WORK UNTIL INSPECTED AND APPROVED.

NEITHER THE HOWARD COUNTY COUNCIL NOR THE HEALTH DEPARTMENT IS RESPONSIBLE FOR THE SUCCESSFUL OPERATION OF ANY SYSTEM.

NOTE: IF TRENCH IS USED CALL FOR INSPECTION BEFORE AND AFTER PLACING GRAVEL IN TRENCH.

NOTE: NO DRY WELL SHALL EXCEED 15 FOOT IN DIAMETER. NO ABSORPTION TRENCH TO EXCEED 100 FEET IN LENGTH.

NOTE: ALL PIPE FROM HOUSE TO SEPTIC TANK MUST BE CAST IRON OR SCHEDULE 40 PVC OR ABS.

PERMIT VOID AFTER THREE YEARS.


NOTE: INSTALL STAND PIPE ON SEPTIC TANK AND DRY WELL. STAND PIPES MUST BE 6 INCHES IN DIAMETER. CAST IRON, CONCRETE OR TERRA COTTA, OR PVC OR ABS ACCEPTED. IF TOP OF SEPTIC TANK IS DEEPER THAN 3 FEET MANHOLE TO GRADE REQUIRED.

*INSTALLER IS RESPONSIBLE FOR OBTAINING FINAL APPROVAL ON THIS PERMIT

*CALL 992-2330 FOR INSPECTION OF SEPTIC SYSTEMS.

EH - 2-1082

A 32984

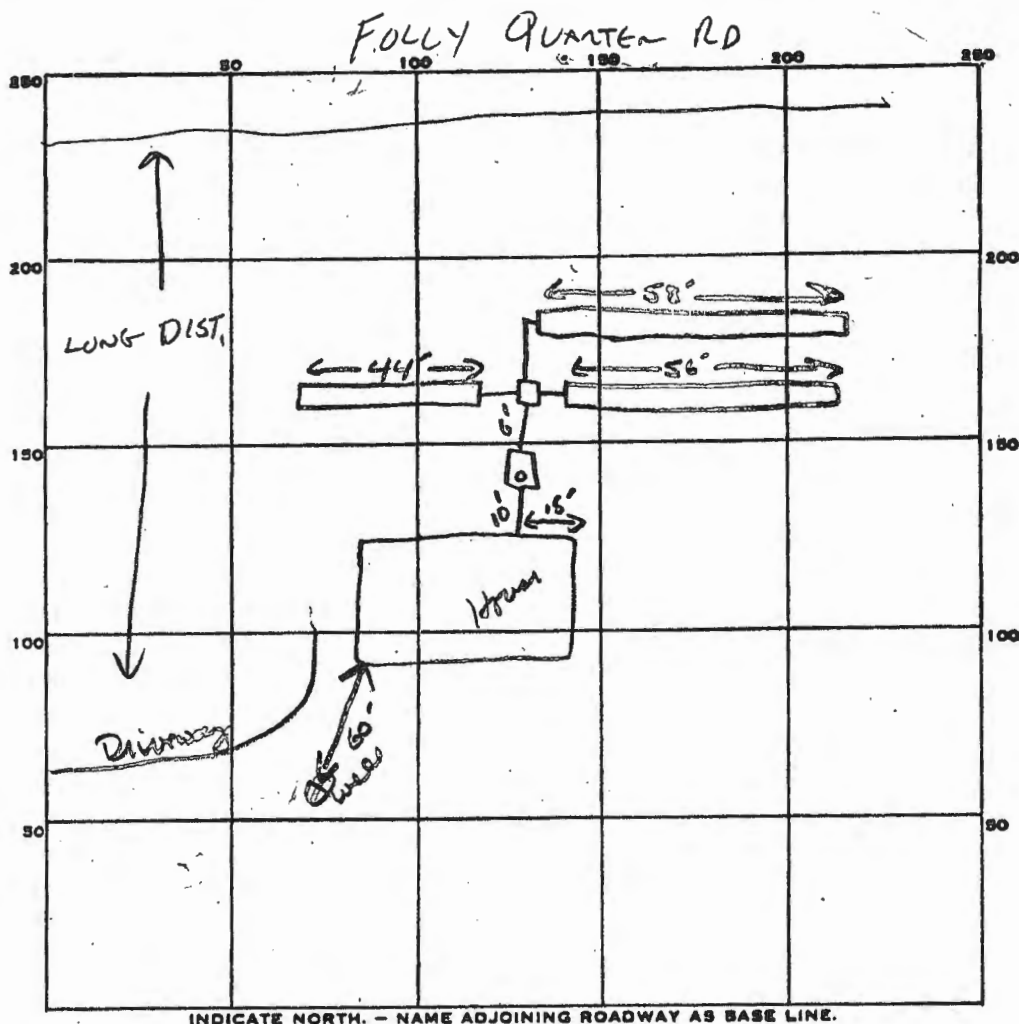

PERMIT CARD _____

SEPTIC TANK, LEVEL ✓ 1000 GAL

CLEANOUTS ✓ 5T

DISTRIBUTION BOX, LEVEL ✓

TILE FIELD, DEPTH 4.5 FT. TRENCH WIDTH 3 FT. INLET 3"

GRAVEL DEPTH 18 IN. TOTAL LENGTH 158 FT.


NUMBER OF TRENCHES 3 TOTAL BOTTOM AREA 474

SEEPAGE PITS, INSIDE DIAMETER _____ FT. DEPTH BELOW INLET _____ FT.

ABSORBENT AREA 474 SQ. FT.

REMARKS _____

DATE SYSTEM APPROVED 7-19-85 INSPECTOR SAW

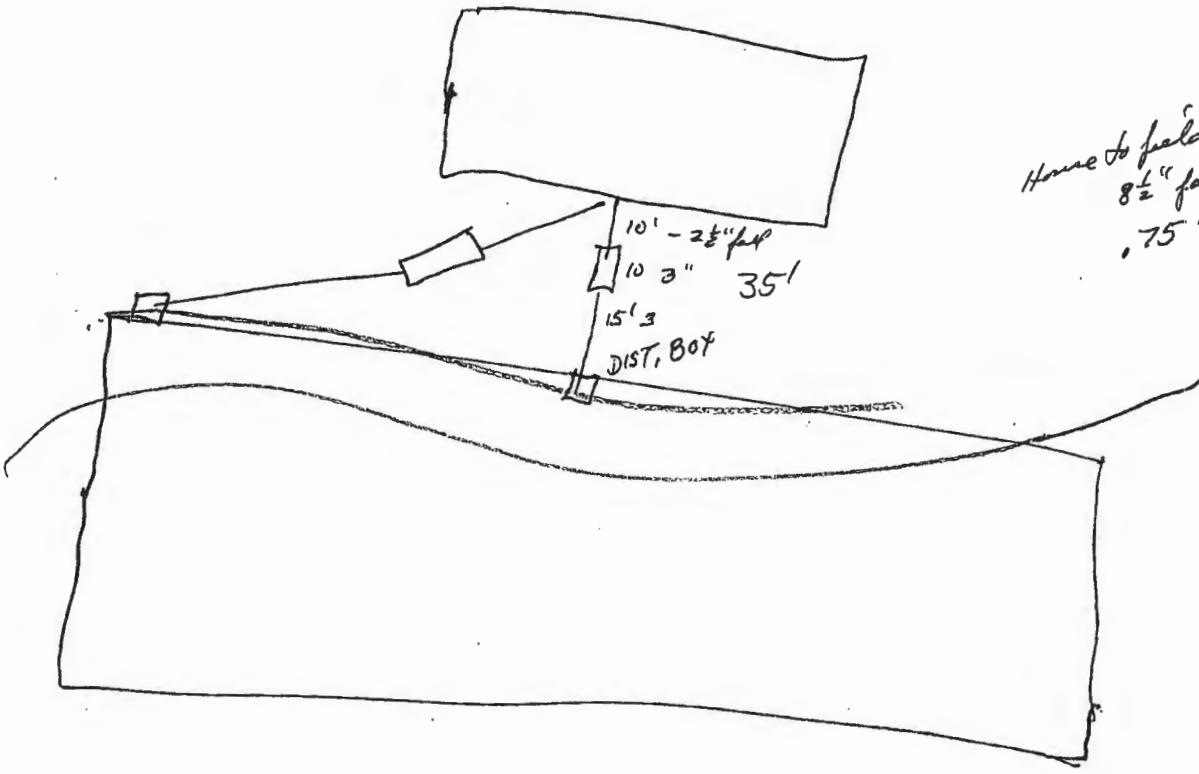

Home to field
8 1/2" fall
.75'