HE CO	C/AK	Department	Howard Coun of Inspections	ty Maryland D s, Licenses and Permits louse Drive	ermit No.:	1+	1		
Building Address: 12 City: Ellcott Cit	556	Folly Quante		Property Owner's Name: Address: 1256	1. alun	45 1	20		
Suite/Apt. #	×.	/WP/BA #:		City: Electric Hass	Fax:	Zip	Code: XIUTA		
Subdivision:	1.1.1		1	Phone: 10 201-8 Email: disterieu	5 227@	2 que	wil, com		
Lot:Tax M	ap: 3	A Parcel: MC	>	Applicant's Name & Mailing		0			
		an die en die en die de gester die en die en die	han a day na ana pina ana ang ang ang ang ang ang ang ang a	Applicant's Name: M Kc	(Vitaen	1			
	SFD			Address:			in Code: 21775		
Proposed Use: Nau	> Ue	tached Gavag	2	Phone: 443-344	4772Fax:				
Estimated Construction Co	st: \$	32,000		Email: Mr. Ke Q G		The second se	and a second the specific second s		
Description of Work:	watered	new Jetals		Contractor Company:	sen hon	25	LL		
quiring a				Address: 3703 Shung Land					
J				City: Gleman Stat	MD with	7- 0-1	375		
		**************************************		License No. :	173204	Zip Code	e: <u></u>		
warana dha dha maarraanii ahaan ahaa		e open se de fante de la construcción de la		Phone: 443-3,14-4	775 Fax:				
Occupant/Tenant Name:	540	ONL .	1. 1. 1. 1. 1. 1. 1. 1. 1. 1. 1. 1. 1. 1	Email: Mike & CI	Our it	ing	· COM		
	447 F. C. S. S. S.					1			
Was tenant space previou	sly occupied	Zer and Dyes and Party	ENo	Engineer/Architect Company:					
Contact Name:	149 Million -			Responsible Design Prof.:		ple su	c.t.		
Address:				Address: 9416 Cont		+			
City:		State: Zip Code: _		City: The Himan Stat	e: AAi) z	ip Code:	21239		
Phone:				Phone: 410-5994-45	87 Fax:	1			
Email:				Email: Jone b	1	and the second s			
1						1			
Commercial Building Ch	aracteristics			Utilities		1. 1. 2.	1		
Height: No. of stories:		SF Dwelling SF Toy Depth	Width		□ No □ No				
Gross area, sq. ft./floor:	728	1 st floor; 25	30	Water Supply					
		2 nd floor:		D Public					
Area of construction (sq.	. ft.):	Basement:		2 Private					
Use group:		- A	Unfinished Basement		al				
		Crawl Space		- D Public					
Construction type:		No. of Bedrooms:		2 Private					
Reinforced Concrete Structural Steel		Multi-family Dwelling		Heating System	<u>m</u>				
Masonry		No. of efficiency units:		Electric Oil					
Wood Frame				Natural Gas Propar	ne Gas		State of the second		
State Certified Modular		No. of 2 BR units: No. of 3 BR units: Other Structure:		Other:					
				Sprinkler System	<u>m:</u>				
		Dimensions: Footings:							
Roadside Tree Proj UYes	the second se			Grading Perm	it Number:		the second s		
the second s	Roadside Tree Project Permit #		lar						
		Manufactured Home		Building Shell Per	rmit Number:	it Number:			
WITH ALL REGULATIONS OF HOW APPLICATION; (5) THAT HE/SHE G Applicant's Signature	ARD COUNTY W RANTS COUNTY	HICH ARE APPLICABLE THERETO; (4)) THAT HE/SHE WILL ITO THIS PROPERTY	MAKE THIS APPLICATION; (2) THAT THE INF L PERFORM NO WORK ON THE ABOVE REFE FOR THE PUPPOSE OF INSPECTING THE WI Int Name	RENCED PROPERTY	NOT SPECI	FICALLY DESCRIBED IN THI		
	,			INANCE OF HOWARD COUNTY			10 10 10 10 10 10 10 10 10 10 10 10 10 1		
		pj	LEASE WRITE NEA	ATLY & LEGIBLY E USE ONLY-					
AGENCY	DATE	SIGNATURE OF APPROVAL		CK INFORMATION	Filing Fee	T	\$25		
State Highways		SUBSTITUTE OF AFFROVAL	Front:		Permit Fee		\$		
Building Officials		······	Rear: Side:		Tech Fee Excise Tax		\$		
PSZA (Zoning)			Side St.:		PSFS	md	\$		
PSZA (Engineering)	1.4	0		n setbacks met?	Guaranty Fi		\$ \$		
1	Nulza	GALL	Historic Dist	trict? 🗌 Yes 🗌 No	Total Fees	. The second	\$		
			and the second s	e for New Town Zone:	Sub- Total F Balance Du	and the statement of the			
CONTINGENCY CONSTRUCTION START			Job / Neu-III		Check		# 10012		
stribution of Contines Willies B	uilding Officiale	Green: PS7A Zoning	Vallow	w: PSZA.Engineering	Pink: Health		Gold SHA		
Health Is Sediment Control appro	RUCTION STAF	RT Green: PSZA,Zoning	Historic Dist Lot Coverag SDP/Red-lin	trict? 🗌 Yes 🗌 No	Total Fees Sub- Total F Balance Du	Paid	\$ \$ \$		

Distribution of Copies:	- White: Building Officials	Green: PS		
T:\Operations\Updated	Forms\BuildingPermitApplication0	3.29.2018.docx		

62

Real Property Data Search (w2)

Search Result for HOWARD COUNTY

View M	Мар		View GroundR	ent Redemptior	1		View	Grour	ndRent Regis	stration		
Tax Ex	empt:			Speci	al Tax Reca	oture:						
Exemp	ot Class:			NONE	8							
Account	Identifier	:	District -	03 Account Nu	mber - 3093	71						
				Own	er Informatio	n						
Owner Name:		STEPHENS DAVID STEPHENS MICHELLE			Use: Principal Residence:			RESIDENTIAL YES				
Mailing /	Address:		12556 FOLLY QUARTER RD ELLICOTT CITY MD 21042-1206			Deed Reference: /			/13595/ 00299			
					Structure Info	ormation						
Premises Address:		12556 FOLLY QUARTER RD ELLICOTT CITY 21042-0000		Legal Description:			LOT 2 3.533 A 12556 FOLLY QUARTER RD DONALD BERILLA					
Map:	Grid:	Parcel:	Sub District:	Subdivision:	Section:	Block:	Lot:	Ass Yea	essment r:	Plat No:	5713	
0022	0017	0110		2003			2	201	9	Plat Ref:		
Specia	al Tax Are	as:			Town:				NONE	_		
					Ad Valore	n:				100		
					Tax Class:							
Prima 1985	ry Structu	re Built	Above Grade 1,460 SF	Living Area	Finished Ba	asement Ar		ropert .5300 /	y Land Area	Cou	inty Use	
Storie	s Bas	ement	Туре	Exterio	or Full/H	alf Bath	Garag	18	Last Maj	or Renov	vation	
1	YES	3	STANDARD U	NIT FRAME	2 full		1 Atta					
			- <u></u>	Valu	le Informatio	n						
			Base V		Value		Phase-	in Ass	essments			
					As of		As of			of		
					01/01/2019		07/01/2	018	07	/01/2019	10 C	
Land:	(omonto		224,700		263,900							
Total:	ements		148,000 372,700		178,600 442,500		372,70		20	5.967		
	ential Lan	d:	0	,	442,500		572,700	,	0	5,907		
				Trans	sfer Informati	on						
Seller	BODDIS	ON NANCI	(F						Price: \$405,0	000		
		NGTH IMP			Date: 11/16/2011 Deed1: /13595/ 00299				Deed2:			
		ON NANCI			06/02/2010				Price: \$0			
		IS LENGTI			: /12489/ 00	051			Deed2:			
				Date:	06/02/2010				Price: \$0			
		S LENGT			: /12489/ 00	048			Deed2:			
				Exem	ption Informa	tion						
	xempt As	sessment	s: Class			07/01/2018			07/01/2019			
County:			000			0.00						
State:			000			0.00						
Municip	al:		000			0.00 0.00			0.00 0.00			
	cempt:				ial Tax Reca	pture:						
Exem	ot Class:			NON								
					Application In	nformation						
Homest	ead Appli	cation Sta	tus: Approved				14 mm 2 () 11 mm 2 (2 1 1 2 mm 2 1 2 mm	n				
			Ho	omeowners' Tax	Credit Applic	ation Information	ation					

- This screen allows you to search the Real Property database and display property records.
 Click here for a glossary of terms.
- 3. Deleted accounts can only be selected by Property Account Identifier.
- 4. The following pages are for information purpose only. The data is not to be used for legal reports or documents. While we have confidence in the accuracy of these records, the Department makes no warranties, expressed or implied, regarding the information.

COMPLETE THIS FORM WHEN DROPPING OFF ANY CORRESPONDENCE AND/OR PLANS TO THE HOWARD COUNTY DEPARTMENT OF INSPECTIONS, LICENSES AND PERMITS COUNTER:

Date:	10115/191
То:	(Person's Name and Division)
From:	Mille Crosen Crosen Hous (443) 324-4775 (Your Name, Company Name and Telephone Number)
Subject	
	Project site address 12556 Folly Quarter Have
	Permit # <u>B19002165</u> SDP #
	Other information pertinent to this project
✓ <u>Plea</u>	se check the attachments below that you are submitting with this transmittal:
	Letter of response to address plan review comment letter
	Revised plans and/or revised details: When submitting for a complete re-review, duplicate sets shall be submitted.
	Letter Summarizing Changes
\square	Energy conservation calculations Copies of <u>New Perc Cert Plat</u> (be specific).
	Health Department Request DPZ/ DED Request Applicant's Request
	Two sets of single family dwelling model plans to be placed on permanent file: Model name and/or #
	Other
	Contact Person Information: (Required)
	Mike Cropey Telephone No: 483-324-4755
	Mike Crossey Please Print Name E-Mail Address: mike @ Crosseyhouest (*


PLEASE ASSURE ALL DOCUMENTS AND/OR REVISIONS ARE APPROPRIATELY <u>SIGNED AND SEALED</u>, IF NECESSARY, BY A LICENSED ARCHITECT OR ENGINEER. PLEASE BE ADVISED THAT INSUFFICIENT INFORMATION MAY RESULT IN THE DELAY OF REVIEW BY THE PLANS EXAMINER. THE DEPARTMENT OF INSPECTIONS, LICENSES AND PERMITS WILL CONTACT YOU IF THERE IS A PROBLEM. IN ADDITION, ONCE THE BUILDING PERMIT IS APPROVED BY THE PLAN REVIEW DIVISION AND ALL OTHER REQUIRED SIGNATORY AGENCIES, AND THE BUILDING PERMIT <u>IS</u> READY FOR ISSUANCE, THE PERMIT DIVISION WILL NOTIFY THE APPROPRIATE CONTACT PERSON FOR PERMIT PICK UP. ALL PERMIT STATUS INQUIRIES SHALL BE DIRECTED TO THE PERMIT DIVISION AT 410-313-2455. CODE RELATED QUESTIONS AND PLAN REVIEW INQUIRIES SHALL BE DIRECTED TO THE PLAN REVIEW DIVISION AT 410-313-2436. PLEASE ALLOW A <u>MINIMUM OF FIVE (5) WORKING DAYS</u> FOR ANY PLAN SUBMITTALS TO BE REVIEWED. THANK YOU.


Revision for Health

White-Plan Review / Yellow-Applicant / Pink-Permit Division

Received by

t:\Operations\Updated forms\transmit.frm - Rev. 04/2014

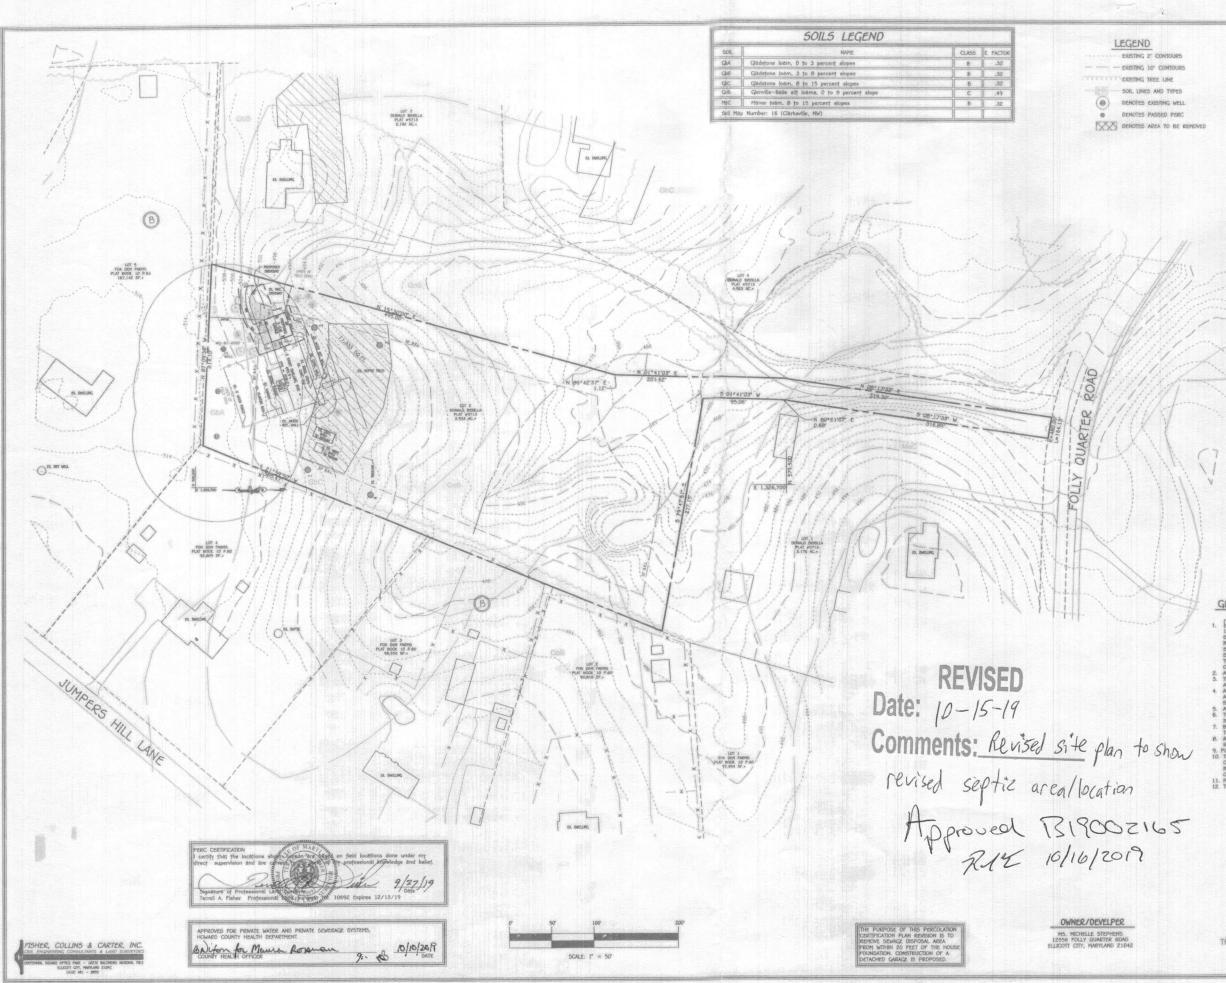

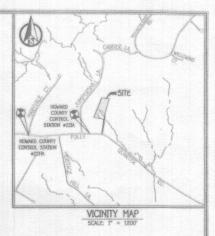

GENERAL NOTES:

THIS AREA DESIGNATES A PRIVATE SEWERAGE AREA OF AT 10,000 SQUARE FEET AS REQUIRED BY THE MARYLAND STATE DEFA ENVIRONMENT FOR INDIVIDUAL SEMERAGE DISMOSAL HIPROVENENTS IN THIS AREA ARE RESTOTED UNTIL PUBLICS SEMERAGE IS AVAILAR PAGEMENTS SHALL BECOME NULL AND VOID UPON CONNECTION TO SEMERAGE SYSTEM. THE COUNTY HALTH OFFICER SHALL HAVE TH TO GRANT ADJUSTMENTS TO THE PRIVATE SEMERAGE EXSEMENT. BY TO GRANT ADJUSTMENTS TO THE PRIVATE SEMERAGE ASSAULTS

ANY CHANGES TO A PERVATE GENERACE AREA SHALL BE REVISED PECE CERTIFICATION PLAN PLAT REFERENCE 5713. The EXISTING VINN, SHED WHICH HAS BEEN PLACED IN OWNER IS DESCRIBED BY THE OWNER AS MORABLE. TI IN PLACE. THE VANN, SHED HUST BE REMOVED FROM TH OCCUPIES IS NEEDED FOR INSTALLATION OF SEPTIC 595 PERCOLATION TEST LOCATIONS ARE DEST FIT FROM HEAL THE WELL HO-81-0707 HAS BEEN FIELD LOCATED AND

PERC CERTIFICATION PLAT DONALD BERILLA LOT 2 LOT 2 12556 FOLLY QUARTER ROAD ZONED: RR-DEO PLAT No.: 5713 TAX MAP No. 22 GRID No. 17 PARCEL No. 110 THIRD ELECTION DISTRICT HOWARD COUNTY, MARYLAND SCALE: AS SHOWN DATE: SEPTEMBER 23, 2019 SHEET 1 OF 1