

5/7/85
5/7/85
A.S.A.P.
U.P.T. 5/7/85
5-7-85
approved
SAB
P 33268
A 09884

PERMIT

SEWAGE DISPOSAL SYSTEM

MARYLAND STATE DEPARTMENT OF HEALTH

HOWARD COUNTY
BUREAU OF ENVIRONMENTAL HEALTH
992-2330

INDEXED

ELLCOTT CITY

DISTRICT 3rd

DATE 4/10/85

C. C. Cissel

IS PERMITTED TO INSTALL ☒ ALTER ☐

ADDRESS 14079 Brighton Dam Road, Clarksville, MD 21029 PHONE 854-2006

SUBDIVISION Fox Den Farms ROAD 12510 Canter Lane LOT 2, Blk. C

PROPERTY OWNER Mr. & Mrs. J. W. Lee

ADDRESS

IF GARBAGE GRINDER IS USED INCREASE SEPTIC TANK CAPACITY BY 50% AND ABSORPTION AREA BY 22%.

GARBAGE GRINDER? YES ☒ NO ☐

SEPTIC TANK CAPACITY 2000 GALLONS NUMBER OF BEDROOMS 5

TRENCHES - 193 sq. ft. per bedroom with garbage grinder. Trench to be 2 feet wide. Inlet 4 feet below original grade. Bottom maximum depth 10 feet below original grade. Effective area begins at 4 feet below original grade. 6 feet of stone below distribution pipe. LOCATION: Start the trench 410 feet from the front lot line and 167 feet from the left lot line as seen when facing the property from Canter Lane. Run trench along level ground toward front of lot. NOTE: No Trench to exceed 100 feet in length. If more than one trench used, a distribution box is required. Call for inspection of trench(s) before and after gravel is installed. Provide 6" - 8" diameter cleanout and cap to grade or above on septic tank.

PLANS APPROVED BY C. Williams DATE 9/7/84

COVER NO WORK UNTIL INSPECTED AND APPROVED.

NEITHER THE HOWARD COUNTY COUNCIL NOR THE HEALTH DEPARTMENT IS RESPONSIBLE FOR THE SUCCESSFUL OPERATION OF ANY SYSTEM.

NOTE: IF TRENCH IS USED CALL FOR INSPECTION BEFORE AND AFTER PLACING GRAVEL IN TRENCH.

NOTE: NO DRY WELL SHALL EXCEED 15 FOOT IN DIAMETER. NO ABSORPTION TRENCH TO EXCEED 100 FEET IN LENGTH.

NOTE: ALL PIPE FROM HOUSE TO SEPTIC TANK MUST BE CAST IRON OR SCHEDULE 40 PVC OR ABS.

PERMIT VOID AFTER THREE YEARS.


NOTE: INSTALL STAND PIPE ON SEPTIC TANK AND DRY WELL. STAND PIPES MUST BE 8 INCHES IN DIAMETER CAST IRON, CONCRETE OR TERRA COTTA, OR PVC OR ABS ACCEPTED. IF TOP OF SEPTIC TANK IS DEEPER THAN 3 FEET MANHOLE TO GRADE REQUIRED.

BLDG. PERMIT SIGNED
AND RETURNED 4/24/85
Sinal # 65577
Pral

*INSTALLER IS RESPONSIBLE FOR OBTAINING FINAL APPROVAL ON THIS PERMIT

*CALL 992-2330 FOR INSPECTION OF SEPTIC SYSTEMS.

EH - 2-1082

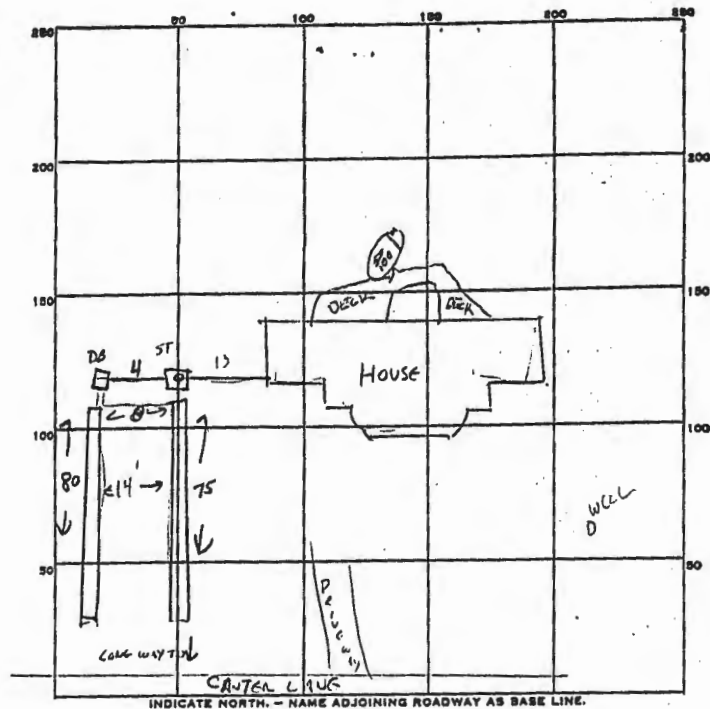

PERMIT CARD ☒

SEPTIC TANK, LEVEL ☒

CLEANOUTS ST ☒

DISTRIBUTION BOX, LEVEL ☒

TILE FIELD, DEPTH 10 FT. TRENCH WIDTH 2 FT.

INLET AT 4"

GRAVEL DEPTH 6 FT IN. TOTAL LENGTH 155 FT.

NUMBER OF TRENCHES 2 (75+80) TOTAL BOTTOM AREA 930

$\frac{3}{85}$
 $\frac{1}{2}$
930

SEEPAGE PITS, INSIDE DIAMETER FT. DEPTH BELOW INLET FT.

ABSORBENT AREA 930 SQ. FT.

REMARKS TRENCHES OK TO ADD GRAVEL 5/6/85 CW

5-7-85 OK TO COVER ALL WELLS

DATE SYSTEM APPROVED

5-7-85

INSPECTOR

S. Abel

APPLICATION

SEWAGE DISPOSAL TESTING

MARYLAND STATE DEPARTMENT OF HEALTH

HOWARD COUNTY

ELLICOTT CITY

DISTRICT 3

DATE 3/31/65

*Dry well 12 ft. in diameter 12 ft. deep
below the inlet to the 300 ft. from
the front property line and 16 ft. from
the left side property line as seen when
facing the lot from Center Lane.*

*1000 gal. septic
tank.*

TO: THE COUNTY HEALTH OFFICER
ELLICOTT CITY, MARYLAND

I, HEREBY, APPLY FOR THE NECESSARY TESTS IN ORDER TO CONSTRUCT (OR RECONSTRUCT) A SEWAGE DISPOSAL SYSTEM.

PROPERTY OWNER Fox Den, Inc.

ADDRESS Folly Quarter Rd., Ellicott City, Md. PHONE HO 5-4222

PROPERTY LOCATION:

SUBDIVISION Fox Den Farms LOT NO. 2, Blk. C

ROAD AND DESCRIPTION Road Not Named CENTER LANE

OCCUPANT _____ PHONE _____

PERSON TO CONSTRUCT SYSTEM _____

ADDRESS _____ PHONE _____

SIZE OF LOT 227,500 sq. ft. TYPE BLDG. 4 NUMBER OF BEDROOMS _____

IF NOT SINGLE RESIDENCE DESCRIBE _____

SIGNATURE OF APPLICANT /s/ Geo. B. White


✓ APPROVED BY J. Horgan FOR Dry Well DATE 12-16-65
(KIND OF SYSTEM)

REJECTED BY _____ FOR _____ DATE _____
(KIND OF SYSTEM)

HOLD PENDING FURTHER TESTS _____ DATE _____

REASONS FOR REJECTION OR HOLDING _____

THIS IS NOT A PERMIT

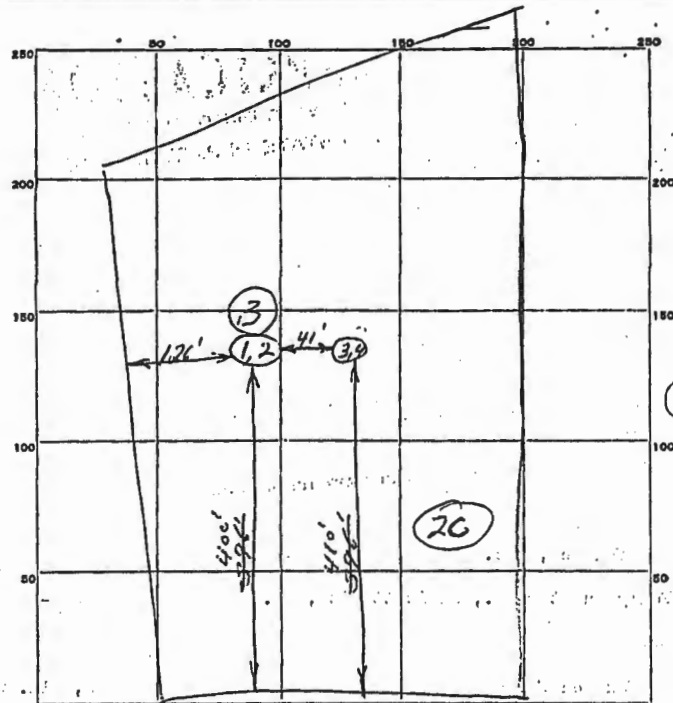

HOLE
ELEV ✓
(32) HIGH
(12) LOW

INDICATE NORTH - NAME ADJOINING ROADWAY AS BASE LINE.

CANTER LANE

DATE	TEST NO.	DEPTH	PRE-WET		TEST - 1" DROP		TIME
			START	STOP	START	STOP	
4-4-65	1 Same	9 1/2'	3:04	3:05	3:05	3:07	2 min
	2 Pit	6'	3:07	3:08	3:08	3:11	3 min
	3 Same	9'	3:13	3:14	3:14	3:20	6 min
	4 Pit	4 1/2'	3:15	3:19	3:19	3:24	5 min
3/2/83	13 ✓	15	ALL	TAN	SAND		over pore time 4 min

SOIL AUGER FINDING soil good

TESTED BY J.A.

REMARKS 4-4-65
g.o.w. hole

No the records
Online

FOGLE'S SEPTIC CLEAN, INC.
580 Obrecht Road • Sykesville • Maryland 21784
(410) 795-5670



SEPTIC EVALUATION

☒ Buyer / ☐ Seller	Date: 6/28/17 Time: 10am	Occupied? ☒ Yes / ☐ No
Client: Bill Erskine	Ordered By:	If vacant, how long?
Property Address:	Phone: 443-864-8844	Last pumped: 3 years ago
12510 Canter Lane	email: wimerskine@verizon	Property age: 1986, 5BR
Ellicott City, MD 21042	Weather: ret	System age:
	Ground Conditions:	

Liquid level: ☐ Above Normal / ☒ Normal / ☐ Below normal	Depth of tank: 2'
Maintenance Appears: ☐ Good / ☒ Fair / ☐ Poor	Access to tank: 6" x 10"
Effluent Filter present? ☐ Yes / ☒ No	Pump system: ☐ Yes / ☒ No

Type of Tank	Tank Composition & Size	Type of Absorption System
☒ Septic Tank (1 tank)	☐ Metal ☒ Concrete ☐ Unknown	☒ Drainfield
☐ Cesspool	Tank Size: 1250g	☐ Drywell
☐ Aeration System	Baffles intact? ☒ Yes / ☐ No	☐ Sandmound
☐ Other:		☐ Other:

Inspected System Appears:	Inspector's Comments	Sketch of System
☒ Functional ☐ Marginal ☐ Unsatisfactory	Septic tank is due for cleaning due to the amt of solids present. Approx cost \$235. System has good flow throughout. Drainfields are functioning properly.	
Inspector:		
Signature: K. Carroll		
Inspection Fee: \$275		
Water Test: \$200		
Amount Due: \$475		
Date Paid:		
Check #		

IMPORTANT: Carrie - 3hr well yield 8am 6/28/17 \$500

- This is a subjective and visual inspection only, based upon many unknown and unseen factors.
- The condition of the Sewage Disposal system is reported as of the above date.
- This report does not WARRANT nor GUARANTEE continued functional Sewage Disposal System operations.
- If house has been unoccupied, this report may not be accurate. Little or no use of the septic system could have allowed the problems to temporarily clear themselves.
- If a larger family is moving in than is presently occupying the house, the septic system may be subject to failure.
- If the general ground condition is wet, this report may not be accurate, as ground moisture may cover or hide actual septic effluent on the surface.
- In the above cases, it is strongly suggested that the septic system be re-certified in 3 to 6 months.
- If the system is rated below as marginal or unsatisfactory, it is suggested that the local health department be contacted to inspect and confirm the findings.

Payment for this inspection signifies understanding and acceptance of above clauses.