

APPLICATION

SEWAGE DISPOSAL TESTING

STATE OF MARYLAND - DEPARTMENT OF HEALTH AND MENTAL HYGIENE

HOWARD COUNTY HEALTH DEPARTMENT
ENVIRONMENTAL HEALTH SERVICES

P. O. BOX 476, ELLICOTT CITY, MARYLAND 21043
TELEPHONE: 465-5000, EXT. 356

DISTRICT 4
DATE 9/18/74

* Dry well(s) to have 150 sq ft absorbent sidewall area below the inlet. Inlet to DN to be 3 ft below original grade, and maximum depth of DN to be 12 ft. Locate dry well(s) 530 ft from Rover Mill Rd, and 130 ft from the right lot line, as seen when facing lot from Rover Mill Rd. * If a trench is to be used in lieu of one dry well, call this office for recommendation!

TO: THE COUNTY HEALTH OFFICER
ELLICOTT CITY, MARYLAND

I, HEREBY, APPLY FOR THE NECESSARY TEST IN ORDER TO CONSTRUCT (OR RECONSTRUCT) A SEWAGE DISPOSAL SYSTEM.

PROPERTY OWNER John & Evelyn Keganan

ADDRESS, 3015 A Oak Green Circle, Ellicott City, Md. PHONE 465-9541

PROPERTY LOCATION:

SUBDIVISION (Rover Mill Estates) LOT NO. #2

ROAD AND DESCRIPTION Lot #2, Rover Mill Rd.

SIZE OF LOT 5,061 Ac. TYPE BLDG. 4Bedrooms
NUMBER OF BEDROOMS

IF NOT SINGLE RESIDENCE DESCRIBE

THE SYSTEM INSTALLED UNDER THIS APPLICATION IS ACCEPTABLE ONLY UNTIL PUBLIC FACILITIES BECOME AVAILABLE.

SIGNATURE OF APPLICANT John Keganan

APPROVED BY William H. Zepp FOR DW(s) / trench DATE 10/28/74
(KIND OF SYSTEM)

REJECTED BY _____ FOR _____ DATE _____
(KIND OF SYSTEM)

HOLD PENDING FURTHER TESTS WWZ DATE 10/3/74

REASONS FOR REJECTION OR HOLDING final plat is certified that holes.

THIS IS NOT A PERMIT

Lat 2

ROVER MILL RD

12/13/74

120 ~~4~~/BR

$$20\% = 30\%$$

150 ~~4~~ / 2R

Certified true & correct

Sandy Cove

Wuz


ALSO PRESENT:

APPROVED: For private water and private
sewerage systems, Howard County Health Dept.

County Health Officer

Date

NOTE: The lot shown hereon complies with
minimum ownership width and lot area as
required by The Maryland State Department
of Health Regulations.

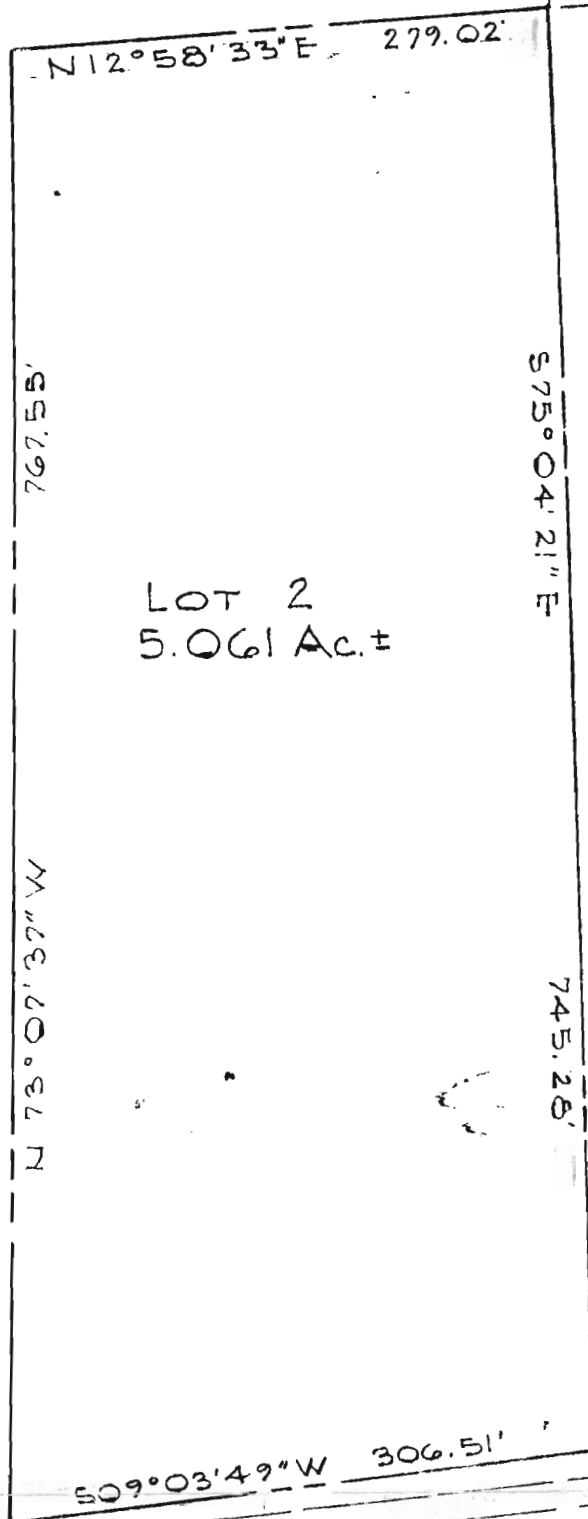

ROVER MILL ROAD

PURDUM & JESCHKE
ENGINEERS &
LAND SURVEYORS
3697 PARK AVE.
ELLICOTT CITY, MARYLAND

LOT No. 2
ROVER MILL ESTATES
4th ELECTION DISTRICT
HOWARD COUNTY, MARYLAND
JUNE 20, 1973
SCALE: 1" = 100'

HOWARD COUNTY HEALTH DEPARTMENT

Ellicott City, Maryland 21043

Phone: 465-5000

To: DWM

John & Evelyn Keenan
Rover Mill Estates
Lots #2 & 3

Final plats ok for signature!

Lot 2

460' fr. front
65' fr. left.

Lot 3

530' front
130' fr. right

OK DWM

From: WWZ

Date: 10/28/74