

RECORDED

APPLICATION

Lancaster
A 20440

SEWAGE DISPOSAL TESTING

P _____

STATE OF MARYLAND - DEPARTMENT OF HEALTH AND MENTAL HYGIENE

HOWARD COUNTY HEALTH DEPARTMENT
ENVIRONMENTAL HEALTH SERVICESP. O. BOX 476, ELLICOTT CITY, MARYLAND 21043
TELEPHONE: 465-5000, EXT. 356Septic Tank { 1-3 Bedroom 1000 gallons
4 Bedroom 1250 gallons
DISTRICT 3rd & 4th
DATE 7/30/74

Dry Well to have 130 sq. ft. effective
absorbent sidewall area per bedroom below inlet.
Inlet to be 3 1/2' below original grade & maximum
depth 7 1/2' below original grade. Location 36' down
right of property line & 205' in off right property line
when facing lot from road. (Per hole 142)
Hold for plat of holes by owner

TO: THE COUNTY HEALTH OFFICER
ELLICOTT CITY, MARYLANDI, HEREBY, APPLY FOR THE NECESSARY TEST IN ORDER TO CONSTRUCT (OR RECONSTRUCT) A SEWAGE
DISPOSAL SYSTEM.PROPERTY OWNER Ruth ThompsonAny questions call Mr. Bernard
Rome, 465-7700

ADDRESS _____

PHONE _____

PROPERTY LOCATION:

SUBDIVISION _____ LOT NO. 12ROAD AND DESCRIPTION Rover Mill Road and McKendree RoadSIZE OF LOT 5.002 acres TYPE BLDG. 3 or 4 bedrooms

NUMBER OF BEDROOMS

IF NOT SINGLE RESIDENCE DESCRIBE _____


THE SYSTEM INSTALLED UNDER THIS APPLICATION IS ACCEPTABLE ONLY UNTIL PUBLIC
FACILITIES BECOME AVAILABLE.SIGNATURE OF APPLICANT /s/ Bernard RomeAPPROVED BY C. Street FOR Dry Well DATE 8/13/74
(KIND OF SYSTEM)REJECTED BY _____ FOR _____ DATE _____
(KIND OF SYSTEM)

HOLD PENDING FURTHER TESTS _____ DATE _____

REASONS FOR REJECTION OR HOLDING _____

Bruce Lancaster5103 Crossfield Cir. #16Rockville, Md (8) 881-1687

THIS IS NOT A PERMIT

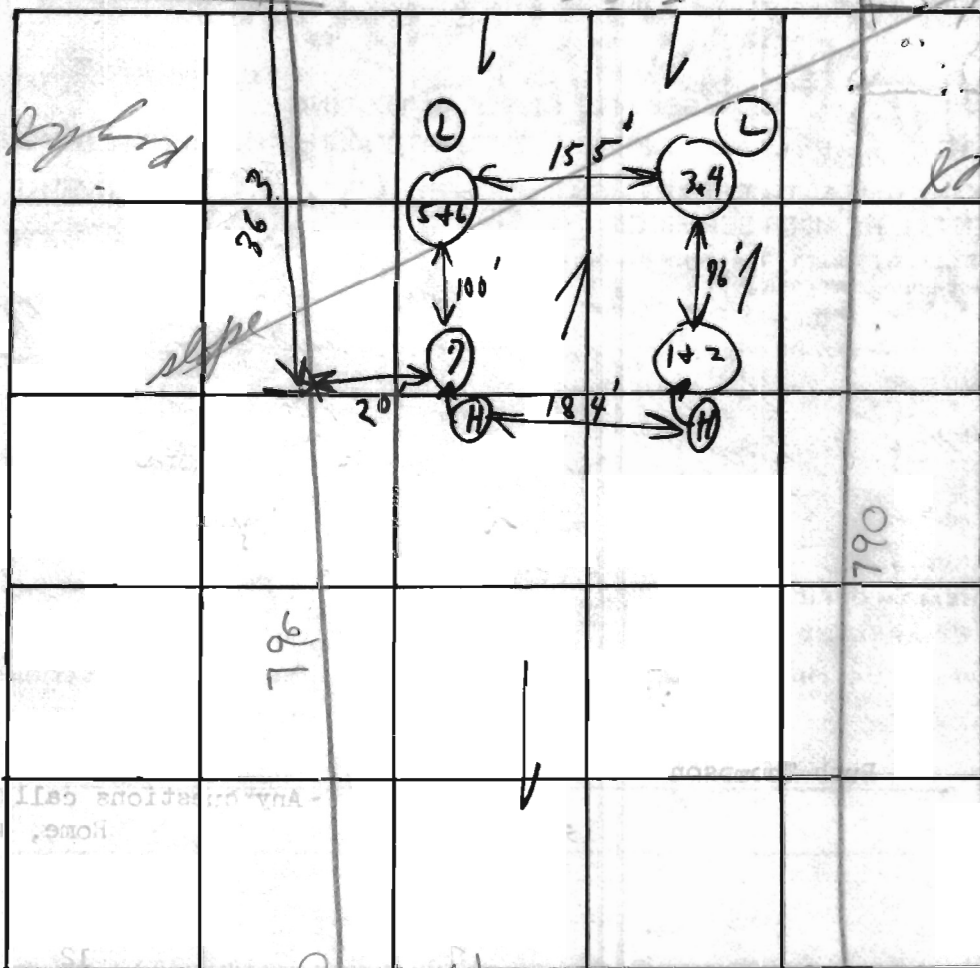

INDICATE NORTH HERE ADJOINING ROADWAY AS BASE LINE

DATE	TEST NO.	DEPTH	PRE-WET		TEST - 1" DROP		TIME
			START	STOP	START	STOP	
8/8/74	1	3 1/2' s	9:44	9:46	9:46	9:49	3 min
	(H) 2	12' d	9:43	9:47	9:47	9:53	6 min
	3	3' s	10:34	10:36	10:36	10:40	4 min
	(L) 4	12' d	10:33	10:35	10:35	10:41	6 min
	(L) 5	3 1/2' s	9:55	9:57	9:57	10:01	4 min
	6	12' d	9:59	10:10	10:10	10:31	21 min
	(H) 7	(12' Visual similar to 5+6)					644 8 min

REMARKS

↓ Sandy loam

TYPE OF SOIL

TESTED BY

C.B.D.

ALSO PRESENT:

Jim from Boring & Co.
Lot 12

APPLICATION

A 22072

P. _____

SEWAGE DISPOSAL TESTING

STATE OF MARYLAND - DEPARTMENT OF HEALTH AND MENTAL HYGIENE

HOWARD COUNTY HEALTH DEPARTMENT
ENVIRONMENTAL HEALTH SERVICESDISTRICT 4P. O. BOX 476, ELLICOTT CITY, MARYLAND 21043
TELEPHONE: 465-5000, EXT. 356DATE 9/3/75

3BR : 1000 gal S.T.

D.W. located: 140' off rgt prop line, as seen from the road and
295' from the front prop. line. Sidewall area: 172^{sq} ft/B.R.
Inv. @ 3', max depth 10' below O.G.

D.W. 10' x 10' x 7' deep + Trench 40' x 7' deep x 18" wide;
5' buffer between D.W. & Trench

TO: THE COUNTY HEALTH OFFICER
ELLICOTT CITY, MARYLAND

R.M. 11/28/75

I, HEREBY, APPLY FOR THE NECESSARY TEST IN ORDER TO CONSTRUCT (OR RECONSTRUCT) A SEWAGE
DISPOSAL SYSTEM.PROPERTY OWNER Bruce LancasterADDRESS 5103 Crossfield Court #16 PHONE (8) 881-1687
Rockville, Maryland

PROPERTY LOCATION:

SUBDIVISION _____ LOT NO. 12ROAD AND DESCRIPTION Rover Mill Road and KcKendree RoadSIZE OF LOT 5.002 acres TYPE BLDG. 3 or 4

NUMBER OF BEDROOMS

IF NOT SINGLE RESIDENCE DESCRIBE _____ (Single Fmly. Dwllg.)

THE SYSTEM INSTALLED UNDER THIS APPLICATION IS ACCEPTABLE ONLY UNTIL PUBLIC
FACILITIES BECOME AVAILABLE.SIGNATURE OF APPLICANT /s/ Bruce LancasterAPPROVED BY R. Monahan FOR DW & Trench DATE 11/28/75
(KIND OF SYSTEM)REJECTED BY _____ FOR _____ DATE _____
(KIND OF SYSTEM)


HOLD PENDING FURTHER TESTS _____ DATE _____

REASONS FOR REJECTION OR HOLDING _____

BLDG. PERMIT. SIGNED
AND RETURNED 12/12/75
Signed - 12/12/75

THIS IS NOT A PERMIT

Springhead area

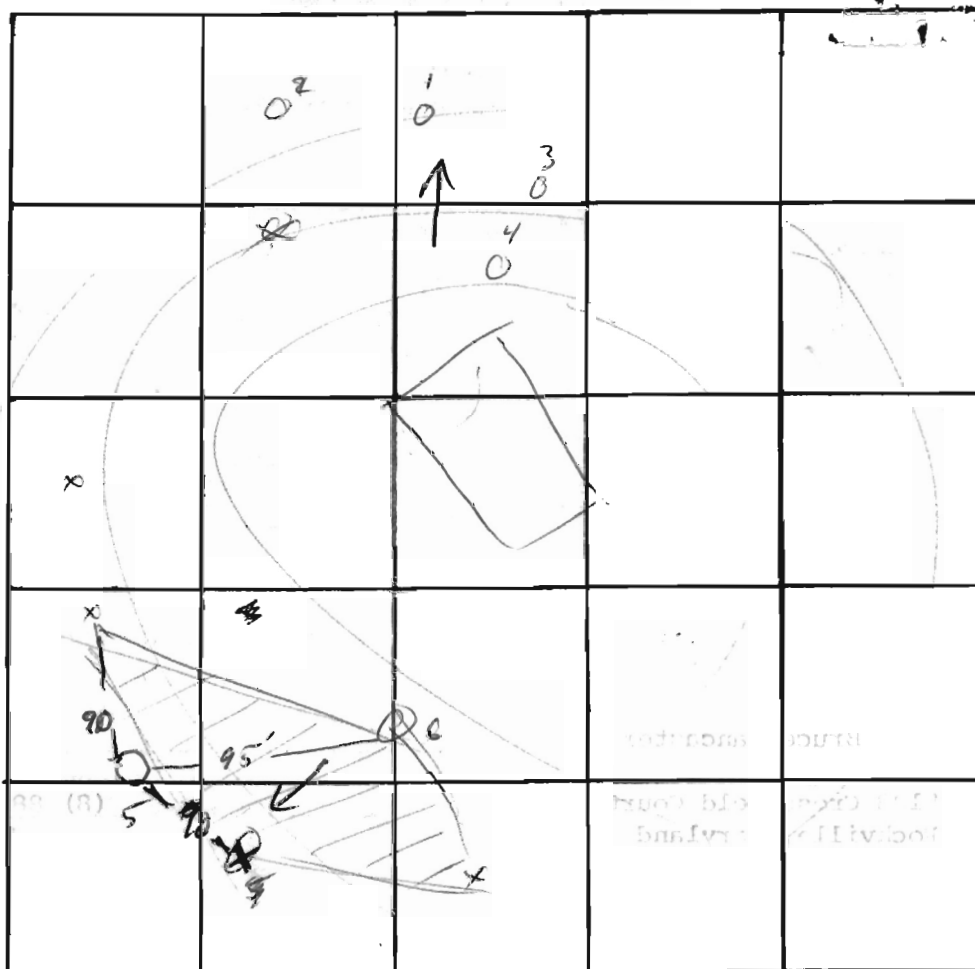

INDICATE NORTH. - NAME ADJOINING ROADWAY AS BASE LINE.

← R w →

not used

DATE	TEST NO.	DEPTH	PRE-WET		TEST - 1" DROP		TIME
			START	STOP	START	STOP	
1-10	1	9 1/2 - 10'	H ₂ O			105 000.	
INT of	2	↑					
	3	↓					
	4	12	VIS	dry	V.G.		
	5	12	VIS		dry		
	B	3	11 ⁵⁰	12 ⁰⁰	12 ⁰⁰	12 ¹²	12
	6A	12	11 ⁵⁰	12 ⁰¹	12 ⁰¹	12 ¹⁵	14

REMARKS

TYPE OF SOIL

TESTED BY

ALSO PRESENT:

J. Brittingham