

B 1	7681	SEQUENCE NO. (WRA USE ONLY)	<b>STATE OF MARYLAND</b> <b>WATER RESOURCES ADMINISTRATION</b> <b>TAWES STATE OFFICE BLDG., ANNAPOLIS, MARYLAND 21401</b> <b>APPLICATION FOR PERMIT TO DRILL WELL</b>	WRA PERMIT NUMBER <b>HO-73-13681</b> FILL IN THIS FORM COMPLETELY
-----	------	--------------------------------	--	---

DATE RECEIVED (WRA USE ONLY) <b>3/30/76</b> <b>1:30</b>	OWNER COL 15 LAST NAME <b>LANCASTER</b>	FIRST NAME <b>BRUCE</b>	COL. 34
	STREET OR RFD COL 36 <b>5103 CROSSFIELD ST</b>		COL. 55
	POST OFFICE COL 57 <b>ROCKVILLE MD 20852</b>		COL. 76

B 1	CONTINUED	<b>DRILLER INFORMATION</b>	
1 2 3 (SEQ. NO.)	6		
DATE	LICENSE NUMBER	77	80
FIRST NAME	DRILLER	LAST NAME	
SIGNATURE			

B 2	<b>WELL INFORMATION</b>		
1 2 3 (SEQ. NO.)	6		
MAXIMUM PUMPING RATE (GALLONS PER MINUTE)		8	12
AVERAGE DAILY QUANTITY NEEDED (GALLONS PER DAY)		14	20
<b>USE FOR WATER (CIRCLE APPROPRIATE BOX)</b>			
<input type="checkbox"/> D	HOME (SINGLE OR DOUBLE HOUSEHOLD UNIT ONLY)		
<input type="checkbox"/> F	FARMING, AGRICULTURE, IRRIGATION		
<input type="checkbox"/> I	INDUSTRIAL, COMMERCIAL, STATE AND FEDERAL GOVERNMENT.		
<input type="checkbox"/> M	MUNICIPAL WATER SUPPLY		
<input type="checkbox"/> P	PRIVATE WATER COMPANY		
<input type="checkbox"/> T	TEST		
MUST HAVE STATE HEALTH DEPT. APPROVAL			

APPROXIMATE DEPTH OF WELL	24	28	FEET
---------------------------	----	----	------

APPROXIMATE DIAMETER OF WELL	6	(NEAREST INCH)
------------------------------	---	----------------

<b>METHOD OF DRILLING USED (CIRCLE APPROPRIATE METHOD)</b>			
<input type="checkbox"/> BORED (OR AUGERED)	<input type="checkbox"/> JETTED	<input type="checkbox"/> DRIVEN	
<input type="checkbox"/> AIR-ROTARY	<input type="checkbox"/> AIR-PERCUSSION	<input type="checkbox"/> ROTARY (HYDRAULIC ROTARY)	
<input type="checkbox"/> CABLE	<input type="checkbox"/> REVERSE-ROTARY	<input type="checkbox"/> DRIVE-POINT	
OTHER (DESCRIBE)			

<b>REPLACEMENT OR DEEPEINED WELLS (CIRCLE APPROPRIATE BOX)</b>			
<input type="checkbox"/> N	THIS WELL WILL NOT REPLACE AN EXISTING WELL		
<input type="checkbox"/> Y	THIS WELL WILL REPLACE A WELL THAT WILL BE ABANDONED AND SEALED		
<input type="checkbox"/> S	THIS WELL WILL REPLACE A WELL THAT WILL BE USED AS A STANDBY		
<input type="checkbox"/> D	THIS WELL WILL DEEPEIN AN EXISTING WELL		
PERMIT NUMBER OF WELL TO BE REPLACED OR DEEPEINED (IF AVAILABLE)			
	41	52	

<b>NOT TO BE FILLED IN BY DRILLER (WRA USE ONLY)</b>			
APPROPRIATION PERMIT NUMBER	54	63	65
ENGINEER REVIEW DISTRICT NO.			
FORCE	WRITE INITIALS IN BOX	CONDITIONS	
67 68		70 71 72 73 74 75 76 77 78 79	

B 4	CONTINUED	<b>HEALTH DEPARTMENT APPROVAL</b>	
1 2 3 (SEQ. NO.)	6		
41	STATE HEALTH (CIRCLE BOX)	COUNTY NAME	COUNTY NO.
DATE	MO. DAY YR.		
43	48	APPROVED BY	

B 5	SPECIAL CONDITIONS 8-63 (WRA USE ONLY)	
1 2 3 (SEQ. NO.)	6	

B 3	<b>LOCATION OF WELL</b>		
1 2 3 (SEQ. NO.)	6		
COUNTY	8	(DO NOT ABBREVIATE COUNTY NAME)	21
SUBDIVISION	23		42
SECTION	44	46	LOT 48 50
NEAREST TOWN	52		71
MILES FROM TOWN (ENTER 0 IF IN TOWN)	73		76 77 78

B 4	<b>DIRECTION FROM TOWN (CIRCLE APPROPRIATE BOX)</b>		
1 2 3 (SEQ. NO.)	6		
<input type="checkbox"/> N NORTH	<input type="checkbox"/> E EAST	<input type="checkbox"/> NE NORTHEAST	<input type="checkbox"/> SE SOUTHEAST
<input type="checkbox"/> S SOUTH	<input type="checkbox"/> W WEST	<input type="checkbox"/> NW NORTHWEST	<input type="checkbox"/> SW SOUTHWEST
NEAR ROAD	WHAT	11	NORTH SOUTH EAST WEST 30
ON WHICH SIDE OF ROAD (CIRCLE APPROPRIATE BOX)			
<input type="checkbox"/> N	<input type="checkbox"/> S	<input type="checkbox"/> E	<input type="checkbox"/> W
DISTANCE FROM ROAD (ENTER DISTANCE AND CIRCLE APPROPRIATE BOX)			
34	100	37	38 39

DRAW A SKETCH BELOW SHOWING LOCATION OF WELL IN RELATION TO NEARBY TOWNS, ROADS AND STREAMS WITH NORTH IN THE DIRECTION OF THE ARROW, AND GIVE DISTANCE FROM WELL TO NEAREST ROAD JUNCTION OR STREAM CROSSING SHOWN ON THE SKETCH. ALSO SHOW, BY MEANS OF AN "X", THE WELL LOCATION IN THE BOX BELOW AND THE BOX NUMBER FROM THE WELL LOCATION MAP.

N	
BOX NUMBER	E 790 N 530
NORTH COORDINATE	50 51 52 53 54 55
EAST COORDINATE	57 58 59 60 61 62 63
ELEVATION AT WELL HEAD (FEET)	65 66 67 68
0/5	5/5
0/0	5/0

B 1 2885

SEQUENCE NO.  
(WRA USE ONLY)

## STATE OF MARYLAND

WATER RESOURCES ADMINISTRATION

TAWES STATE OFFICE BLDG., ANNAPOLIS, MARYLAND 21401

## APPLICATION FOR PERMIT TO DRILL WELL

WRA PERMIT NUMBER

40-73-1386  
FILL IN THIS FORM COMPLETELYDATE RECEIVED  
(WRA USE ONLY)

OWNER

COL 15 LAST NAME

FIRST NAME

COL. 34

STREET  
OR RFD

COL 36

COL. 55

POST  
OFFICE

COL 57

COL. 76

8-13

B 1 CONTINUED

## DRILLER INFORMATION

1 2 3 (SEQ. NO.) 6

DATE

LICENSE  
NUMBER

77

80

FIRST NAME

DRILLER

LAST NAME

SIGNATURE

B 2

## WELL INFORMATION

1 2 3 (SEQ. NO.) 6

MAXIMUM PUMPING RATE (GALLONS PER MINUTE)

8

12

AVERAGE DAILY QUANTITY NEEDED (GALLONS PER DAY)

14

20

## USE FOR WATER (CIRCLE APPROPRIATE BOX)

☐ D HOME (SINGLE OR DOUBLE HOUSEHOLD UNIT ONLY)☐ F FARMING, AGRICULTURE, IRRIGATION☐ I INDUSTRIAL, COMMERCIAL, STATE AND FEDERAL GOVERNMENT.☐ M MUNICIPAL WATER SUPPLY☐ P PRIVATE WATER COMPANY☐ T TEST

MUST HAVE STATE HEALTH DEPT. APPROVAL

APPROXIMATE DEPTH OF WELL

24

28 FEET

APPROXIMATE DIAMETER OF WELL

(NEAREST INCH)

## METHOD OF DRILLING USED (CIRCLE APPROPRIATE METHOD)

BORED (OR: AUGURED)JETTEDDRIVEN30-37 AIR-ROTARYAIR-PERCUSSIONROTARY (HYDRAULIC ROTARY)CABLEREVERSE-ROTARYDRIVE-POINT

OTHER (DESCRIBE)

## REPLACEMENT OR DEEPEMED WELLS (CIRCLE APPROPRIATE BOX)

☐ N THIS WELL WILL NOT REPLACE AN EXISTING WELL☐ Y THIS WELL WILL REPLACE A WELL THAT WILL BE ABANDONED AND SEALED☐ S THIS WELL WILL REPLACE A WELL THAT WILL BE USED AS A STANDBY☐ D THIS WELL WILL DEEPEN AN EXISTING WELL  
PERMIT NUMBER OF WELL TO BE REPLACED OR DEEPEMED (IF AVAILABLE)

41

52

## NOT TO BE FILLED IN BY DRILLER (WRA USE ONLY)

APPROPRIATION  
PERMIT NUMBER

54

ENGINEER REVIEW  
DISTRICT NO.

65

FORCE

WRITE  
INITIALS  
IN BOX

CONDITIONS

A E N S G W Q C L U  
70 71 72 73 74 75 76 77 78 79

B 4 CONTINUED

## HEALTH DEPARTMENT APPROVAL

1 2 3 (SEQ. NO.) 6

41 ☐ S STATE HEALTH  
(CIRCLE BOX)

COUNTY NAME

COUNTY NO.

MO. DAY YR.

DATE

APPROVED BY

B 5

SPECIAL CONDITIONS 8-63

(WRA USE ONLY)

1 2 3 (SEQ. NO.) 6

B 3

## LOCATION OF WELL

1 2 3 (SEQ. NO.) 6

COUNTY

8

(DO NOT ABBREVIATE COUNTY NAME)

21

SUBDIVISION

29

42

SECTION

44

46

LOT

48

50

NEAREST TOWN

52

71

MILES FROM TOWN (ENTER 0 IF IN TOWN)

73

76 77 78

B 4

## DIRECTION FROM TOWN

(CIRCLE APPROPRIATE BOX)

1 2 3 (SEQ. NO.) 6

☐ N

NORTH

☐ E

EAST

☐ NE

NORTHEAST

☐ SE

SOUTHEAST

☐ S

SOUTH

☐ W

WEST

☐ NW

NORTHWEST

☐ SW

SOUTHWEST

NEAR WHAT  
ROAD

11

ON WHICH SIDE OF ROAD  
(CIRCLE APPROPRIATE BOX)☐ N☐ S☐ E☐ W

30

DISTANCE FROM ROAD  
(ENTER DISTANCE AND CIRCLE  
APPROPRIATE BOX)

34

37

38 39

DRAW A SKETCH BELOW SHOWING LOCATION OF WELL IN RELATION TO NEARBY TOWN  
ROADS AND STREAMS WITH NORTH IN THE DIRECTION OF THE ARROW, AND GIVE DIS  
TANCE FROM WELL TO NEAREST ROAD JUNCTION OR STREAM CROSSING SHOWN ON THE  
SKETCH. ALSO SHOW, BY MEANS OF AN "X", THE WELL LOCATION IN THE BOX BELOW  
AND THE BOX NUMBER FROM THE WELL LOCATION MAP.

N

↑

↑




# THE FINEST 5+ACRE FARMETTES IN MD. ROMAN RIDGE ESTATES

LOT #	PRICE	LISTING AGENT
1	16,310	WILL SHOW PROPERTY
2	17,814	ON REQUEST AND FURNISH
3	18,301	PLATS, MAPS, LEGAL
4	18,301	DESCRIPTION AND
5	19,311	COVENANTS
6		
7		
8	18,890	
9		
10		
11		
12	17,807	
13	17,821	
14	17,810	
15	18,330	
16	21,374	

FINANCING AVAILABLE

PROTECTIVE COVENANTS IN OFFICE  
SELLER ENCOURAGES COMPANION SHOPPING

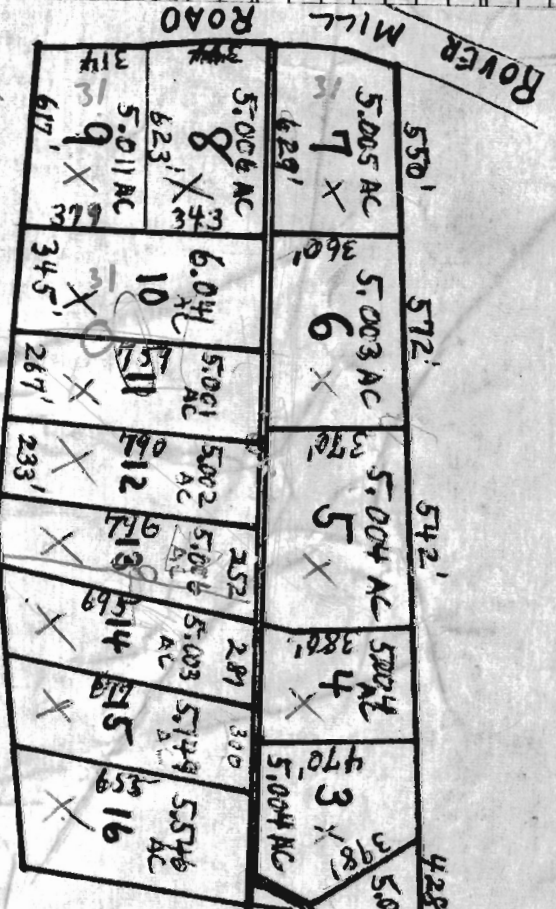

CALL  
**BERNARD ROME**  
665-7700 OR 944-5644  
**RUSSELL T. BAKER & CO., INC.**

