



Building Permit Application

Howard County Maryland
Department of Inspections, Licenses and Permits
3430 Court House Drive
Permits: 410-313-2455
www.howardcountymd.gov

Date Received: _____

Permit No.: B19003654

Building Address: 13304 Ridgewood dr.
City: Ellicott City State: MD Zip Code: 21042
Suite/Apt. #: _____ SDP/WP/BA #: _____
Census Tract: _____ Subdivision: 3001
Section: _____ Area: _____ Lot: 32
Tax Map: 0022 Parcel: 0140 Grid: 0015
Zoning: _____ Map Coordinates: _____ Lot Size: _____

Existing Use: Single family dwelling
Proposed Use: Fuel supply for generator
Estimated Construction Cost: \$ 4500.00
Description of Work: Bury 500 gallon tank and install 40' of gas line from tank to generator.
Occupant/Tenant Name: _____

Was tenant space previously occupied? ☐ Yes ☐ No
Contact Name: _____
Address: _____
City: _____ State: _____ Zip Code: _____
Phone: _____ Fax: _____
Email: _____

Commercial Building Characteristics	Residential Building Characteristics
Height: _____	☐ SF Dwelling ☐ SF Townhouse
No. of stories: _____	Depth _____ Width _____
Gross area, sq. ft./floor: _____	1 st floor: _____
Area of construction (sq. ft.): _____	2 nd floor: _____
Use group: _____	Basement: _____
	☐ Finished Basement
	☐ Unfinished Basement
	☐ Crawl Space
Construction type: _____	☐ Slab on Grade
☐ Reinforced Concrete	No. of Bedrooms: _____
☐ Structural Steel	Multi-family Dwelling
☐ Masonry	No. of efficiency units: _____
☐ Wood Frame	No. of 1 BR units: _____
☐ State Certified Modular	No. of 2 BR units: _____
	No. of 3 BR units: _____
	Other Structure: _____
	Dimensions: _____
Roadside Tree Project Permit	Footings: _____
☐ Yes ☒ No	Roof: _____
Roadside Tree Project Permit # _____	☐ State Certified Modular
	☐ Manufactured Home

Property Owner's Name: Hilton Gluck
Address: 13304 Ridgewood dr.
City: Ellicott City State: MD Zip Code: 21042
Phone: 410 531 9402 Fax: _____
Email: _____

Applicant's Name & Mailing Address, (If other than stated herein)
Applicant's Name: _____
Address: _____
City: _____ State: _____ Zip Code: _____
Phone: _____ Fax: _____
Email: _____

Contractor Company: Suburban Propane
Contact Person: Brent Stubbs
Address: 31 Denwood circle
City: Rockville State: MD Zip Code: 20850
License No.: 782103
Phone: 301 251 0100 Fax: 301 251 0108
Email: bstubbs@suburbanpropane.com

Engineer/Architect Company: _____
Responsible Design Prof.: _____
Address: _____
City: _____ State: _____ Zip Code: _____
Phone: _____ Fax: _____
Email: _____

RECEIVED

Utilities	
Electric: ☐ Yes ☐ No	
Gas: ☐ Yes ☐ No	
Water Supply	OCT 25 2019
☐ Public	
☒ Private	LICENSES & DIVISIONS
Sewage Disposal	
☐ Public	
☒ Private	
Heating System	
☐ Electric ☐ Oil	
☐ Natural Gas ☐ Propane Gas	
☐ Other: _____	
Sprinkler System:	
☐ Yes ☐ No	
Grading Permit Number: _____	
Building Shell Permit Number: _____	

THE UNDERSIGNED HEREBY CERTIFIES AND AGREES AS FOLLOWS: (1) THAT HE/SHE IS AUTHORIZED TO MAKE THIS APPLICATION; (2) THAT THE INFORMATION IS CORRECT; (3) THAT HE/SHE WILL COMPLY WITH ALL REGULATIONS OF HOWARD COUNTY WHICH ARE APPLICABLE THERETO; (4) THAT HE/SHE WILL PERFORM NO WORK ON THE ABOVE REFERENCED PROPERTY NOT SPECIFICALLY DESCRIBED IN THIS APPLICATION; (5) THAT HE/SHE GRANTS COUNTY OFFICIALS THE RIGHT TO ENTER ONTO THIS PROPERTY FOR THE PURPOSE OF INSPECTING THE WORK PERMITTED AND POSTING NOTICES.

Applicant's Signature: Brent Stubbs
Email Address: bstubbs@suburbanpropane.com

Print Name: Brent Stubbs
Date: 10/23/19

Title/Company _____

Checks Payable to: DIRECTOR OF FINANCE OF HOWARD COUNTY

PLEASE WRITE NEATLY & LEGIBLY
-FOR OFFICE USE ONLY-

AGENCY	DATE	SIGNATURE OF APPROVAL
State Highways		
Building Officials		
PSZA (Zoning)		
PSZA (Engineering)		
Health	11/4/19	RKF

Is Sediment Control approval required for issuance? ☐ Yes ☐ No
☐ CONTINGENCY CONSTRUCTION START

DPZ SETBACK INFORMATION
Front: _____
Rear: _____
Side: _____
Side St.: _____
All minimum setbacks met? ☐ Yes ☐ No
Is Entrance Permit Required? ☐ Yes ☐ No
Historic District? ☐ Yes ☐ No
Lot Coverage for New Town Zone: _____
SDP/Red-line approval date: _____

Filing Fee	\$	11000
Permit Fee	\$	
Tech Fee	\$	
Excise Tax	\$	
PSFS	\$	
Guaranty Fund	\$	
Add'l per Fee	\$	
Total Fees	\$	
Sub- Total Paid	\$	
Balance Due	\$	
Check	#	17-670010931

Distribution of Copies: White: Building Officials Green: PSZA, Zoning


Yellow: PSZA, Engineering

Pink: Health

Gold: SHA

Property known as: LOT 32
 RIDGEWOOD, LOTS 1 THRU 32
 PLAT # 8089 SHEET 3 of 5
 5TH ELECTION DISTRICT
 HOWARD COUNTY, MD.

THIS PLAT CAN NOT BE USED TO ESTABLISH PROPERTY
 LINES OR CORNERS.

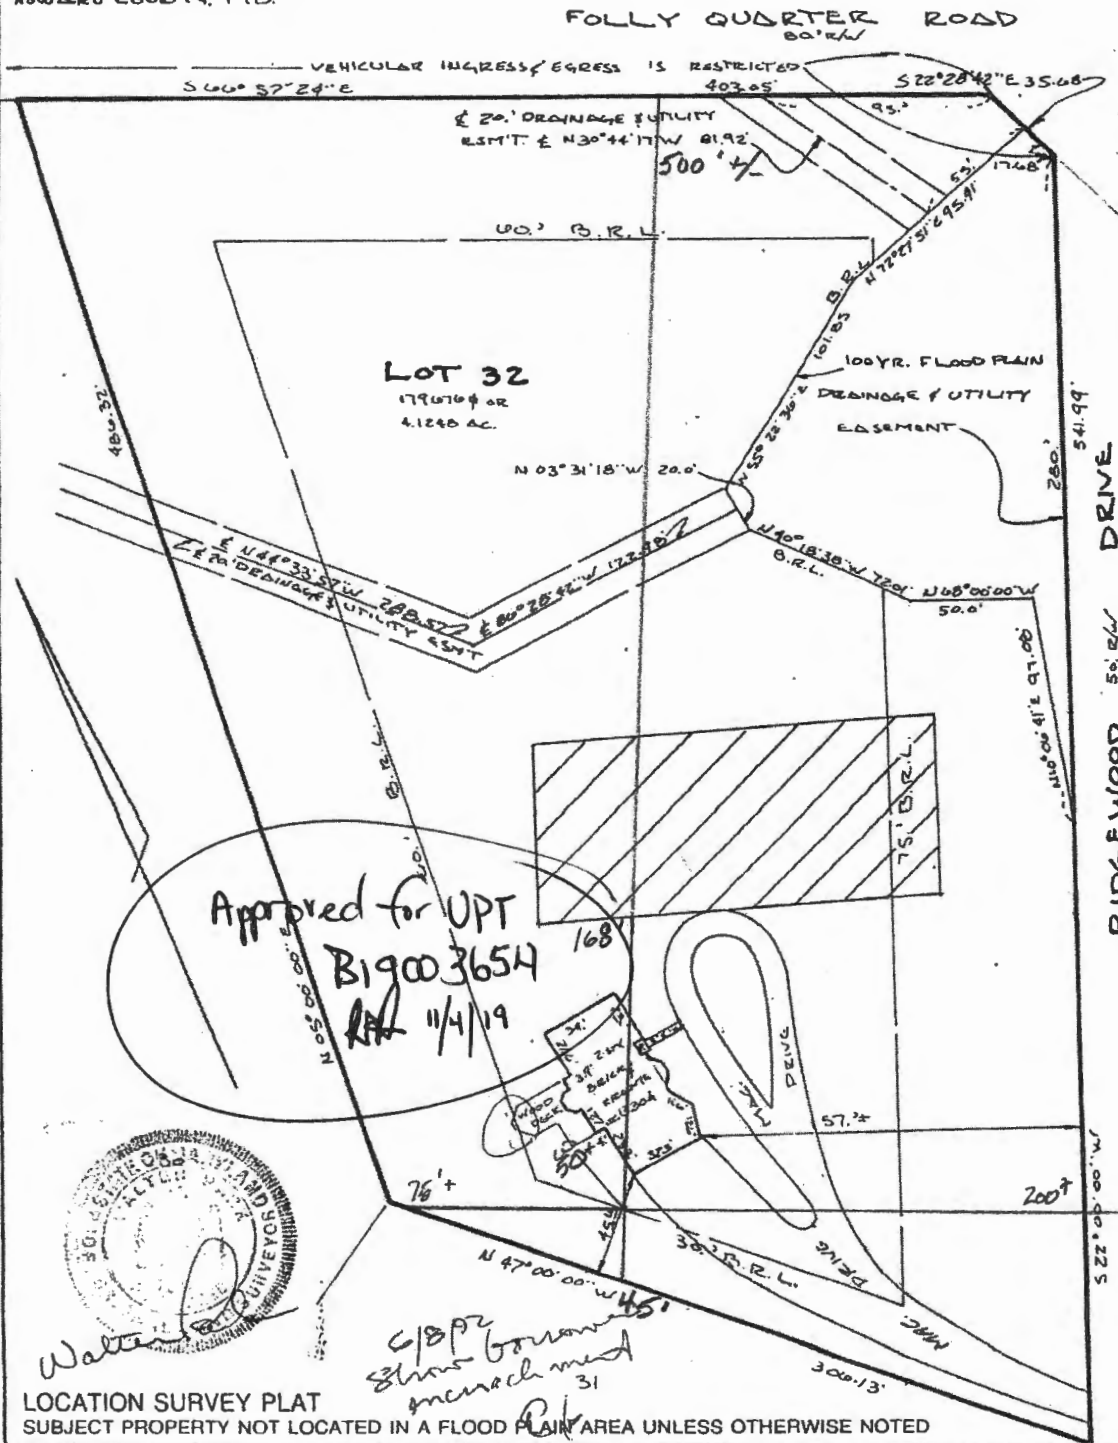

CERTIFICATION	SEAL	SCALE 1" = 60' DATE 6-7-1992
This is to certify that I have surveyed the property known as: <u>13304</u> <u>RIDGEWOOD DRIVE</u> for the purpose of locating the improvements thereon, and the improvements are located as shown.	Walter Par	LAND DESIGN ENGINEERING, INC. SUITE 210 10620 GUILFORD ROAD JESSUP, MARYLAND 20794 880-0034 (BALT) 604-6264 (WASH) 604-6735 (FAX)

10604

THANK TO WELL 50' THANK TO HOUSE 35'