

Health



DILP 2019 NOV 21 PM 12:10

Building Permit Application

Howard County Maryland
Department of Inspections, Licenses and Permits
3430 Court House Drive
Permits: 410-313-2455
www.howardcountymd.gov

Date Received: _____

Permit No.: **B19004015**

Building Address: **114831 Roxbury Rd**
City: **Glenridge** State: **MD** Zip Code: **21737**
Suite/Apt. #: _____ SDP/WP/BA #: _____
Subdivision: _____
Lot: _____ Tax Map: _____ Parcel: _____

Existing Use: **Single family**
Proposed Use: **finished Basement**
Estimated Construction Cost: **\$105,000**

Description of Work:
Bedroom, full new Bathroom, storage room, kitchen, no stove, fireplace

Occupant/Tenant Name: _____
Was tenant space previously occupied? ☐ Yes ☐ No
Contact Name: _____
Address: _____
City: _____ State: _____ Zip Code: _____
Phone: _____ Fax: _____
Email: _____

Property Owner's Name: **Mahmoud Djavan**
Address: **114831 Roxbury Rd**
City: **Glenridge** State: **MD** Zip Code: **21737**
Phone: **410-882-5879** Fax: _____
Email: **djavanib@gmail.com**

Applicant's Name & Mailing Address, (Other than stated herein)
Applicant's Name: **Mahmoud Djavan**
Address: **Same as above**
City: _____ State: _____ Zip Code: _____
Phone: _____ Fax: _____
Email: _____

Contractor Company: **Mizan General Const.**
Contact Person: **Sayed M. Ali**
Address: **8519 HeatThrow Court**
City: **National** State: **MD** Zip Code: **21236**
License No.: **136998**
Phone: **443-600-2503** Fax: _____
Email: _____

Engineer/Architect Company: _____
Responsible Design Prof.: _____
Address: _____
City: _____ State: _____ Zip Code: _____
Phone: _____ Fax: _____
Email: _____

Commercial Building Characteristics	Residential Building Characteristics
Height: 9' 5"	☒ SF Dwelling ☐ SF Townhouse
No. of stories: 2	Depth: _____ Width: _____
Gross area, sq. ft./floor: _____	1st floor: ☒ 2nd floor: ☒
Area of construction (sq. ft.): 1200	Basement: ☐ Finished Basement ☐ Unfinished Basement
Use group: _____	☐ Crawl Space ☐ Slab on Grade
Construction type: ☐ Reinforced Concrete ☐ Structural Steel ☐ Masonry ☒ Wood Frame ☐ State Certified Modular	No. of Bedrooms: _____ Multi-family Dwelling No. of efficiency units: _____ No. of 1 BR units: _____ No. of 2 BR units: X No. of 3 BR units: _____ Other Structure: _____ Dimensions: _____ Footings: _____ Roof: _____ ☐ State Certified Modular ☐ Manufactured Home
☒ Roadside Tree Project Permit ☐ Yes ☐ No	
☒ Roadside Tree Project Permit # _____	

Utilities
Electric: ☐ Yes ☐ No
Gas: ☐ Yes ☐ No
Water Supply: ☐ Public ☒ Private
Sewage Disposal: ☐ Public ☒ Private
Heating System: ☐ Electric ☐ Oil ☒ Natural Gas ☐ Propane Gas ☐ Other: _____
Sprinkler System: ☐ Yes ☒ No
Grading Permit Number: _____
Building Shell Permit Number: _____

THE UNDERSIGNED HEREBY CERTIFIES AND AGREES AS FOLLOWS: (1) THAT HE/SHE IS AUTHORIZED TO MAKE THIS APPLICATION; (2) THAT THE INFORMATION IS CORRECT; (3) THAT HE/SHE WILL COMPLY WITH ALL REGULATIONS OF HOWARD COUNTY WHICH ARE APPLICABLE THERETO; (4) THAT HE/SHE WILL PERFORM NO WORK ON THE ABOVE REFERENCED PROPERTY NOT SPECIFICALLY DESCRIBED IN THIS APPLICATION; (5) THAT HE/SHE GRANTS COUNTY OFFICIALS THE RIGHT TO ENTER ONTO THIS PROPERTY FOR THE PURPOSE OF INSPECTING THE WORK PERMITTED AND POSTING NOTICES.

Applicant's Signature: **Mahmoud Djavan** Print Name: **Mahmoud Djavan**
Email Address: **djavanib@gmail.com** Date: **NOV. 21/2019**
Title/Company: _____

Checks Payable to: DIRECTOR OF FINANCE OF HOWARD COUNTY

PLEASE WRITE NEATLY & LEGIBLY
-FOR OFFICE USE ONLY-

AGENCY	DATE	SIGNATURE OF APPROVAL
State Highways		
Building Officials		
PSZA (Zoning)		
PSZA (Engineering)		
Health		

DPZ SETBACK INFORMATION

Front: _____
Rear: _____
Side: _____
Side St.: _____
All minimum setbacks met? ☐ Yes ☐ No
Is Entrance Permit Required? ☐ Yes ☐ No
Historic District? ☐ Yes ☐ No
Lot Coverage for New Town Zone: _____
SDP/Red-line approval date: _____

Filing Fee	\$	135.00
Permit Fee	\$	
Tech Fee	\$	
Excise Tax	\$	
PSFS	\$	
Guaranty Fund	\$	
Add'l per Fee	\$	
Total Fees	\$	
Sub-Total Paid	\$	
Balance Due	\$	
Check	#	1004

Distribution of Copies: White: Building Officials Green: PSZA,Zoning Yellow: PSZA,Engineering Pink: Health Gold: SHA

T:\Operations\Updated Forms\BuildingPermitApplication03.29.2018.docx

9/11

Menu Save Reset Cancel Help

Record Detail * (This section is required.)

Permit Type	Permit Number	Opened Date
Building/Residential/Alteration/SFD	B19004015	11/21/2019
Description of Work		
SFD/FINISH BASEMENT FOR 1 BEDROOM, 1FB, STORAGE ROOM, KITCHEN (NO STOVE), 1 FP, 1200 SQ. FT.		

[check spelling](#)

Address * (This section is required.)

Search Reset Clear Get Parcel & Owner

Street #	Street Name	Street Type
14831	ROXBURY	RD
Unit Type	Unit #	X Coordinate
--Select--		-77.02763
		Y Coordinate
		39.25293
City	State	Zip Code
GLENELG	MD	21737
		Primary
		Yes

Parcel * (This section is required.)

Search Reset Clear Get Address & Owner

GIS ID *	Parcel	Parcel Area	Land Value	Improved Value	Exemption Value	Plan Area
889725	58	1.36	203600	665700	462100	RURAL
Legal Description						
IMPSLOT 1 1.3609 A.[]14831 ROXBURY ROAD SS[]FROSTY PINES						

[check spelling](#)

Block	Lot	Census Tract	Council Dist	Inspection Dist	Supervisor Dist	Map #	DAP Zone
	1	605601	5				
Plan Area	State Tax Id	Subdivision Name					
	1404365046	FROSTY PINES					
Section	Area	Tax Map					
		21					
Grid	Zoning District	ADC Map					
21-22	RC-DEO	4812-F10					
SDP No.	Final Plan No.	WP File No.	Primary				
			Yes				
Record Plat No.	WS Contract No.	FDP No.					
14554							
Owner Occupied	Year Built	Historic District					
☐ Yes ☐ No	2011	☐ Yes ☒ No					
Historic District Registry No.	Stat Area	Flood Plain					
	4-09	☐ Yes ☒ No					

Building No

Owner (This section is not required.)

Search

Reset

Clear

Name *

MAHMOUD DJAVANI

Address Line 1

14831 ROXBURY ROAD

Address Line 2

Address Line 3

Mail City

GLENELG

Mail State

MD

Mail Zip Code

21737

Phone

410-882-5879

Primary

Yes

E-mail

DJAVANI@GMAIL.COM

Cell Number

Fax Number

Professionals (This section is not required.)

Search

Reset

Clear

License # *

08050136998

Business Name

MIZAN GENERAL CONSTRUCTION INC

License Type *

MHIC Co

First Name

SYED

Middle Name

Last Name

ALI

Primary

Yes

Address Line 1

8519 HEATHROW COURT C

Address Line 2

City

BALTIMORE

State

MD

ZIP Code

21236-0000

Phone 1

3476135205

Phone 2

Fax

0000000000

E-mail

MASHADAL1@YAHOO.COM

Applicant (This section is not required.)

Search

As Owner

As Lic. Prof

As Contact

Type *

Applicant

First Name

MAHMOUD

MI

Last Name

DJAVANI

Relationship

Applicant

Full Name

MAHMOUD DJAVANI

Primary

No

Organization Name

Street Address

14831 ROXBURY ROAD

Address Line 2

City	State	Zip Code
GLENELG	MD	21737
Phone	Cell	Fax
410-882-5879		
E-mail *		
DJAVANI@GMAIL.COM		

Contact (This section is not required.)

Search As Owner As Lic. Prof As Contact

Type	First Name	MI	Last Name
Contact	MAHMOUD		DJAVANI
Relationship	Full Name		
Owner	MAHMOUD DJAVANI		
Primary	Organization Name		
Yes			
Street Address			
14831 ROXBURY ROAD			
Address Line 2			
City	State	Zip Code	
GLENELG	MD	21737	
Phone	Cell	Fax	
410-882-5879			
E-mail			
DJAVANI@GMAIL.COM			

Addtl Info

Est Construction Cost *	Housing Units *	Number of Buildings *	Public Owned
85000	0	0	No
Construction Type			
434 - Additions, Alterations and Conversions - Residential			

RESIDENTIAL ALTERATION INFO

RESIDENTIAL ALTERATION INFORMATION

Total Square Footage *	Bedrooms	Full Baths	Half Baths	Water *	Sewage *	Existing Utilities *
1200 SQFT	1	1		Private	Private	Electric
Existing Heating System *	Existing Sprinkler System *	Type of New Fireplace	Expiration Date	Fee Exempt *		
Propane Gas	None	Prefab	5/25/2020	Yes No		

PAYMENT INFORMATION

Check 1	Payee 1	Check 2	Payee 2	SAP Doc No	SAP Entered

Submit Cancel

**COMPLETE THIS FORM WHEN DROPPING OFF ANY
CORRESPONDENCE AND/OR PLANS TO THE HOWARD COUNTY
DEPARTMENT OF INSPECTIONS, LICENSES AND PERMITS COUNTER:**

Date: 11/27/19

To: Ms. Debbie Whalen (Building Review)
(Person's Name and Division)

From: mahmoud Djavani (410) 419-6647
(Your Name, Company Name and Telephone Number)

Subject: Project name _____
Project site address 14831 Roxbury Rd, Glenelg MD 21737
Permit # B19004015 SDP # _____
Other information pertinent to this project _____

RECEIVED
NOV 27 2019
PLAN REVIEW DIVISION

☒ Please check the attachments below that you are submitting with this transmittal:

- ☒ Letter of response to address plan review comment letter
- _____ Revised plans and/or revised details: When submitting for a complete re-review, **duplicate sets shall be submitted.**
- _____ Letter Summarizing Changes
- _____ Energy conservation calculations
- _____ Copies of _____ (be specific).
- _____ Health Department Request _____ DPZ/ DED Request _____ Applicant's Request
- _____ Two sets of single family dwelling model plans to be placed on permanent file: Model name and/or # _____
- _____ Other _____

Contact Person Information: (Required)

mahmoud Djavani
Please Print Name

Telephone No: 410-419-6647
E-Mail Address: djavani@mail.com

PLEASE ASSURE ALL DOCUMENTS AND/OR REVISIONS ARE APPROPRIATELY SIGNED AND SEALED, IF NECESSARY, BY A LICENSED ARCHITECT OR ENGINEER. PLEASE BE ADVISED THAT INSUFFICIENT INFORMATION MAY RESULT IN THE DELAY OF REVIEW BY THE PLANS EXAMINER. THE DEPARTMENT OF INSPECTIONS, LICENSES AND PERMITS WILL CONTACT YOU IF THERE IS A PROBLEM. IN ADDITION, ONCE THE BUILDING PERMIT IS APPROVED BY THE PLAN REVIEW DIVISION AND ALL OTHER REQUIRED SIGNATORY AGENCIES, AND THE BUILDING PERMIT IS READY FOR ISSUANCE, THE PERMIT DIVISION WILL NOTIFY THE APPROPRIATE CONTACT PERSON FOR PERMIT PICK UP. ALL PERMIT STATUS INQUIRIES SHALL BE DIRECTED TO THE PERMIT DIVISION AT 410-313-2455. CODE RELATED QUESTIONS AND PLAN REVIEW INQUIRIES SHALL BE DIRECTED TO THE PLAN REVIEW DIVISION AT 410-313-2436. PLEASE ALLOW A MINIMUM OF FIVE (5) WORKING DAYS FOR ANY PLAN SUBMITTALS TO BE REVIEWED. THANK YOU.

Received by 

White-Plan Review / Yellow-Applicant / Pink-Permit Division
t:\Operations\Updated forms\transmit.frm - Rev. 04/2014

RECEIVED
NOV 27 2019

LICENSES & PERMITS
DIVISION


Heath
1 gr
Rev. to fee

14'


Storage

10'

Full Bath

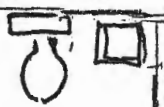

Unfinished mechanic/laundry

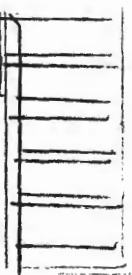

Kitchenette
(no stove)

Sink

2000
Approved Septic System Plan
Howard County Health Department
Finish Basement as Illustrated
of Family Run, Bed room, Kitchen (w/ stove)
Full bath and unfinished storage and laundry room

Signature
B19004015
14031 Roxbury Rd.

existing ex

ex

Fireplace

48x60
existing

Bedroom

Elec. Panel

Double door CL



20'

12'

Well


Pump
monitor

CL



Roxbury Whole House Floor Plan:

#4831 Roxbury Rd.
B19004015

UPPER FLOOR

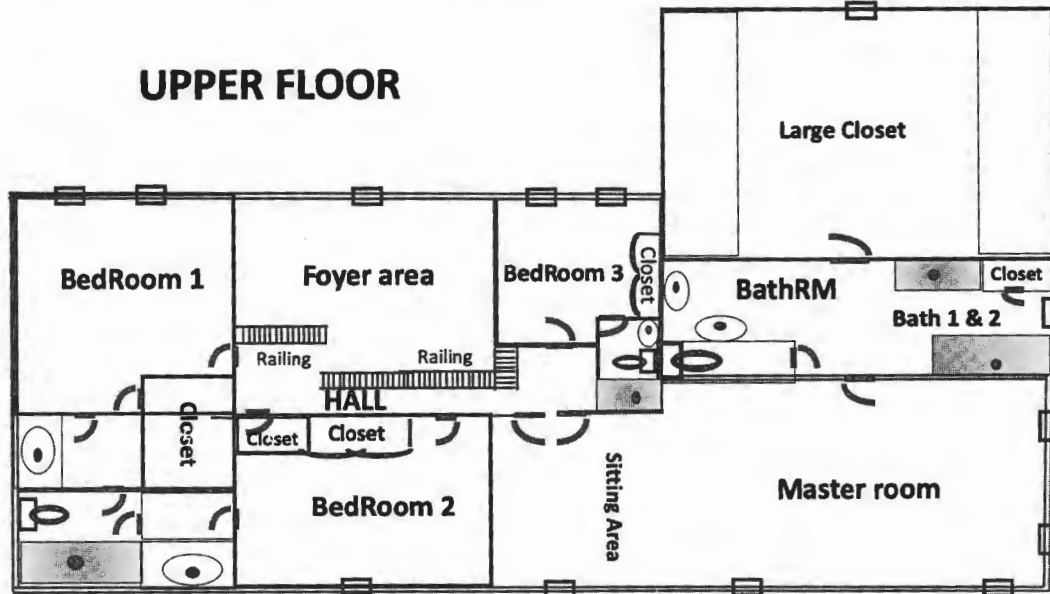

MAIN FLOOR

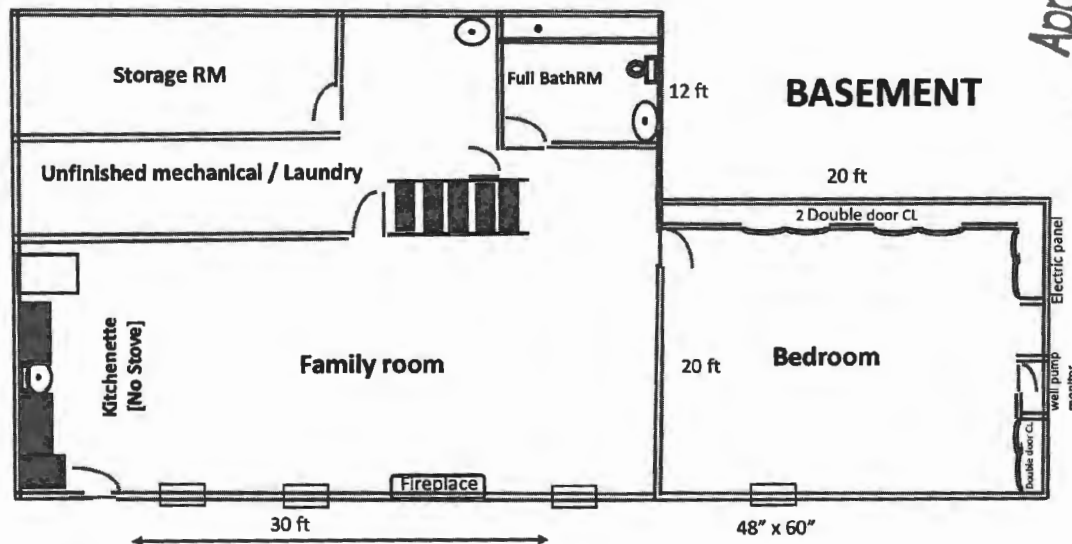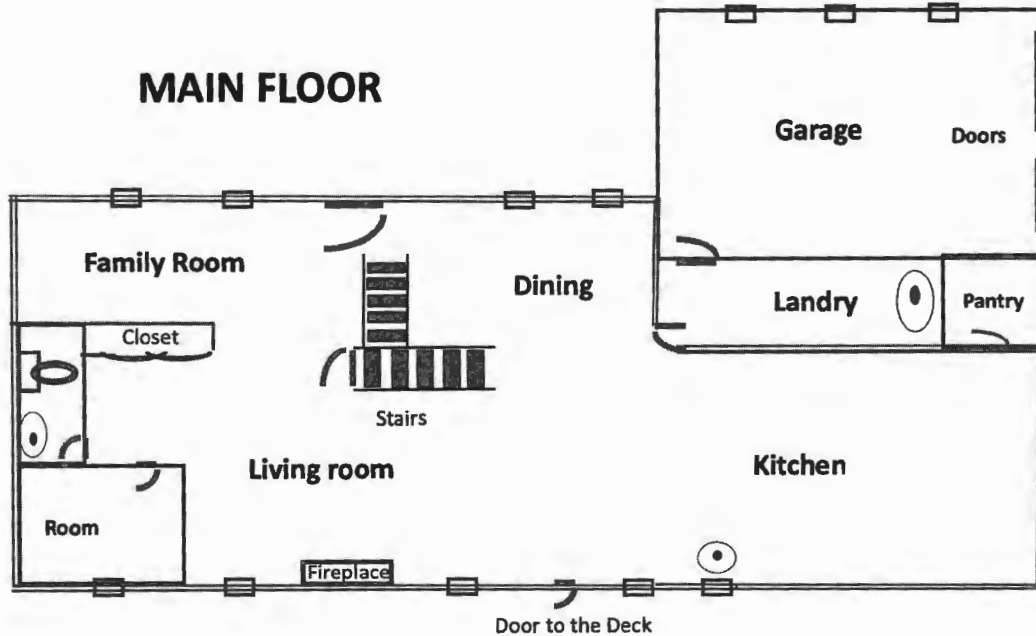

Approved Septic System Plan
Howard County Health Department
Finished Basement approved
Septic system has adequate
capacity for 6 bedrooms
12/15/19
Signature