



Howard County Health Department

Bureau of Environmental Health

8930 Stanford Boulevard, Columbia, MD 21045

Main: 410-313-2640 | Fax: 410-313-2648

TDD 410-313-2323 | Toll Free 1-866-313-6300

www.hchealth.org

Facebook: www.facebook.com/hocohealth

Maura J. Rossman, M.D., Health Officer

RECEIPT DATE: 7/22/19

ONSITE SEWAGE DISPOSAL SYSTEM

P 565562

APPROVAL DATE: _____

PERMIT:

REPAIR

A Upgrade

PROPERTY ADDRESS: 2445 Sand Hill

SUBDIVISION: _____

LOT: _____

TAX ID: _____

CONTRACTOR: Fogle's Septic Clean Inc.

EMAIL: Kurt@foglesinc.com

CONTRACTOR ADDRESS: 580 Obrecht Road Sykesville, MD 21784

PHONE: 410-795-5670

PROPERTY OWNER: _____

EMAIL: _____

OWNER ADDRESS: _____

PHONE: _____

SEPTIC TANK SIZE: 2000

PUMP TANK CAPACITY: n/a

PUMP SIZE: n/a

DISTRIBUTION SYSTEM: ☒ GRAVITY

☐ PRESSURE DOSED

BEDROOMS: 4

APPLICATION RATE: 0.8

TRENCHES:

LINEAR FEET REQUIRED: n/a

INLET DEPTH: n/a

TRENCH WIDTH: n/a

MAXIMUM BOTTOM DEPTH: n/a

MINIMUM SPACE

BETWEEN TRENCHES: n/a

EFFECTIVE AREA BEGINNING DEPTH: n/a

LOCATION:

TO BE STAKED BY SANITARIAN DURING PRE-CONSTRUCTION INSPECTION.

NOTES:

Install new 2000g septic tank outside of 100 ft well arc. Just below existing septic tank. Pump and collapse the existing tank. Call for inspection

File missing @ time of inspection

ISSUED BY: K. Wolf (for Spencer Freemon)

ISSUE DATE: 7/22/19

EXPIRATION DATE: 7/22/2020

NOTE: CONTRACTOR MUST SCHEDULE A PRE-CONSTRUCTION INSPECTION PRIOR TO BEGINNING ANY INSTALLATION

NOTE: CONTRACTOR MUST SCHEDULE AN INSPECTION AND GAIN APPROVAL OF ALL COMPONENTS PRIOR TO COVERING

NOTE: STONE MUST BE APPROVED BY HEALTH DEPARTMENT AND GRAVEL TICKET MUST BE AVAILABLE FOR REVIEW.

NOTE: WATERTIGHT SEPTIC TANKS REQUIRED

NOTE: ALL PARTS OF SEPTIC SYSTEM SHALL BE AT LEAST 100 FEET DOWNGRAIENT FROM ANY WATER WELL

NOTE: MANHOLE RISERS REQUIRED ON ALL SEPTIC TANKS AND PUMP CHAMBERS

NOTE: AN ELECTRICAL PERMIT IS REQUIRED FOR INSTALLATION OF ANY ELECTRICAL COMPONENTS OF THE SYSTEM

☒ ELECTRICAL PERMIT ISSUED E n/a

NOTE: THE HCHD DOES NOT WARRANTY ANY SYSTEM AND CANNOT GUARANTEE THE PERFORMANCE OF THIS SYSTEM AS DESIGNED. BY ACCEPTING THIS PERMIT, THE OWNER AND/OR APPLICANT ACKNOWLEDGE THAT THE SPECIFICATIONS DETAILED IN THIS DESIGN ARE ONE POSSIBLE OPTION AND THAT THE HCHD WILL REVIEW OTHER PROPOSALS. YOU HAVE THE OPTION TO SEEK THE ADVICE OF A QUALIFIED DESIGN CONSULTANT OR PROFESSIONAL ENGINEER FOR FURTHER GUIDANCE.

NOTE: AN INDIVIDUAL CERTIFIED BY MDE AND THE MANUFACTURER FOR BAT INSTALLATION MUST BE PRESENT AT ALL TIMES DURING BAT INSTALLATION.


NOTE: MDE RECOMMENDS SEPTIC TANKS, BAT, AND OTHER PRETREATMENT UNITS BE PUMPED AT A FREQUENCY ADEQUATE TO ENSURE THAT SOLIDS ARE NOT DISCHARGED TO THE DISPOSAL AREA

NEITHER THE HOWARD COUNTY COUNCIL NOR THE HEALTH DEPARTMENT IS RESPONSIBLE FOR THE SUCCESSFUL OPERATION OF ANY SYSTEM.

PERMITTEE RESPONSIBLE FOR OBTAINING FINAL APPROVAL ON THIS PERMIT.

CALL 410-313-1771 TO SCHEDULE INSPECTIONS.

NOT TO SCALE

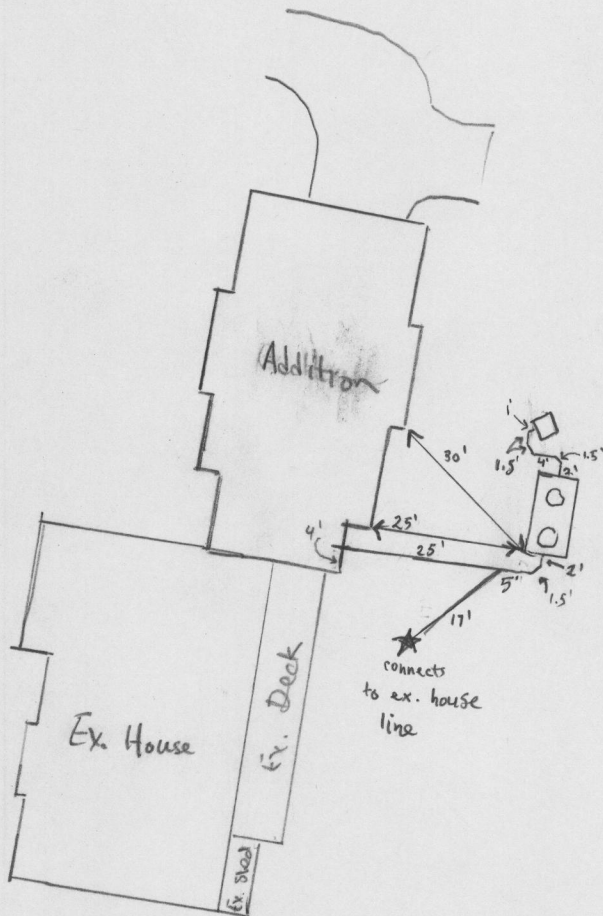

ROAD NAME

TRENCH/DRAINFIELD DATA

WIDTH _____ INLET _____ BOTTOM _____
NUMBER OF TRENCHES _____
TOTAL LENGTH _____
ABSORPTION AREA _____
DISTRIBUTION BOX LEVEL _____
DISTRIBUTION BOX BAFFLE _____
DISTRIBUTION BOX PORT _____

SEPTIC TANK DATA

SEPTIC TANK 1 LEVEL yes
MANUFACTURER Babylon
CAPACITY 2000 GAL
SEAM LOC top
TANK LID DEPTH 3'
BAFFLES front and back
BAFFLE FILTER -
MANHOLE LOC front + back
6" PORT LOC -
WATERTIGHT TEST -
SLOTTED yes
DATE ON LID 9-19-19

PUMP/SEPTIC TANK LEVEL N/A

MANUFACTURER _____
CAPACITY _____ GAL
SEAM LOC _____
TANK LID DEPTH _____
BAFFLES _____
BAFFLE FILTER _____
MANHOLE LOC _____
6" PORT LOC _____
WATERTIGHT TEST _____
SLOTTED _____
DATE ON LID _____

PRE-CONSTRUCTION:

10/22/19 met w/ contractor on site. OK to set new 2000 gal. ST. next to ex. ST. Call for inspection (Kou)

INSTALLATION: 10/25/19 Tank set and SHC made to new addition. Connected to existing house's sewer line via Y connection. New tank connected to old d-box. (ST)

FINAL INSPECTOR

Jason Thomas

DATE OF APPROVAL

10/25/19



HOWARD COUNTY HEALTH DEPARTMENT

65562

7/26/19

DATE

Received From

PHONE #

For

☐ CASH

☒ CHECK

NO.

65114

Dollars

\$

396.00

Received By

Heck