

MARYLAND DEPARTMENT OF THE ENVIRONMENT, WATER MANAGEMENT ADMINISTRATION
1800 Washington Blvd., Baltimore, Maryland 21230 (410) 537-3784

WATER WELL ABANDONMENT-SEALING REPORT FORM

SUBMIT COPIES OF COMPLETED FORM TO:

- * COUNTY ENVIRONMENTAL AGENCY (contact MDE, WMA if address needed)
- * WELL OWNER
- * MDE, WATER MANAGEMENT ADMINISTRATION, WELL PROGRAM

Approved
12/31/2019

DATE WELL ABANDONED: 11-19-19 (month/day/year)

* PERMIT NUMBER OF ABANDONED WELL (if any)

N/A

* PERMIT NUMBER OF REPLACEMENT WELL:


* PERSON ABANDONING WELL: Andrew Houseman WELL DRILLER'S LICENSE NUMBER: 224

CIRCLE: MWD MSD MGD

* OWNER'S NAME: Trinity Homes

SITE LOCATION MAP

* WELL LOCATION:
COUNTY: Howard
NEAREST TOWN: Laurel
TAX MAP 0050 BLOCK 0002 PARCEL 0428
SUBDIVISION: Gen Cooper
SECTION: 10 LOT: 10
STREET ADDRESS: 10029 Superior Ave

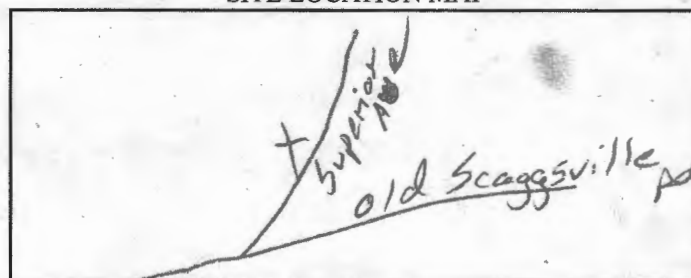

LATITUDE 3 9.113005

LONGITUDE 7 6.85862

LOG OF SEALING MATERIAL

MATERIAL	FEET	
	FROM	TO
Stone	12	6
Concrete	6	1
email confirm filling to grade. @		
VOLUME OF MATERIAL USED		
Stone 3yds 2.5yds		

* TYPE OF WELL BEING ABANDONED:

DRILLED JETTED
BORED HAND DUG
OTHER (specify)

* USE CODE:

DOMESTIC MUNICIPAL/PUBLIC
IRRIGATION INDUSTRIAL
TEST/OBSERVATION GEOTHERMAL

* TYPE OF CASING:

STEEL PLASTIC
CONCRETE OTHER (specify)

SIZE OF CASING: 12 INCHES IN DIAMETER

DEPTH OF WELL: 12 FEET DEEP

WAS ANY CASING REMOVED? YES NO

If yes, length removed, in feet: 1

WAS CASING RIPPED OR PERFORATED? YES NO

SIGNATURE-MASTER WELL DRILLER OR SUPERVISING SANITARIAN LICENSE#

Andrew Houseman

224

MWD MSD MGS

CIRCLE ONE

DATE

11-21-19

COUNTY

Pursuant to § 10-624 of the State Govt. Article of the Maryland Code, personal info requested on this form is used in processing this form pursuant to COMAR 26.04.04. Failure to provide the info may result in this form not being processed. You have the right to inspect, amend, or correct this form. The Maryland Department of the Environment is subject to the Maryland Public Information Act. This form may be made available on the Internet via MDE's website and is subject to inspection or copying, in whole or in part, by the public and other governmental agencies, if not protected by federal or State Law.

Cabahug, Joseph

From: Theresa Miller <Theresa@foglesinc.com>
Sent: Tuesday, December 31, 2019 9:34 AM
To: Cabahug, Joseph
Subject: RE: 10029 Superior Ave_Well Abandonment_Hand Dug

[Note: This email originated from outside of the organization. Please only click on links or attachments if you know the sender.]

Good morning! Andy said yes they did.

From: Cabahug, Joseph [mailto:jcabahug@howardcountymd.gov]
Sent: Tuesday, December 31, 2019 8:55 AM
To: Theresa Miller <Theresa@foglesinc.com>
Subject: 10029 Superior Ave_Well Abandonment_Hand Dug

Hello Theresa,

I see in this abandonment report for 10029 Superior Avenue. It is reported that stone was used from 12-6', and then concrete was used from 6-1'. Did they fill it to grade?

Thanks,

Joseph C. Cabahug - LEHS
Environmental Health Specialist
Howard County Health Department - Well & Septic Program
Bureau of Environmental Health
8930 Stanford Blvd.
Columbia, MD 21045
(o) 410-313-2643
(f) 410-313-2648



jcabahug@howardcountymd.gov

CONFIDENTIALITY NOTICE

This message and the accompanying documents are intended only for the use of the individual or entity to which they are addressed and may contain information that is privileged, confidential, or exempt from disclosure under applicable law. If the reader of this email is not the intended recipient, you are hereby notified that you are strictly prohibited from reading, disseminating, distributing, or copying this communication. If you have received this email in error, please notify the sender immediately and destroy the original transmission