



# APPLICATION

## FOR PERCOLATION TESTING AND SITE EVALUATION

TEST DATE(S) \_\_\_\_\_ TEST TIME \_\_\_\_\_

AP 555310-K

AGENCY REVIEW: \_\_\_\_\_

DATE 11-12-14

DO NOT WRITE ABOVE THIS LINE

I HEREBY APPLY FOR THE NECESSARY TESTING/EVALUATION PRIOR TO ISSUANCE OF SEWAGE DISPOSAL SYSTEM PERMIT(S) TO:

CHECK AS NEEDED:

- ☒ CONSTRUCT NEW SEPTIC SYSTEM(S)  
☐ REPAIR/ADD TO AN EXISTING SEPTIC SYSTEM  
☐ REPLACE AN EXISTING SEPTIC SYSTEM

CHECK AS NEEDED:

- ☒ NEW STRUCTURE(S)  
☐ ADDITION TO AN EXISTING STRUCTURE  
☐ REPLACE AN EXISTING STRUCTURE

CHECK ONE:

- ☒ CREATE NEW LOT(S)  
☐ BUILD ON AN EXISTING LOT IN A SUBDIVISION  
☐ BUILD ON AN EXISTING PARCEL OF RECORD

IS THE PROPERTY WITHIN 2500' OF ANY RESERVOIR?

- ☐ YES  
☒ NO

THE TYPE OF STRUCTURE IS:

- ☒ RESIDENTIAL WITH 4-5 PROPOSED BEDROOMS IN THE COMPLETED STRUCTURE (NOTE **UNKNOWN** IF APPROPRIATE)  
☐ COMMERCIAL (PROVIDE DETAIL OF NUMBERS AND TYPES OF EMPLOYEES/ CUSTOMERS ON ACCOMPANYING PLAN)  
☐ INSTITUTIONAL/GOVERNMENT (PROVIDE DETAIL OF NUMBERS AND TYPES OF EMPLOYEES/USERS ON ACCOMPANYING PLAN)

PROPERTY OWNER(S) THE WILBUR AND EVELYN HINKLE FAMILY LIMITED PARTNERSHIP (ATTN: PHILLIP HINKLE)

DAYTIME PHONE \_\_\_\_\_ CELL 443-864-7470 FAX 410-223-4341

MAILING ADDRESS 13915 KENNARD ROAD GLENELG MD 21737  
STREET CITY/TOWN STATE ZIP

APPLICANT WILLIAMSBURG GROUP LLC, BOB CORBETT

DAYTIME PHONE \_\_\_\_\_ CELL 410-977-3343 FAX 410-997-4358

MAILING ADDRESS 5485 HARPERS FARM RD #200 COLUMBIA, MD 21044  
STREET CITY/TOWN STATE ZIP

APPLICANT'S ROLE: DEVELOPER BUILDER BUYER RELATIVE/FRIEND REALTOR CONSULTANT

PROPERTY LOCATION  
SUBDIVISION/PROPERTY NAME HINKLE PROPERTY LOT NO. 93-9

PROPERTY ADDRESS 12545 SCAGGSVILLE RD HIGHLAND MD  
STREET TOWN/POST OFFICE

TAX MAP PAGE(S) 40 GRID \_\_\_\_\_ PARCEL(S) 93 PROPOSED LOT SIZE 50,000-60,000 SF  
1 AC +/-

AS APPLICANT, I UNDERSTAND THE FOLLOWING: THE SYSTEM INSTALLED SUBSEQUENT TO THIS APPLICATION IS ACCEPTABLE ONLY UNTIL PUBLIC SEWERAGE IS AVAILABLE. THIS APPLICATION IS COMPLETE WHEN ALL APPLICABLE FEES AND A SUITABLE SITE PLAN HAVE BEEN RECEIVED. I ACCEPT THE RESPONSIBILITY FOR COMPLIANCE WITH ALL M.O.S.H.A. AND "MISS UTILITY" REQUIREMENTS. APPROVAL IS BASED UPON SATISFACTORY REVIEW OF A PERC CERTIFICATION PLAN.

TEST RESULTS WILL BE MAILED TO APPLICANT.

SIGNATURE OF APPLICANT

HOWARD COUNTY HEALTH DEPARTMENT, BUREAU OF ENVIRONMENTAL HEALTH, WELL AND SEPTIC PROGRAM  
7178 COLUMBIA GATEWAY DRIVE COLUMBIA, MARYLAND 21046 (410) 313-2640 FAX (410) 313-2648  
TDD (410) 313-2323 TOLL FREE 1-877-4MD-DHMH

# Proposed lot 12 9

AVP

(12K)

1' dk brn L, 2f sbk  
brn L, thick platy  
red-brn cos  
2' 1msbk, mica  
red-yel ls  
3' thick platy  
red-yel &  
very pale brn ls  
3.8' 0m, brittle  
red-yel, dk brn  
& very pale brn ls  
13' s.g. water

(12G)

1' dk brn L to  
yel-brn L, 2f sbk, ss  
red-brn L, 2f sbk  
red-yel & brn sl  
thick platy  
many mica

(12J)

1' dk brn L, 3f sbk  
brn L, 3msbk  
yel-red & red-yel  
5' many mica  
thick platy

(12J)

1' dk brn L, 3f sbk  
brn L, 3msbk  
yel-red & red-yel  
5' many mica  
thick platy

North

12F

13G

13K

13J

12G

12K

12J

12H

(12F)

1' dk brn L, 2f sbk  
yel-brn L, 2msbk  
yel-red L, 2f sbk, ss  
2' 2csbk, ss  
red-yel L, ss  
2' 1msbk, ss  
common mica  
3' red-yel fs  
thick platy, ss  
5' red-yel  
pale brn ls  
many mica  
6.5' very pale brn  
red-yellow ls  
thick platy

(12H)

1' dk brn L  
3' 3csbk to 3msbk  
red-yel L  
3' 3csbk  
red-yel & brn-yel  
2' 2csbk

1' dk brn L, 3f sbk  
brn L, 3msbk  
yel-red & red-yel  
5' many mica  
thick platy

1' dk brn L, 3f sbk  
brn L, 3msbk  
yel-red & red-yel  
5' many mica  
thick platy

DATE	TEST #	DEPTH	START	BREAK 1" DROP	STOP 2" DROP	TIME OF 2ND INCH	P/F/H
5/11/15	12J	5' 13"	2:03		2:05	reshelf	
reshelf	12J	35' 13"	2:21	2:24	2:32	8	P
5/11/15	12K	3.5'	Visual	sidewall 0.8 gpd	1'-3.5'	42	P
5/11/15	12G	4.5' 13"	3:09	3:11	3:13	2	P
5/11/15	12F	5' 12"	2:57	3:05	NO movement	reshelf	
reshelf	12F	6.5' 12"	3:15	3:19	3:25	6	P
5/11/15	12H	5.8' 12"	3:34	3:36	3:39	3	P

REMARKS 12K & 12J Bottom at 3.5', 12G Dug 100' from stream


SANITARIAN R Bricker BACKHOE OTHERS

TEST HOLES USED IN SDA AVG. PERC TIME SQ. FT/BR

TRENCH WIDTH INLET DEPTH MAX. BOT DEPTH EFFECTIVE SW





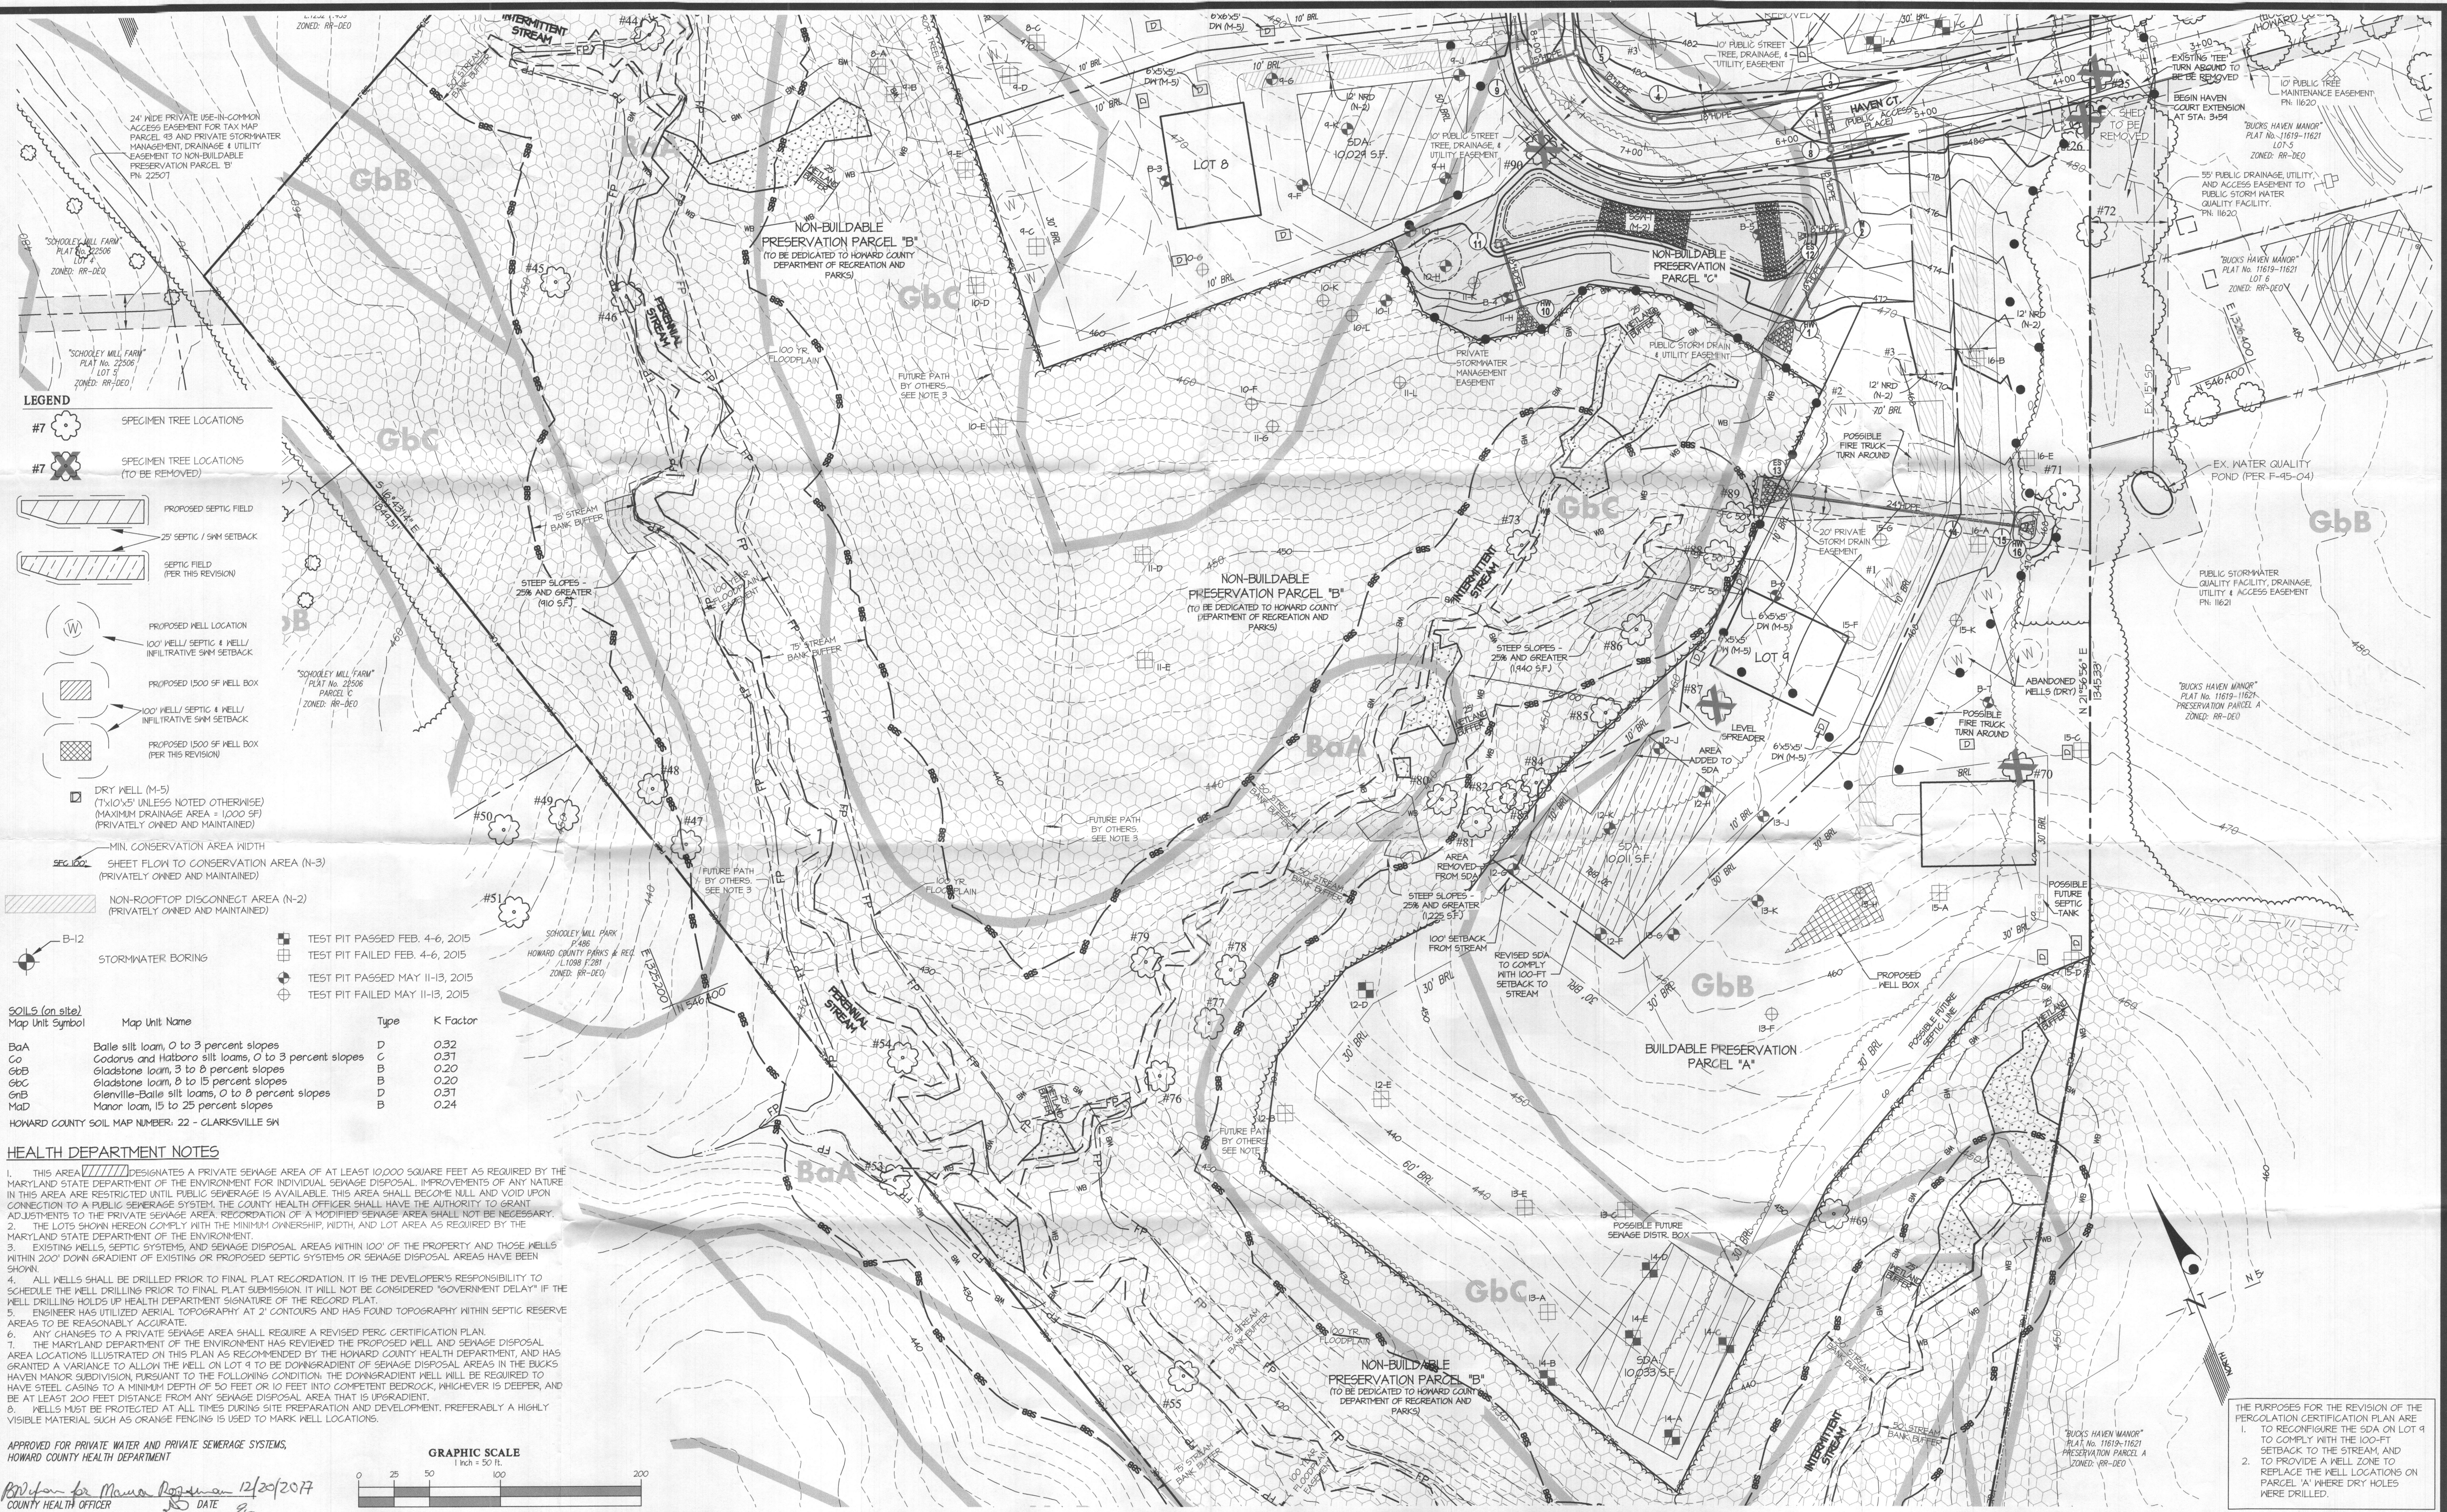

**LEGEND**

- #7 SPECIMEN TREE LOCATIONS
- #7 SPECIMEN TREE LOCATIONS (TO BE REMOVED)
- PROPOSED SEPTIC FIELD
- 25' SEPTIC / SNM SETBACK
- SEPTIC FIELD (PER THIS REVISION)
- PROPOSED WELL LOCATION
- 100' WELL/ SEPTIC & WELL/ INFILTRATIVE SNM SETBACK
- PROPOSED 1500 SF WELL BOX
- 100' WELL/ SEPTIC & WELL/ INFILTRATIVE SNM SETBACK
- PROPOSED 1500 SF WELL BOX (PER THIS REVISION)
- DRY WELL (M-5) (7'x10'x5' UNLESS NOTED OTHERWISE) (MAXIMUM DRAINAGE AREA = 1,000 SF) (PRIVATELY OWNED AND MAINTAINED)
- MIN. CONSERVATION AREA WIDTH
- SHEET FLOW TO CONSERVATION AREA (N-3) (PRIVATELY OWNED AND MAINTAINED)
- NON-ROOFTOP DISCONNECT AREA (N-2) (PRIVATELY OWNED AND MAINTAINED)
- STORMWATER BORING
- TEST PIT PASSED FEB. 4-6, 2015
- TEST PIT FAILED FEB. 4-6, 2015
- TEST PIT PASSED MAY 11-13, 2015
- TEST PIT FAILED MAY 11-13, 2015

**SOILS (on site)**

Map Unit Symbol	Map Unit Name	Type	K Factor
BaA	Baile silt loam, 0 to 3 percent slopes	D	0.32
Co	Codorus and Hatboro silt loams, 0 to 3 percent slopes	C	0.31
GbB	Gladstone loam, 3 to 8 percent slopes	B	0.20
GbC	Gladstone loam, 8 to 15 percent slopes	B	0.20
GnB	Glenville-Baile silt loams, 0 to 8 percent slopes	D	0.31
MaD	Manor loam, 15 to 25 percent slopes	B	0.24

HOWARD COUNTY SOIL MAP NUMBER: 22 - CLARKSVILLE SW

**HEALTH DEPARTMENT NOTES**

1. THIS AREA [Hatched] DESIGNATES A PRIVATE SEWAGE AREA OF AT LEAST 10,000 SQUARE FEET AS REQUIRED BY THE MARYLAND STATE DEPARTMENT OF THE ENVIRONMENT FOR INDIVIDUAL SEWAGE DISPOSAL. IMPROVEMENTS OF ANY NATURE IN THIS AREA ARE RESTRICTED UNTIL PUBLIC SEWERAGE IS AVAILABLE. THIS AREA SHALL BECOME NULL AND VOID UPON CONNECTION TO A PUBLIC SEWERAGE SYSTEM. THE COUNTY HEALTH OFFICER SHALL HAVE THE AUTHORITY TO GRANT ADJUSTMENTS TO THE PRIVATE SEWAGE AREA. RECORDATION OF A MODIFIED SEWAGE AREA SHALL NOT BE NECESSARY.
2. THE LOTS SHOWN HEREON COMPLY WITH THE MINIMUM OWNERSHIP, WIDTH, AND LOT AREA AS REQUIRED BY THE MARYLAND STATE DEPARTMENT OF THE ENVIRONMENT.
3. EXISTING WELLS, SEPTIC SYSTEMS, AND SEWAGE DISPOSAL AREAS WITHIN 100' OF THE PROPERTY AND THOSE WELLS WITHIN 200' DOWN GRADIENT OF EXISTING OR PROPOSED SEPTIC SYSTEMS OR SEWAGE DISPOSAL AREAS HAVE BEEN SHOWN.
4. ALL WELLS SHALL BE DRILLED PRIOR TO FINAL PLAT RECORDATION. IT IS THE DEVELOPER'S RESPONSIBILITY TO SCHEDULE THE WELL DRILLING PRIOR TO FINAL PLAT SUBMISSION. IT WILL NOT BE CONSIDERED "GOVERNMENT DELAY" IF THE WELL DRILLING HOLDS UP HEALTH DEPARTMENT SIGNATURE OF THE RECORD PLAT.
5. ENGINEER HAS UTILIZED AERIAL TOPOGRAPHY AT 2' CONTOURS AND HAS FOUND TOPOGRAPHY WITHIN SEPTIC RESERVE AREAS TO BE REASONABLY ACCURATE.
6. ANY CHANGES TO A PRIVATE SEWAGE AREA SHALL REQUIRE A REVISED PERC CERTIFICATION PLAN.

THE HEALTH AND DEPARTMENT OF THE ENVIRONMENT HAS REVIEWED THE PROPOSED WELL AND SEWAGE DISPOSAL AREA LOCATIONS ILLUSTRATED ON THIS PLAN AS RECOMMENDED BY THE HOWARD COUNTY HEALTH DEPARTMENT, AND HAS GRANTED A VARIANCE TO ALLOW THE WELL ON LOT 9 TO BE DOWNGRADIENT OF SEWAGE DISPOSAL AREAS IN THE BUCKS HAVEN MANOR SUBDIVISION, PURSUANT TO THE FOLLOWING CONDITION: THE DOWNGRADIENT WELL WILL BE REQUIRED TO HAVE STEEL CASING TO A MINIMUM DEPTH OF 50 FEET OR 10 FEET INTO COMPETENT BEDROCK, WHICHEVER IS DEEPER, AND BE AT LEAST 200 FEET DISTANCE FROM ANY SEWAGE DISPOSAL AREA THAT IS UPGRADE.

ALL WELLS MUST BE PROTECTED AT ALL TIMES DURING SITE PREPARATION AND DEVELOPMENT. PREFERABLY A HIGHLY VISIBLE MATERIAL SUCH AS ORANGE FENCING IS USED TO MARK WELL LOCATIONS.

APPROVED FOR PRIVATE WATER AND PRIVATE SEWERAGE SYSTEMS,  
HOWARD COUNTY HEALTH DEPARTMENT

*Barbara Dawson* 12/29/2017  
COUNTY HEALTH OFFICER

**GRAPHIC SCALE**  
1 inch = 50 feet

0 25 50 100 200

<b>GLWGUTSCHICK LITTLE &amp; WEBER, P.A.</b> CIVIL ENGINEERS, LAND SURVEYORS, LAND PLANNERS, LANDSCAPE ARCHITECTS 3909 NATIONAL DRIVE - SUITE 250 - BURTONSVILLE OFFICE PARK BURTONSVILLE, MARYLAND 20866 TEL: 301-421-4024 BAL: 410-880-1820 DC/VA: 301-989-2524 FAX: 301-421-4186	<b>OWNER:</b> THE WILBUR AND EVELYN HINKLE FAMILY LIMITED PARTNERSHIP 3067 SHORECREST BAY DR MURRELLS INLET, SC 29576 ATTN: BARBARA DAWSON		<b>DEVELOPER:</b> WILLIAMSBURG GROUP, LLC 5485 HARPERS FARM RD SUITE 200 COLUMBIA, MD 21044 ATTN: BOB CORBETT 410-997-8800		<b>PROFESSIONAL CERTIFICATION</b> I HEREBY CERTIFY THAT THESE PLANS WERE PREPARED OR APPROVED BY ME, AND THAT I AM A DULY LICENSED PROFESSIONAL ENGINEER UNDER THE LAWS OF THE STATE OF MARYLAND, LICENSE NO. 12935 EXPIRATION DATE: MAY 26, 2018 <i>Bob Corbett</i> 12/8/17		<b>STATE OF MARYLAND</b> PROFESSIONAL ENGINEER		<b>REVISED PERCOLATION CERTIFICATION PLAN</b> <b>ESTATES AT SCHOOLEY MILL</b> <b>LOT 9 &amp; Buildable Preservation Parcel 'A'</b> TAX PARCEL 93 LIBER 4637 FOLIO 68 ELECTION DISTRICT No. 5		SCALE 1"=50'	ZONING RR-DEO	G. L. W. FILE No. 14067	
	DATE		REVISION		BY		APPR.		DATE		TAX MAP - GRID		SHEET	
	DATE		REVISION		BY		APPR.		DATE		TAX MAP - GRID		SHEET	
	DATE		REVISION		BY		APPR.		DATE		TAX MAP - GRID		SHEET	

THE PURPOSES FOR THE REVISION OF THE PERCOLATION CERTIFICATION PLAN ARE:

1. TO RECONFIGURE THE SDA ON LOT 9 TO COMPLY WITH THE 100-FT SETBACK TO THE STREAM, AND
2. TO PROVIDE A WELL ZONE TO REPLACE THE WELL LOCATIONS ON PARCEL 'A' WHERE DRY HOLES WERE DRILLED.




# LEGEND


- EXISTING 2' CONTOURS
- EXISTING 10' CONTOURS
- SOIL LINES AND TYPES
- DENOTES PASSED PERC
- DENOTES 1500 Sq.Ft. ALTERNATE WELL SITE

## SOILS LEGEND

SOIL	NAME	CLASS
ELC3	Elloak silty clay loam, 0 to 15 percent slopes, moderately eroded	B
ELB2	Elloak silt loam, 3 to 8 percent slopes, moderately eroded	B

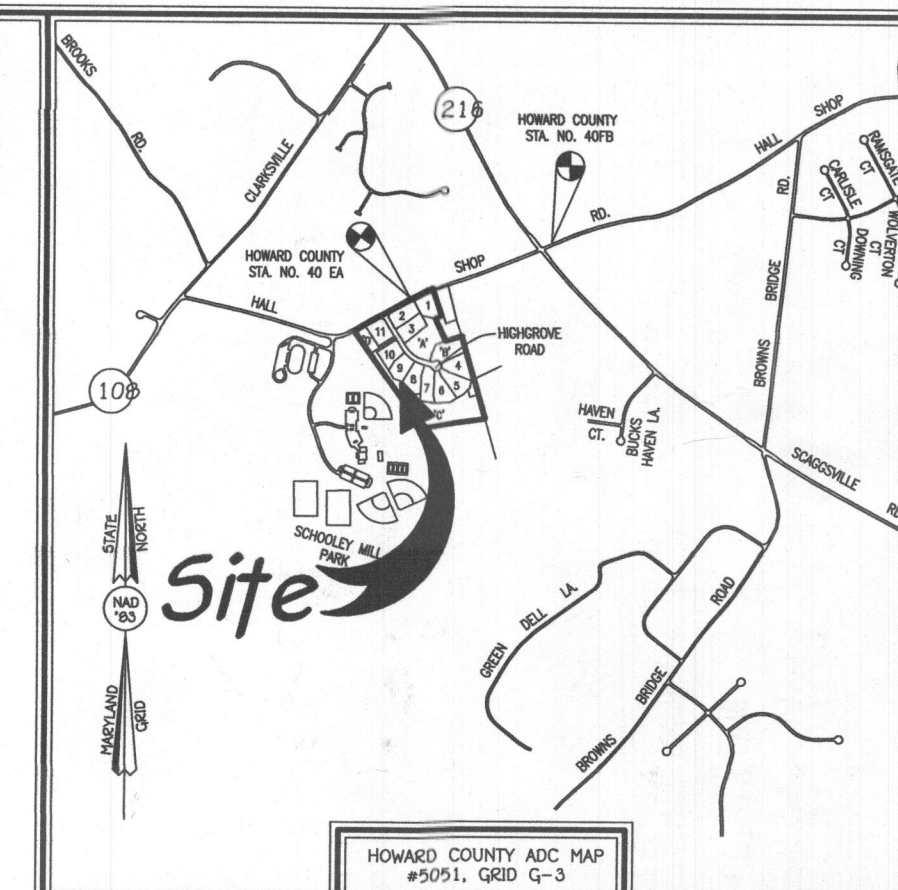

VICINITY MAP  
SCALE : 1" = 1200'

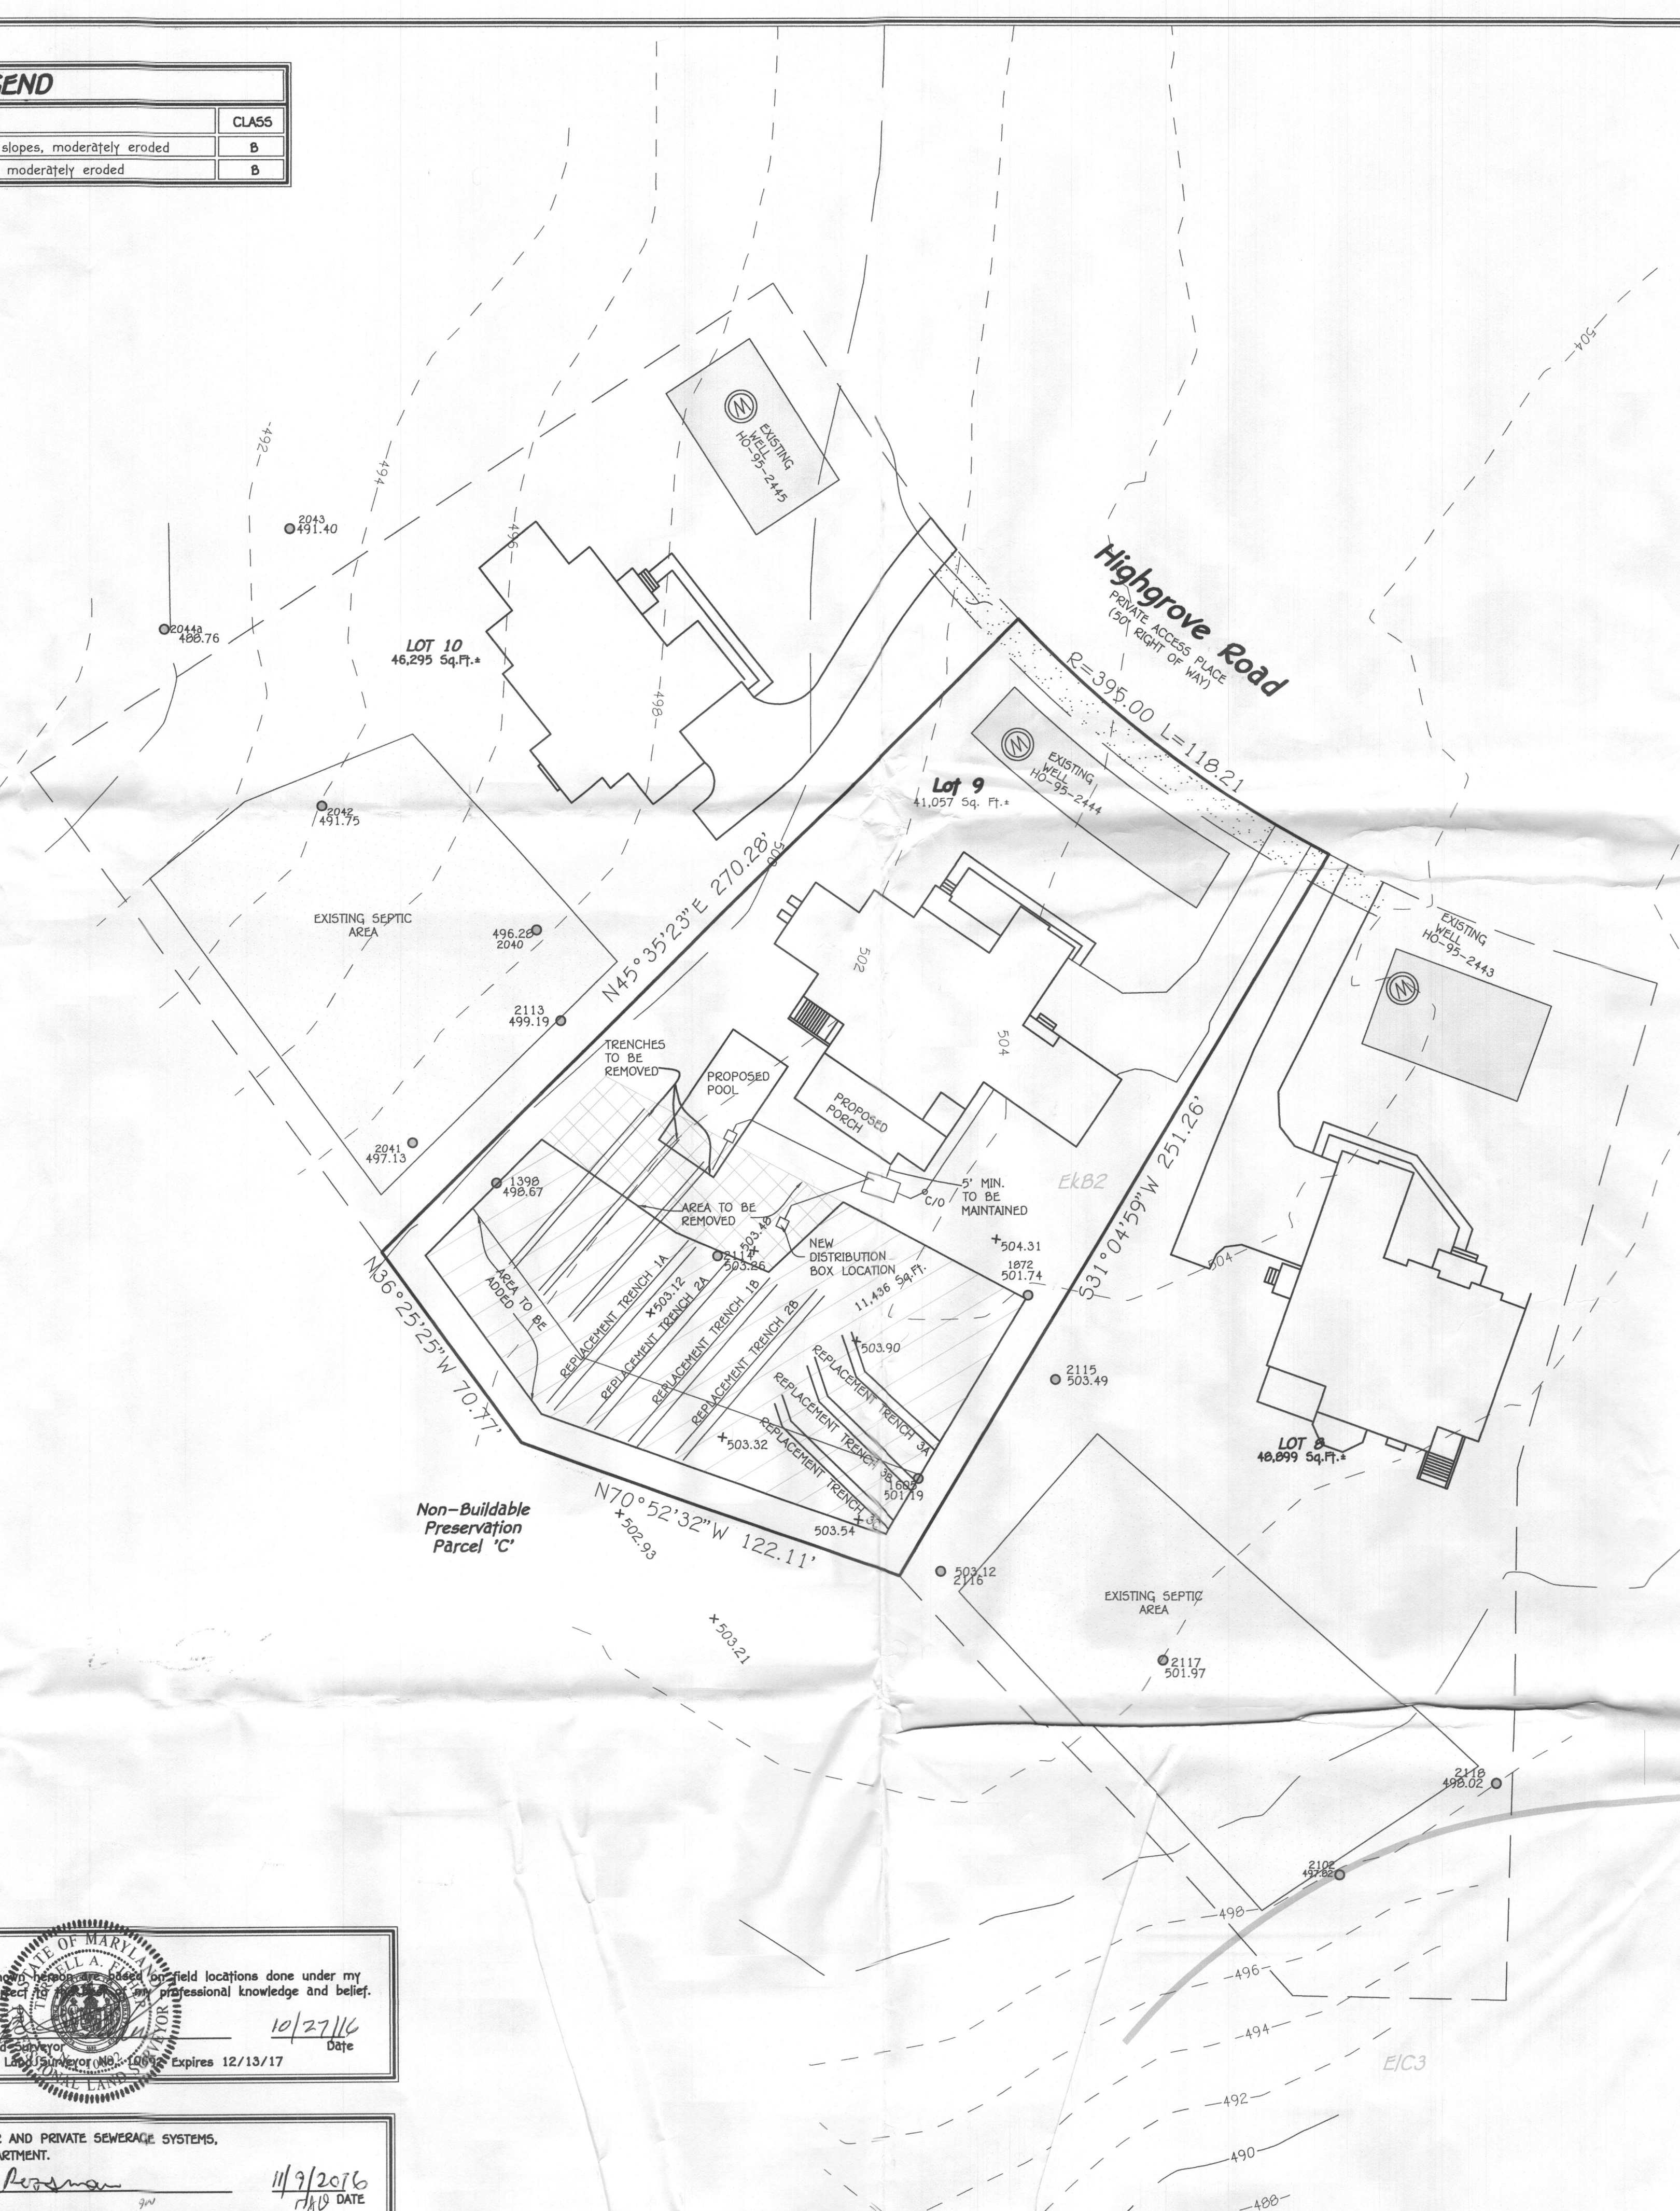

## GENERAL NOTES:

- THIS AREA DESIGNATES A PRIVATE SEWERAGE EASEMENT OF 10,000 SQUARE FEET AS REQUIRED BY THE MARYLAND STATE DEPARTMENT OF THE ENVIRONMENT FOR INDIVIDUAL SEWERAGE DISPOSAL IMPROVEMENTS OF ANY NATURE IN THIS AREA ARE RESTRICTED UNTIL PUBLIC SEWERAGE IS AVAILABLE. THESE EASEMENTS SHALL BECOME NULL AND VOID UPON CONNECTION TO A PUBLIC SEWERAGE SYSTEM. THE COUNTY HEALTH OFFICER SHALL HAVE THE AUTHORITY TO GRANT ADJUSTMENTS TO THE PRIVATE SEWERAGE EASEMENT. RECORDATION OF A MODIFIED SEWERAGE EASEMENT SHALL NOT BE NECESSARY.
- ADJUSTMENTS TO SEPTIC EASEMENT AREA IS NOT PERMITTED WITHOUT ADDITIONAL TESTING.
- THE LOT SHOWN HEREON COMPLIES WITH THE MINIMUM OWNERSHIP WIDTH AND LOT AREA AS REQUIRED BY THE MARYLAND STATE DEPARTMENT OF THE ENVIRONMENT.
- EXISTING WELLS AND/OR SEWERAGE EASEMENTS WITHIN 100 FEET OF THE PROPERTY HAVE BEEN SHOWN FROM THE BEST AVAILABLE INFORMATION.
- ALL HOUSE SITES SHOWN COMPLY WITH MINIMUM BUILDING RESTRICTION REGULATIONS.
- TOPOGRAPHY SHOWN IS FIELD RUN FROM FISHER COLLINS AND CARTER, INC. ON OR ABOUT MARCH 6, 2006.
- BOUNDARY OUTLINE BASED ON AVAILABLE PLAT OF RECORD WITHOUT THE BENEFIT OF A FIELD SURVEY AT THIS TIME.
- THE TRENCH REPLACEMENT MUST BE PERFORMED PRIOR TO HEALTH APPROVAL OF A BUILDING PERMIT FOR THE POOL.
- THE WELLS HAS BEEN FIELD LOCATED BY FISHER, COLLINS AND CARTER, INC. AND THE SEPTIC TANK LOCATION IS FROM THE HOWARD COUNTY HEALTH DEPARTMENT'S FIELD AS-BUILT SHEET DATED 10/10/14.

THE PURPOSE OF THIS PLAN IS TO REVISE THE SEPTIC AREA ON LOT 9 FOR THE PURPOSE OF A POOL ADDITION.

## PERC CERTIFICATION

I certify that the locations shown herein are based on field locations done under my direct supervision and are correct to the best of my professional knowledge and belief.

Signature of Professional Land Surveyor: Terrell A. Fisher, Professional Land Surveyor (No. 10878) Expires 12/13/17  
Date: 10/27/16

APPROVED FOR PRIVATE WATER AND PRIVATE SEWERAGE SYSTEMS, HOWARD COUNTY HEALTH DEPARTMENT.

Signature for Maria Pessina  
Date: 11/9/2016

## PERC RECERTIFICATION PLAN SCHOOLEY MILL FARM LOT 9

TAX MAP #40  
5TH ELECTION DISTRICT  
SCALE: 1"=30'

PARCEL: 115  
HOWARD COUNTY, MARYLAND  
DATE: OCTOBER 26, 2015

FISHER, COLLINS & CARTER, INC.  
CIVIL ENGINEERING CONSULTANTS & LAND SURVEYORS  
CENTENNIAL SQUARE OFFICE PARK - 10272 BALTIMORE NATIONAL PIKE  
ELIJAH CITY, MARYLAND 21042  
(410) 461-2895




LEGEND


- EXISTING 2' CONTOURS  
— EXISTING 10' CONTOURS  
CLB2  
MLC2  
SOIL LINES AND TYPES  
● DENOTES PASSED PERC  
● DENOTES 1500 Sq.Ft. ALTERNATE WELL SITE

SOILS LEGEND

SOIL	NAME	CLASS
EIC3	Elioak silty clay loam, 0 to 15 percent slopes, moderately eroded	B
EKB2	Elioak silt loam, 3 to 0 percent slopes, moderately eroded	B

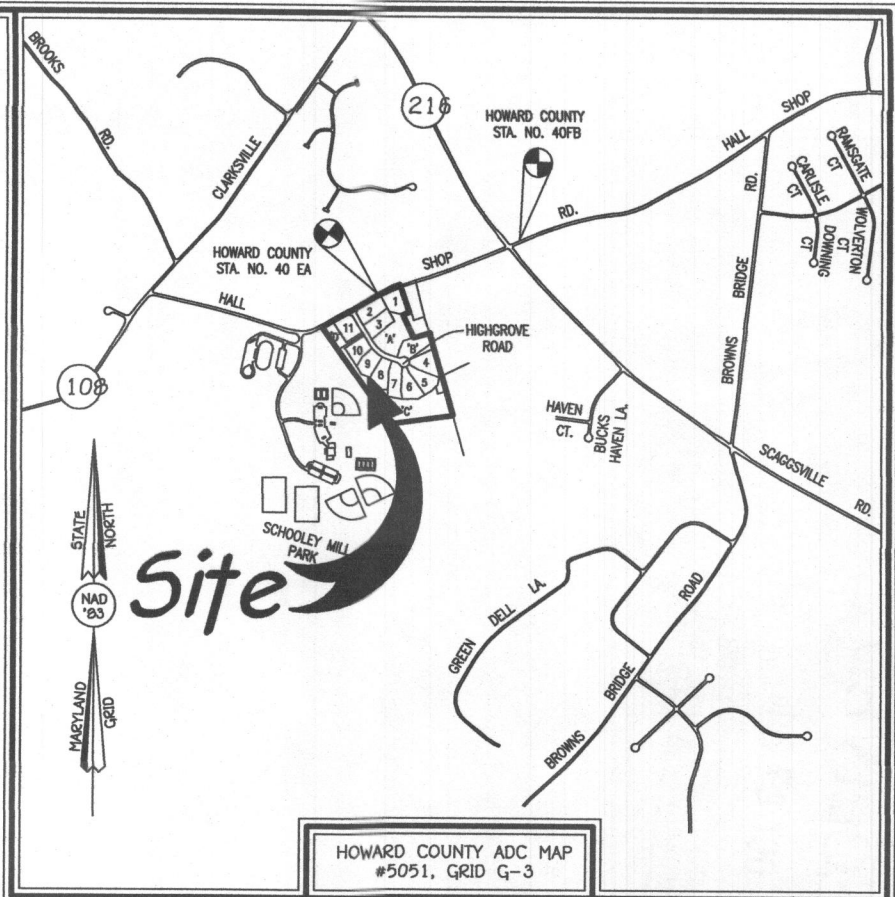

VICINITY MAP  
SCALE : 1" = 1200'

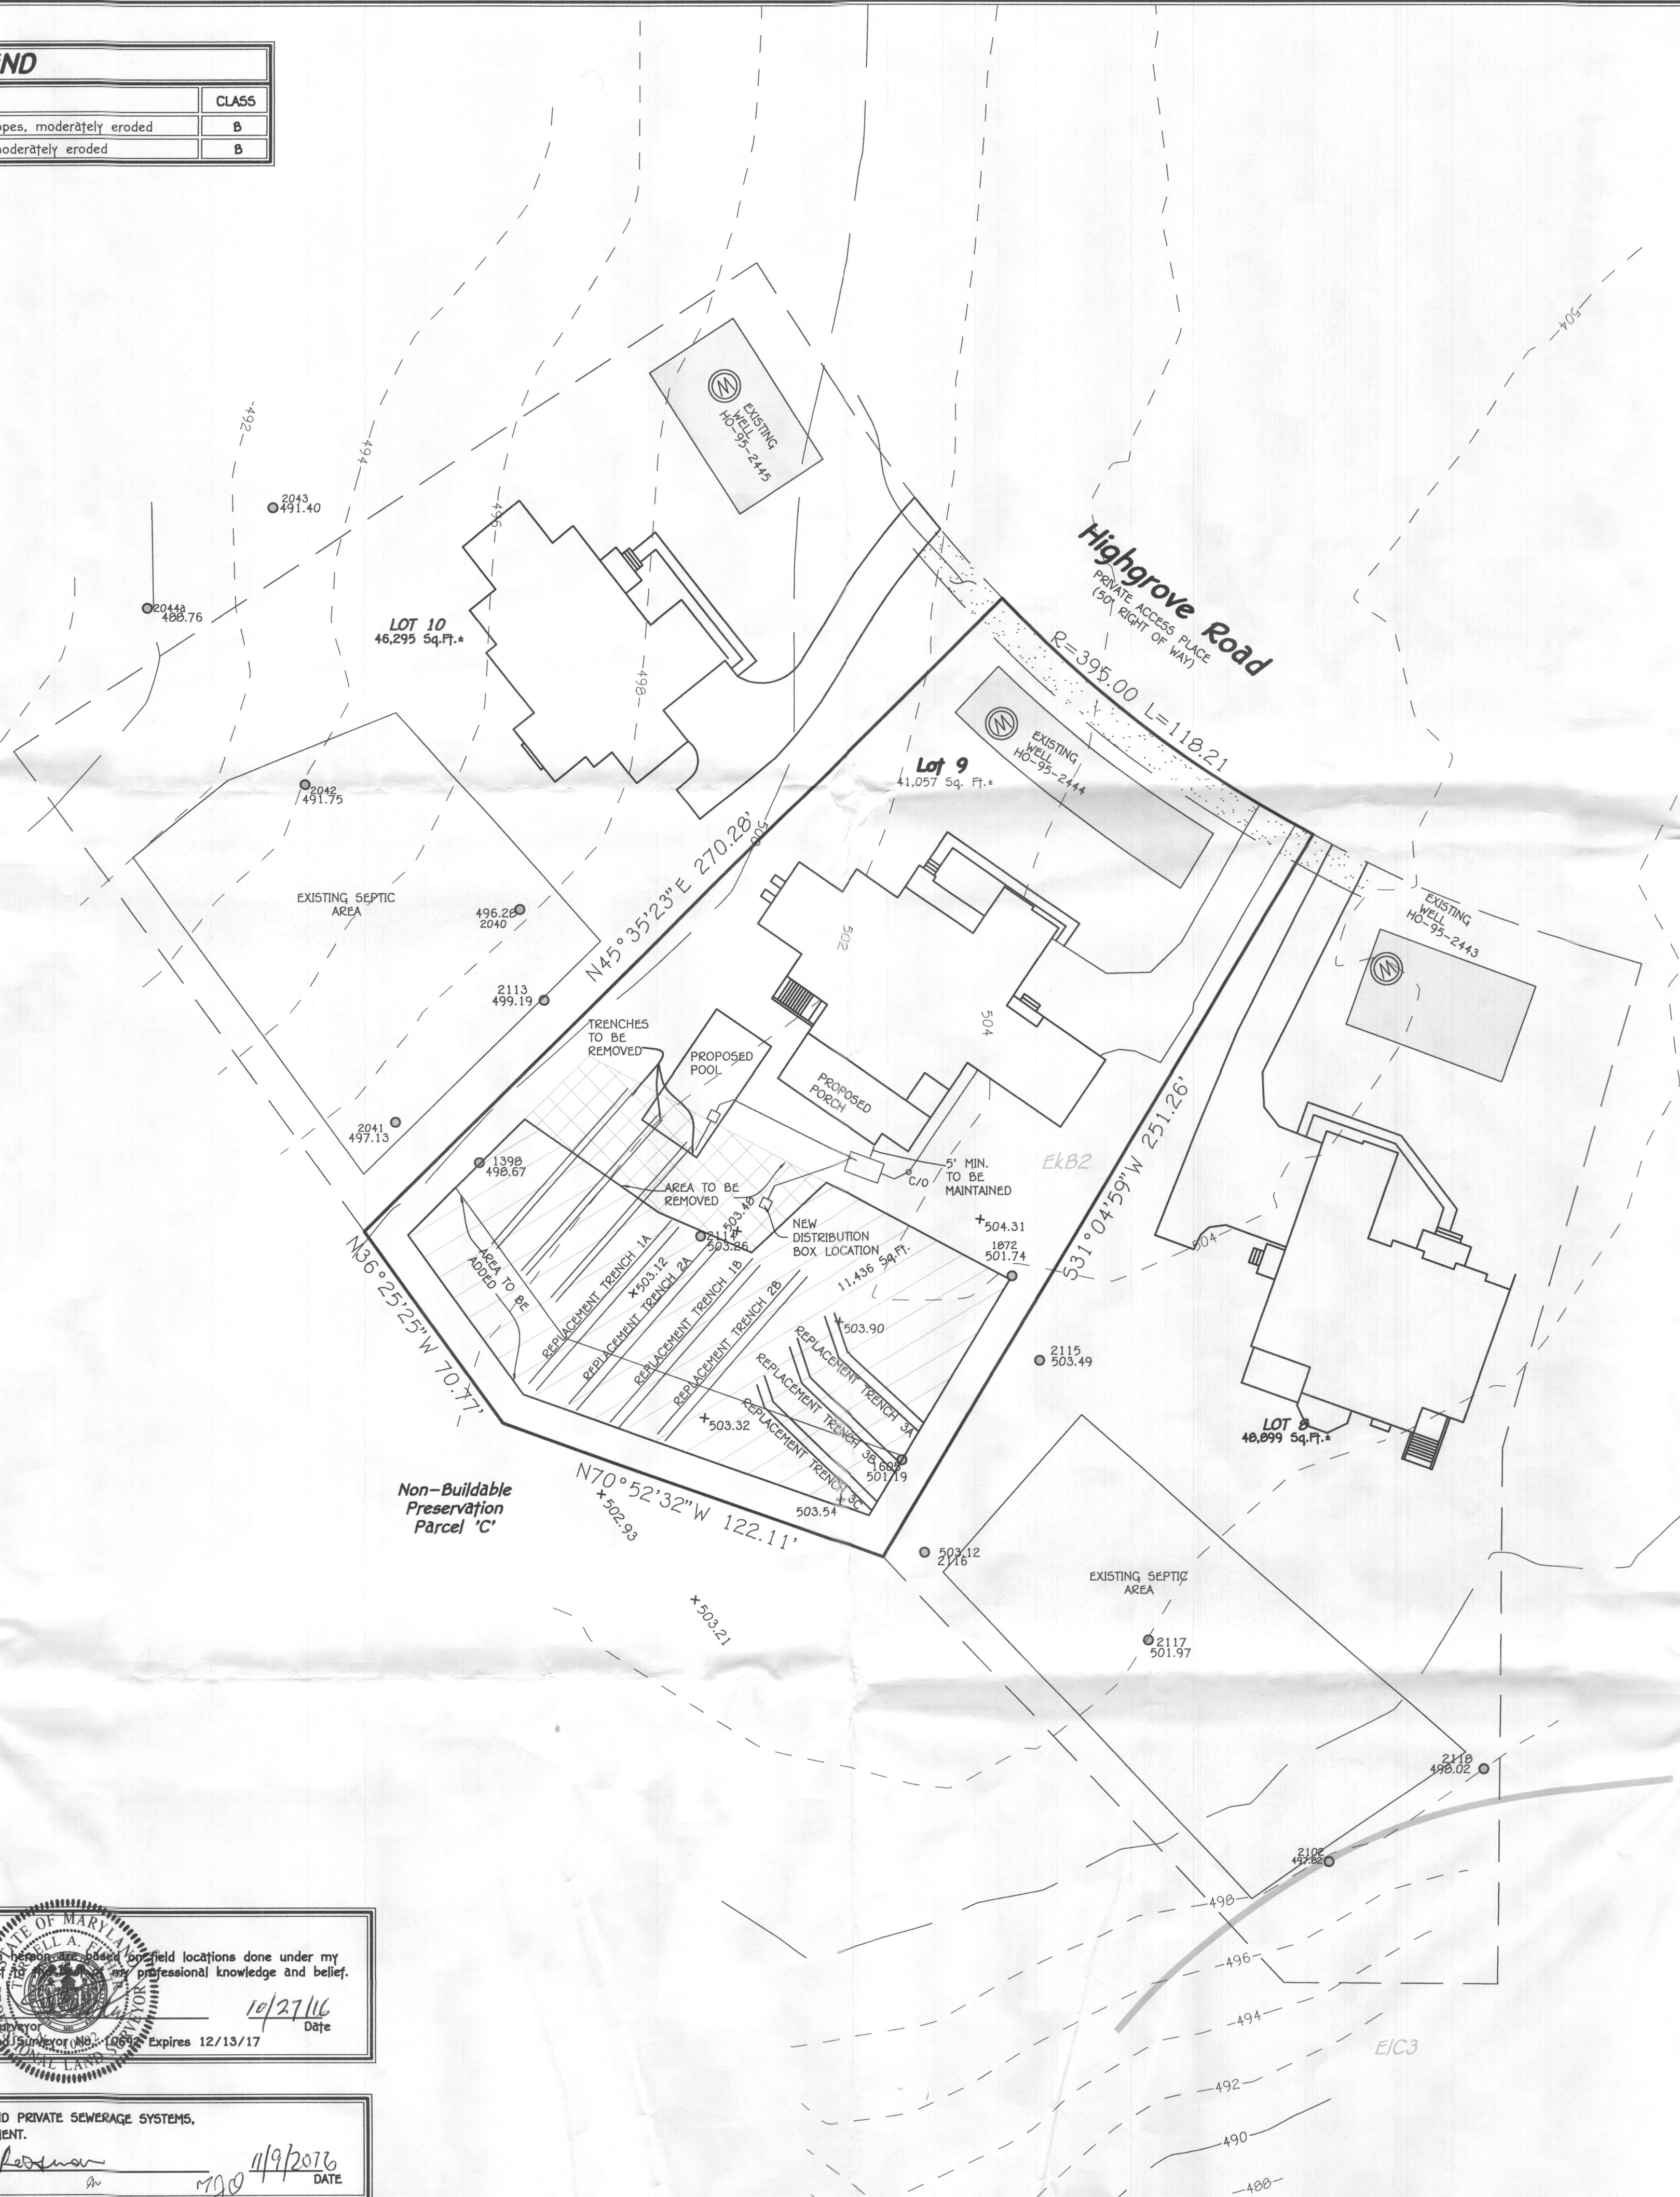

GENERAL NOTES:

1. THIS AREA DESIGNATES A PRIVATE SEWERAGE EASEMENT OF 10,000 SQUARE FEET AS REQUIRED BY THE MARYLAND STATE DEPARTMENT OF THE ENVIRONMENT FOR INDIVIDUAL SEWERAGE DISPOSAL IMPROVEMENTS OF ANY NATURE IN THIS AREA. EASEMENTS SHALL BECOME NULL AND VOID UPON CONNECTION TO A PUBLIC SEWERAGE SYSTEM. THE COUNTY HEALTH OFFICER SHALL HAVE THE AUTHORITY TO GRANT ADJUSTMENTS TO THE PRIVATE SEWERAGE EASEMENT. RECORDATION OF A MODIFIED SEWERAGE EASEMENT SHALL NOT BE NECESSARY.
2. ADJUSTMENTS TO SEPTIC EASEMENT AREA IS NOT PERMITTED WITHOUT ADDITIONAL TESTING.
3. THE LOT SHOWN HEREON COMPLIES WITH THE MINIMUM OWNERSHIP WIDTH AND LOT AREA AS REQUIRED BY THE MARYLAND STATE DEPARTMENT OF THE ENVIRONMENT.
4. EXISTING WELLS AND/OR SEWERAGE EASEMENTS WITHIN 100 FEET OF THE PROPERTY HAVE BEEN SHOWN FROM THE BEST AVAILABLE INFORMATION.
5. ALL HOUSE SITES SHOWN COMPLY WITH MINIMUM BUILDING RESTRICTION REGULATIONS.
6. TOPOGRAPHY SHOWN IS FIELD RUN FROM FISHER, COLLINS AND CARTER, INC. ON OR ABOUT MARCH 6, 2006.
7. BOUNDARY OUTLINE BASED ON AVAILABLE PLAT OF RECORD WITHOUT THE BENEFIT OF A FIELD SURVEY AT THIS TIME.
8. THE TRENCH REPLACEMENT MUST BE PERFORMED PRIOR TO HEALTH APPROVAL OF A BUILDING PERMIT FOR THE POOL.
9. THE WELLS HAS BEEN FIELD LOCATED BY FISHER, COLLINS AND CARTER, INC. AND THE SEPTIC TANK LOCATION IS FROM THE HOWARD COUNTY HEALTH DEPARTMENTS FIELD AS-BUILT SHEET DATED 10/10/14.

THE PURPOSE OF THIS PLAN IS TO REVISE THE SEPTIC AREA ON LOT 9 FOR THE PURPOSE OF A POOL ADDITION.

PERC CERTIFICATION  
I certify that the locations shown on this plan are the field locations done under my direct supervision and are correct to the best of my professional knowledge and belief.  
Signature of Professional Land Surveyor: Terrell A. Fisher, Professional Land Surveyor (No. 10889) Expires 12/13/17  
Date: 10/27/16

APPROVED FOR PRIVATE WATER AND PRIVATE SEWERAGE SYSTEMS,  
HOWARD COUNTY HEALTH DEPARTMENT.  
Signature of County Health Officer: [Signature]  
DATE: 11/9/2016

PERC RECERTIFICATION PLAN  
SCHOOLEY MILL FARM  
LOT 9

TAX MAP #40  
5TH ELECTION DISTRICT  
SCALE: 1"=30'

PARCEL: 115  
HOWARD COUNTY, MARYLAND  
DATE: OCTOBER 26, 2015