

APPLICATION

SEWAGE DISPOSAL TESTING

A 02377

P _____

MARYLAND STATE DEPARTMENT OF HEALTH

HOWARD COUNTY

ELLICOTT CITY

DISTRICT 4

DATE 4-27-60

*750 Tanks
50' x 3' Trench
& use existing dry well*

TO: THE COUNTY HEALTH OFFICER
ELLICOTT CITY, MARYLAND

I, HEREBY, APPLY FOR THE NECESSARY TESTS IN ORDER TO CONSTRUCT (OR RECONSTRUCT) A SEWAGE DISPOSAL SYSTEM.

PROPERTY OWNER Russell S. and Geneva R. Maisel

ADDRESS Roxbury Road and Dorsey Mill Road PHONE Glenwood 862-J

PROPERTY LOCATION:

SUBDIVISION _____ LOT NO. _____

ROAD AND DESCRIPTION Roxbury Road and Dorsey Mill Road

OCCUPANT _____ PHONE _____

PERSON TO CONSTRUCT SYSTEM _____

ADDRESS Russell S. Maisel PHONE Glen. 862-J

SIZE OF LOT 6 acres TYPE BLDG. 1
NUMBER OF BEDROOMS

IF NOT SINGLE RESIDENCE DESCRIBE _____

SIGNATURE OF APPLICANT Russell S. Maisel

APPROVED BY P. W. FOR tile field DATE 5/17/60
(KIND OF SYSTEM)


REJECTED BY _____ FOR _____ DATE _____
(KIND OF SYSTEM)

HOLD PENDING FURTHER TESTS J.H. DATE _____

REASONS FOR REJECTION OR HOLDING 5/5/60 Hole not dug.

THIS IS NOT A PERMIT

Maisel, Russell

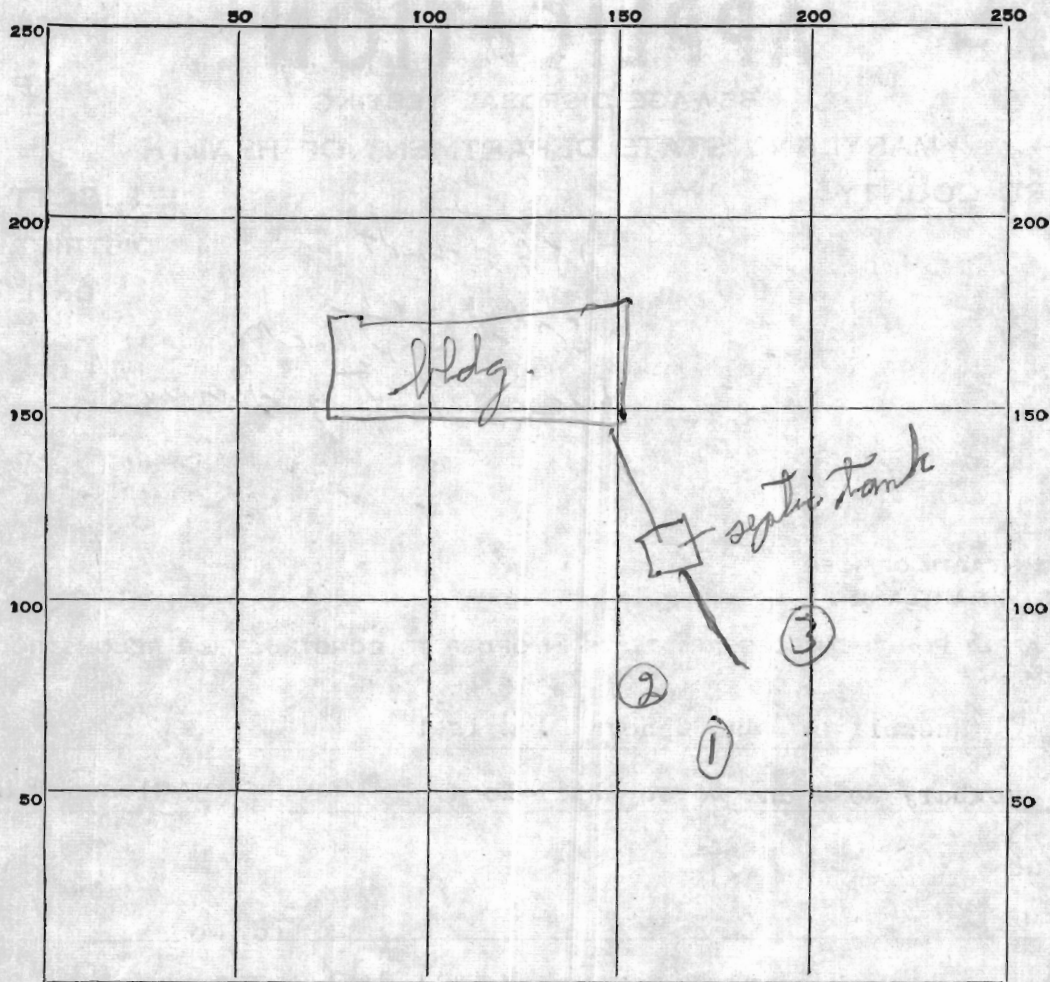

INDICATE NORTH. — NAME ADJOINING ROADWAY AS BASE LINE.

DATE	TEST NO.	DEPTH	PRE-WET		TEST - 1" DROP		TIME
			START	STOP	START	STOP	
5/1/60	1 #	3'	1:16	1:17	1:17	1:18	1
	2 #	3'	1:20	1:22	1:22	1:29	7
	3 #	3'	1:21	stopped.			

SOIL AUGER FINDING

TESTED BY

Palmer E. Wine

REMARKS

ALSO PRESENT

Russell S. Maise

LOT NO.

6 Puro

44
24
126
846