

2/24/20 Approved amendment,  
Permit for open porch. n.o.

Name of Requestor: Josh Ritter  
Street Address: 232 Cockeysville Road Suite 8200  
City, State, Zip: Cockeysville, MD 21030  
Date: 2/13/2020

Amendment, Permit # B19003478

Ms. Debbie Whalen  
Division of Plan Review  
Department of Inspections, Licenses and Permits  
Howard County Government  
3430 Court House Dr  
Ellicott City, MD 21043

**RECEIVED**

FEB 12 2020

LICENSES & PERMITS  
DIVISION

Dear Ms. Whalen:

I am requesting to amend Permit # B19003478 at  
4152 Roxbury Mill Road Glenwood, MD 21738 to

(Site Address)

Add open porch roof

Enclosed:

1 Fee: 25.00  
4 Plot Plans  
3 Sets of Construction Drawings  
Other: \_\_\_\_\_

Invoice  
ck# 0329  
paid

If there is anything we can do to assist you, please let me know.

Sincerely,

\*For Pick up\*  
CC: PIZ  
Heath


Name: Josh Ritter  
Title: Assistant Project Manager  
Phone and/or Email: Josh @ Smithco

L.I. GROSS PROPERTY

TAX PARCEL 51 (MAP  
4.855 ACRES

REVISED  
Date: 2-13-20  
Comments: Revised to add open porch roof

REVISION  
B9003478

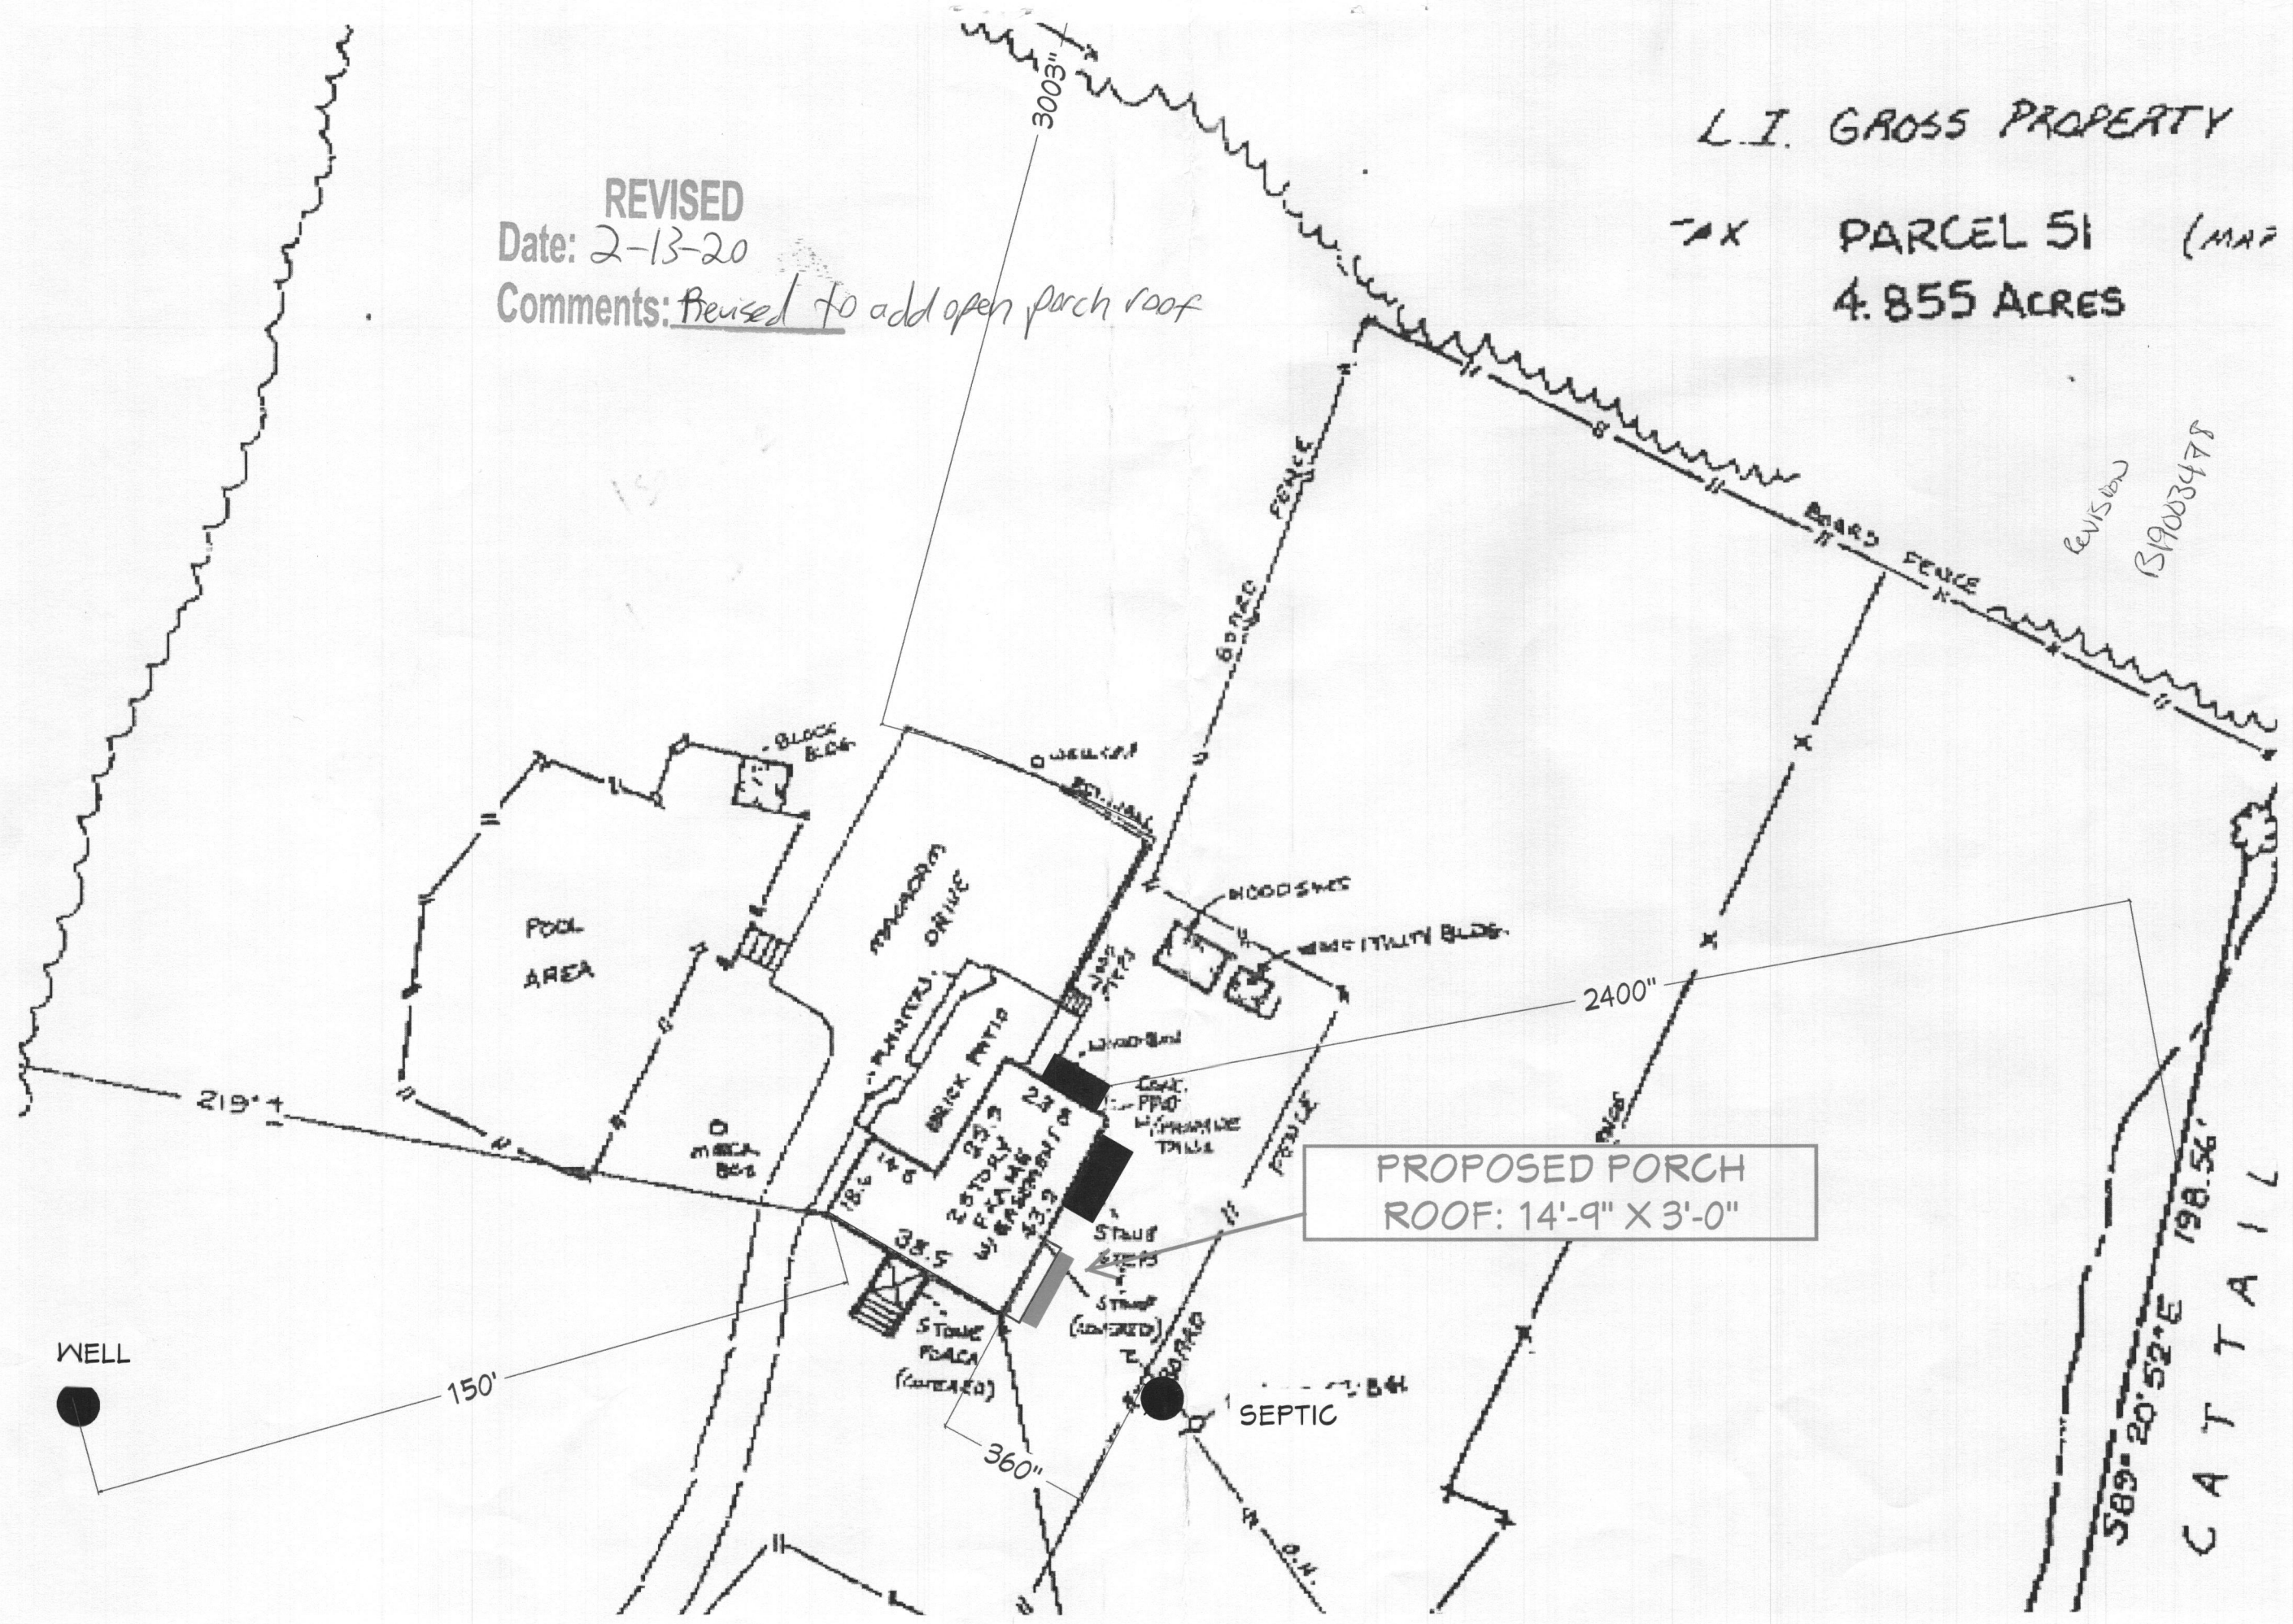

FURST RESIDENCE  
4152 ROXBURY MILL ROAD  
GLENWOOD, MARYLAND

REVISIONS:

DATE:  
2/13/2020

SCALE:  
1"=30'

SHEET:  
1B