

Date Rec	eived: _	
----------	----------	--

الططن المنطقة	Building Permit Application Howard County Maryland	Date Receive
	Department of Inspections, Licenses and Permits 3430 Court House Drive	
	Permits: 410-313-2455	
	www.howardcountymd.gov	Permit No.:

Building Address: 5215 Sweet Mea	adow Lane	Property Owner's Name: <u>Lazzari, Philip & Majorie</u>	
City: Clarksville State: _		Address: 5215 Sweet Meadow Lane City: Clarksville State: MD Zip Code: 21029	
Suite/Apt. #SDP/\	NP/BA #:	Phone: Fax:	
Subdivision: Walnut Grove		padine molienomes.com	
Lot: 70 Tax Map: 0028	Parcel: 2074 70	Applicant's Name & Mailing Address, (If other than stated herein) Applicant's Name: Tate Galloway	
Existing Use: SFD		Address: 11710 Old Frederick Road	
Proposed Use: SFD w/swimming po	ool	City: Marriottsville State: MD Zip Code: 21104 Phone: 443-506-7043 Fax: 866-237-5642	
		Email: info@gallowaypoolservice.com	
Estimated Construction Cost: \$ 65,000			
Description of Work: Swimming poo		Contractor Company: Galloway Pool Service, Inc Contact Person: Tate Galloway	
Pool size 20x48 Concrete const	ruction; pool to be	Address: 11710 Old Frederick Road	
enclosed by fence to code; Filled	by truck.	City: Marriottsville State: MD Zip Code: 21104	
		License No.: 25223	
		Phone: 410-442-5005 Fax: 866-237-5642	
		Email: info@gallowaypoolservice.com	
Occupant/Tenant Name: Owner			
Was tenant space previously occupied?	□Yes □No	Engineer/Architect Company:	
Contact Name:		Responsible Design Prof.:	
Address:	i	Address:	
City: St	ate: Zip Code:	City:State:Zip Code:	
Phone:F	ax:	Phone:Fax:	
Email:		Email:	
Commercial Building Characteristics	Residential Building Characteristics	<u>Utilities</u>	
Height:	SF Dwelling SF Townhouse	Electric: Yes No	
No. of stories: Gross area, sq. ft./floor:	Depth Width 1st floor: 20' x 48'	Gas: Yes No	
G1033 area, sq. rt./11001.	2 nd floor: 960 SF	Water Supply	
Area of construction (sq. ft.):	Basement: 3'6" to 5' to 8.5'	√ Public	
	☐ Finished Basement	☐ Private	
Use group:	☐ Unfinished Basement	Sewage Disposal	
	☐ Crawl Space	Public	
Construction type: ☑ Reinforced Concrete	☐ Slab on Grade No. of Bedrooms:	√Z Private	
☐ Structural Steel	Multi-family Dwelling	<u>Heating System</u>	
☐ Masonry	No. of efficiency units:	☐ Electric ☐ Oil	
☐ Wood Frame	No. of 1 BR units:	☐ Natural Gas ☐ Propane Gas	
☐ State Certified Modular	No. of 2 BR units:	☐ Other:	
	No. of 3 BR units:	Sprinkler System:	
	Other Structure: Dimensions:	☐ Yes ☐ No	
> Roadside Tree Project Permit	Footings:		
□Yes □No	Roof:	Grading Permit Number:	
Roadside Tree Project Permit #	☐ State Certified Modular		
	☐ Manufactured Home	Building Shell Permit Number:	
		MAKE THIS APPLICATION; (2) THAT THE INFORMATION IS CORRECT; (3) THAT HE/SHE WILL COM	
		PERFORM NO WORK ON THE ABOVE REFERENCED PROPERTY NOT SPECIFICALLY DESCRIBED IN T FOR THE PURPOSE OF INSPECTING THE WORK PERMITTED AND POSTING NOTICES.	
		Steven T. Galloway	
Applicant's Signature		int Name	
info@gallowaypoolservice.com Email Address Date			
Owner, Galloway Pool Serv	rice, Inc.		
Title/Company			
	Checks Payable to: DIRECTOR OF F	INANCE OF HOWARD COLINTY	

Checks Payable to: DIRECTOR OF FINA

PLEASE WRITE NEATLY & LEGIBLY

-FOR OFFICE USE ONLY-

D	ATE	SIG	NATURE OF APPROVAL
4	25	19	H.0000046
		DATE	

☐ CONTINGENCY CONSTRUCTION START

DPZ SETBACK INFORMATION		
Front:		
Rear:		
Side:		
Side St.:		
All minimum setbacks met?	☐ Yes	□No
is Entrance Permit Required?	☐ Yes	□No
Historic District?	☐ Yes	□No
Lot Coverage for New Town Z	one:	
SDP/Red-line approval date:		

Filing Fee	\$
Permit Fee	\$
Tech Fee	\$
Excise Tax	\$
PSFS	\$
Guaranty Fund	\$
Add'l per Fee	\$
Total Fees	\$
Sub- Total Paid	\$
Balance Due	\$
Check	#


Distribution of Copies: White: Building Officials

Green: PSZA.Zoning


Yellow: PSZA, Engineering

Pink: Health

Gold: SHA

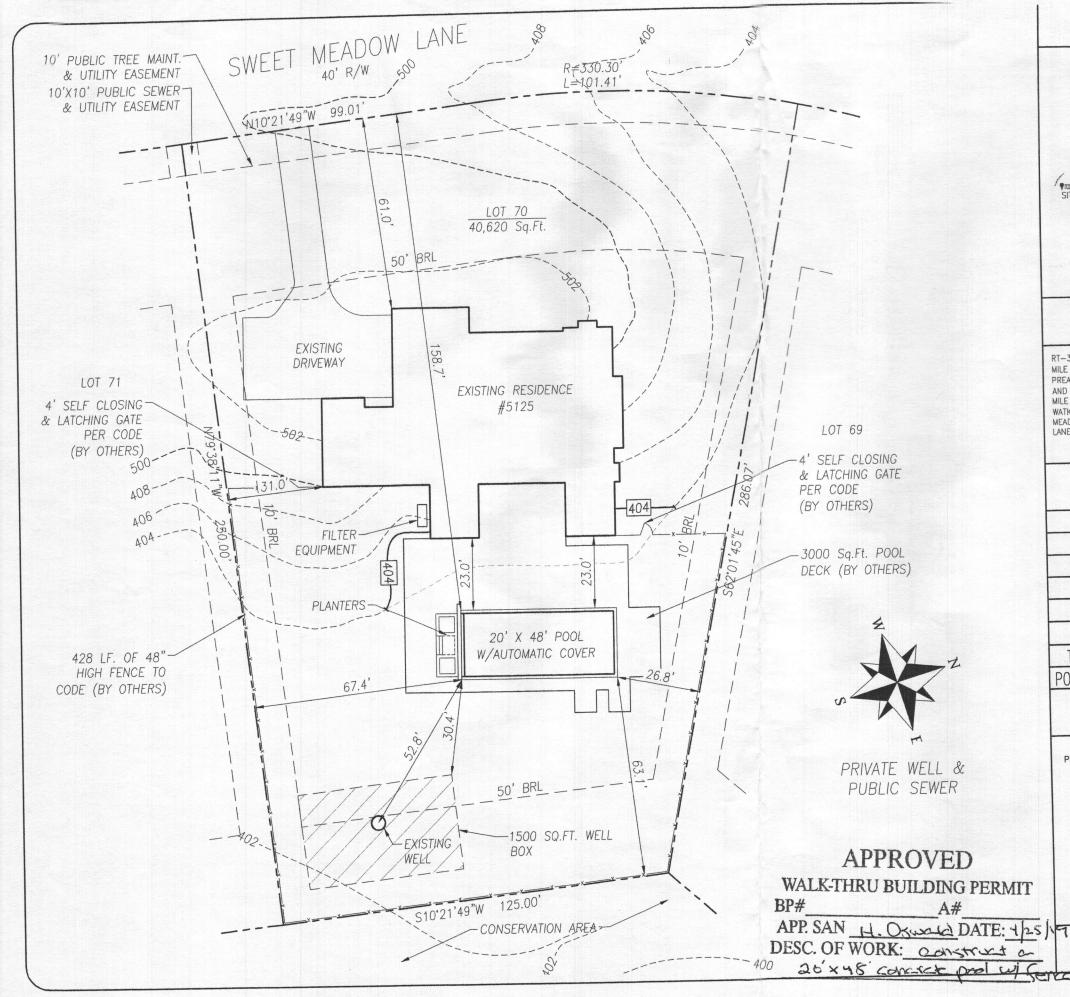

VICINITY MAP

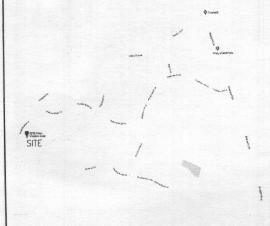

DIRECTIONS TO SITE

RT-32 TO EXIST ONTO RT-108E TOWARD COLUMBIA. FOLLOW 3/4 MILE TO L/T ON SHEPPARD LANE. FOLLOW 1 MILE TO L/T ON PREAKNESS CIRCLE LANE. FOLLOW 1/2 MILE TO TRAFFIC CIRCLE AND TAKE 1ST EXIT RIGHT ON WATKINS BRIDGE LANE. FOLLOW 1/4 MILE TO TRAFFIC CIRCLE AND TAKE 2ND EXIT RIGHT TO REMAIN ON WATKINS BRIDGE ROAD, FOLLOW 1/4 MILE TO L/T ON SWEET MEADOW LANE, FOLLOW TO SITE ON LEFT, 5215 SWEET MEADOW

POOL DATA

1		
1	DIMENSIONS	20'-0" X 48'-0" RECTANGL
Ī	PERIMETER	136 Ln.Ft.
I	SURFACE AREA	
1	GALLONAGE	38,500 Gallons
	DEPTHS	3'-6" TO 5'-0" TO 8'-6"
	FILTER RATE	80 GPM
	TURNOVER TIME	8 HOURS
94	POOL DECK AREA	

JOB NOTES

PROPERTY OWNER: PHILLIP & MARJORIE LAZZARI PROPERTY OWNER ADDRESS: 5125 SWEET MEADOW LANE CLARKSVILLE, MD 21171-8079

> HOME PHONE: OFFICE PHONE: CELL PHONE:

LOT NUMBER: 70 SUBDIVISION NAME: WALNUT GROVE TAX MAP: 28 GRID & PARCEL: GRID 18, PARCEL 74 TAX ACCOUNT NUMBER: 449340

ELECTION DISTRICT: 5

UTILITIES: PRIVATE WELL & PUBLIC SEWER

SITE PLAN

Galloway Pool Service, Inc.

REVISIONS

11710 Old Frederick Road Mariottsville, Maryland 21104

410-442-5005 (P) 866-000-0000 (F) 443-506-7043 (C)

Residence

5215 Sweet Meadow Lane Clarksville, Maryland 21029 Election District Howard Cour azzarı

4/20/2019 1"=30' Scale: JEK Drawn: GPS2018-0125 Of:

Sheet:

5th