



RECEIVED

APR 23 2019

LICENSES & PERMITS
DIVISION

* SEE
EMAIL

INV#572565

CK#2002

April 22, 2019

Ms. Cathy Anest
Chief, Licenses and Permits
Howard County, Maryland
3430 Court House Drive
Ellicott City, Maryland 21043

REF: Building Permit No. B18003848, 12541 Westland Court, Fulton, MD 20759
House Type Revision

Dear Ms. Anest,

On November 9, 2018, I applied for this residential building permit for the construction of a "Rutledge" house type, Elevation 5. Since that time, our buyer decided to finish the basement. Attached is the ~~Site Plan~~ and Architecture, as to be built.

Should you have any questions or require additional information, please do not hesitate to contact me at 410/997-8800 Ext. 20.

Sincerely,

Marina Morris
Administrator
THE WILLIAMSBURG GROUP L.L.C.



- REC ROOM W/WET BAR
- GAME ROOM
- BEDROOM
- FULL BATH
- MEDIA ROOM
- 2 UNFINISHED STORAGE RM
- UNFIN. MECH/STORAGE RM
- (SEE EMAIL)

CC: Health

Maryland's Award-Winning Homebuilder.

5485 HARPERS FARM ROAD SUITE 200 COLUMBIA, MARYLAND 21044
410-997-8800 FAX 410-997-4358 • WWW.WILLIAMSBURGLLC.COM • MHRB# 155



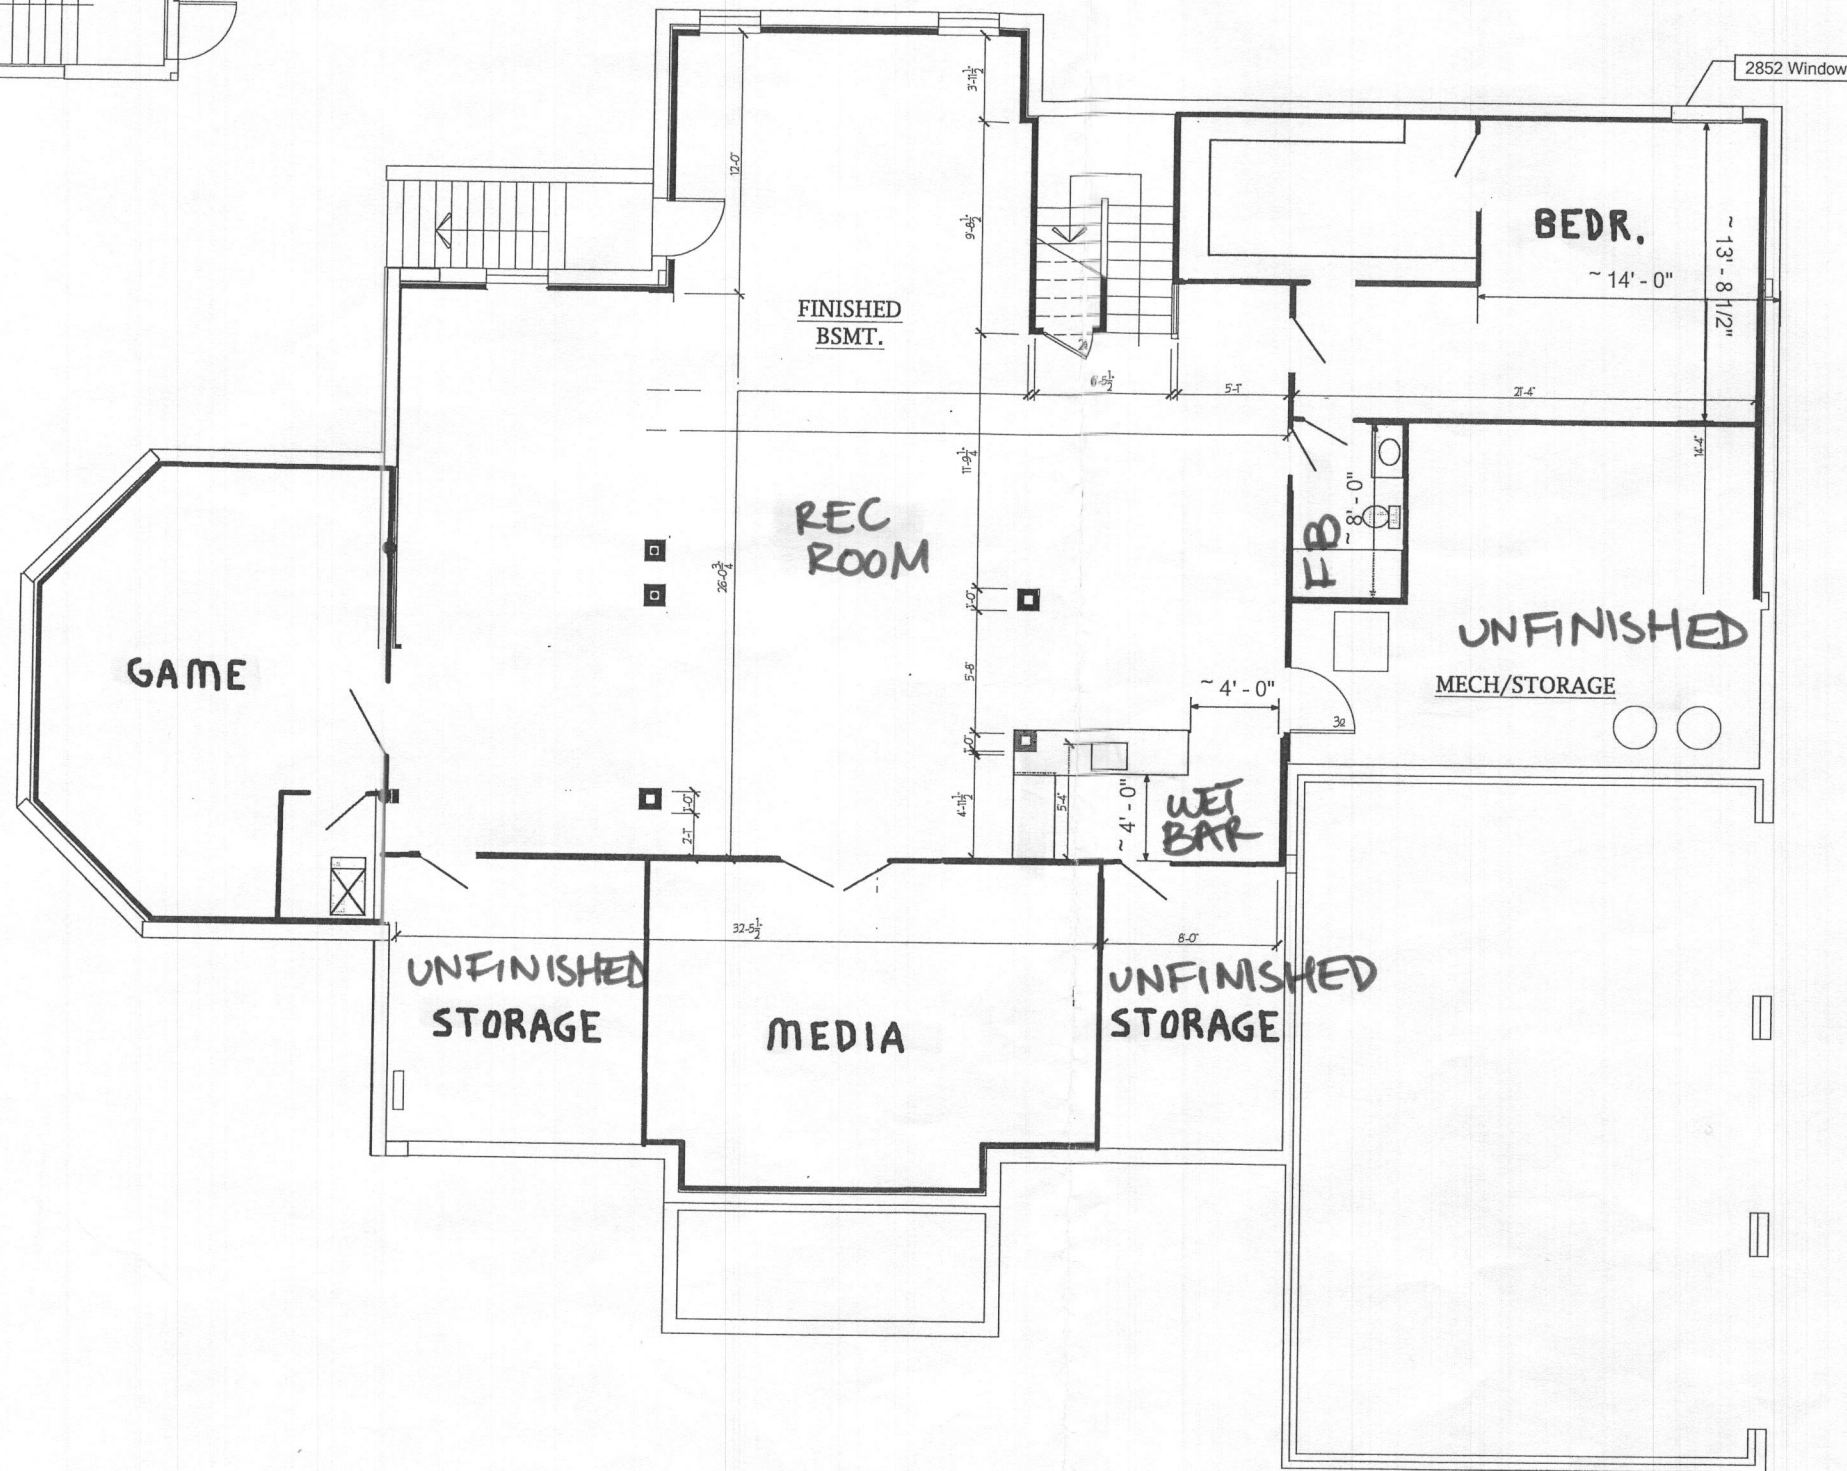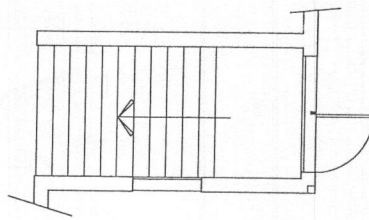

REVISED
Date: 4/22/19
Comments: B18003848
FINISH BASEMENT

Plymouth Road Architects
640 Plymouth Road, Catonsville, MD 21229 410-788-0281

DATE	REVISION

Date: 5/15	Scale: 1/4"=1'-0"	Drawn: TIM
------------	-------------------	------------

Drawing: FINISHED BASEMENT PLAN-1	Project: WILLIAMSBURG GROUP THE RUTLEDGE ESTATE HOME
-----------------------------------	--

1067RE Project No.

2b

REVISED 1/16