

C1 1699

SEQUENCE NO.
(DENY USE ONLY)STATE OF MARYLAND
WELL COMPLETION REPORT
FILL IN THIS FORM COMPLETELY
PLEASE PRINT OR TYPETHIS REPORT MUST BE SUBMITTED WITHIN
45 DAYS AFTER WELL IS COMPLETED.COUNTY
NUMBER

A 49915 K

ST/CO USE ONLY
DATE RECEIVED

DATE WELL COMPLETED

Depth of Well

PERMIT NO.
FROM "PERMIT TO DRILL WELL"

8 13

01/17/96

22 520 26
(TO NEAREST FOOT)28 29 30 31 32 33 34 35 36 37
H0-93-0217

OWNER

Demmitt

Richard

STREET OR RFD Summer Hill Dr

first name

TOWN

West Friendship

SUBDIVISION

Sabus Farms

SECTION

LOT

26

WELL LOG

Not required for driven wells

STATE THE KIND OF FORMATIONS
PENETRATED, THEIR COLOR, DEPTH,
THICKNESS AND IF WATER BEARINGDESCRIPTION (Use
additional sheets if needed)

FEET

FROM TO

Check
if water
bearingSand
Gray Mica
Rock

0 49

49 520

GROUTING RECORD

WELL HAS BEEN GROUTED

(Circle Appropriate Box)

TYPE OF GROUTING MATERIAL

CEMENT CM

BENTONITE CLAY BC

NO. OF BAGS 20

NO. OF POUNDS 180

GALLONS OF WATER

DEPTH OF GROUT SEAL (to nearest foot)

from 0 ft. to 49 ft.
(enter 0 if from surface)casing
types
insert
appropriate
code
below

CASING RECORD

ST CO
STEEL CONCRETE
PL OT
PLASTIC OTHERMAIN
CASING
TYPENominal diameter
top (main) casing
(nearest inch)Total depth
of main casing
(nearest foot)

SH

6

52

E
A
C
H
C
A
S
I
N
G

OTHER CASING (if used)

diameter
inchdepth (feet)
from toscreen type
or open hole

SCREEN RECORD

insert
appropriate
code
belowST BR HO
STEEL BRASS OPEN
BRONZE HOLE
PL PLASTIC OT OTHERIN HARD ROCK AREAS, IDENTIFY SPECIFICALLY
WHERE SATURATED FRACTURES WERE OBSERVED.

WELL HYDROFRACTURED

yes

Y

no

N

CIRCLE APPROPRIATE LETTER

A A WELL WAS ABANDONED AND SEALED
WHEN THIS WELL WAS COMPLETED

E ELECTRIC LOG OBTAINED

P TEST WELL CONVERTED TO PRODUCTION
WELLI HEREBY CERTIFY THAT THIS WELL HAS BEEN CONSTRUCTED IN
ACCORDANCE WITH COMAR 26.04.04 "WELL CONSTRUCTION"
AND IN CONFORMANCE WITH ALL CONDITIONS STATED IN THE
ABOVE CAPTIONED PERMIT, AND THAT THE INFORMATION PRE-
SENTED HEREIN IS ACCURATE AND COMPLETE TO THE BEST OF
MY KNOWLEDGE.

DRILLERS IDENT. NO.

24

DRILLERS SIGNATURE

(MUST MATCH SIGNATURE ON APPLICATION)

SITE SUPERVISOR (sign. of driller or journeyman
responsible for sitework if different from permittee)

GRAVEL PACK

IF WELL DRILLED WAS
FLOWING WELL INSERT
F IN BOX 68

MDE USE ONLY

(NOT TO BE FILLED IN BY DRILLER)

T

(E.R.O.S.)

W Q

70

72

74

75

76

TELESCOPE
CASINGLOG
INDICATOR

OTHER DATA

PUMPING TEST

HOURS PUMPED (nearest hour)

6

PUMPING RATE (gal. per min.
to nearest gal.)

2

METHOD USED TO
MEASURE PUMPING RATE

Bucket

WATER LEVEL (distance from land surface)

BEFORE PUMPING

37

WHEN PUMPING

366

TYPE OF PUMP USED (for test)

A air

P piston

T turbine

C centrifugal

R rotary

O other
(describe
below)

J jet

S submersible

PUMP INSTALLED

DRILLER WILL INSTALL PUMP

YES NO

(CIRCLE) (YES or NO)
IF DRILLER INSTALLS PUMP, THIS SECTION
MUST BE COMPLETED FOR ALL WELLS
EXCEPT HOME USE
TYPE OF PUMP INSTALLED
PLACE (A,C,J,P,R,S,T,O)
IN BOX - SEE ABOVE:CAPACITY:
GALLONS PER MINUTE
(to nearest gallon)

PUMP HORSE POWER

PUMP COLUMN LENGTH
(nearest ft.)CASING HEIGHT (circle appropriate box
and enter casing height)

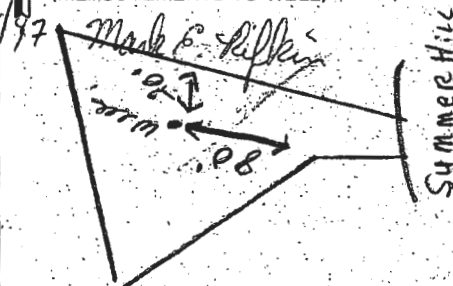
+ above

LAND SURFACE

- below

1 (nearest
foot)

LOCATION OF WELL ON LOT

SHOW PERMANENT STRUCTURE SUCH AS
BUILDING, SEPTIC TANKS, AND/OR
LANDMARKS AND INDICATE NOT LESS
THAN TWO DISTANCES
(MEASUREMENTS TO WELL)

COUNTY

B 1	1946	SEQUENCE NO. (MDE USE ONLY)	STATE OF MARYLAND PERMIT TO DRILL WELL please print or type	STATE PERMIT NUMBER H0-93-0217 fill in this form completely
Date Received (APA) 11-27-95 OWNER INFORMATION 15 Last Name Demmitt 13 Owner RICHARD 34 36 Street or RFD PO BOX 228 55 57 Town CLARKSVILLE 70 State 72 MD 74 Zip 76 21029				
DRILLER INFORMATION CIRCLE: MSD/MGD/MWD Driller's Name Joseph L. Mayne 77 License No. 80 24 Firm Name Joseph L. Mayne Well Drilling Address 5512 Ridge Rd. Mt. Airy MD 21771 Signature Joseph L. Mayne 11/27/95 Date				
B 2	WELL INFORMATION APPROX. PUMPING RATE (GAL PER MIN.) 5 AVERAGE DAILY QUANTITY NEEDED (GAL PER DAY) 500			
USE FOR WATER (CIRCLE APPROPRIATE BOX) ☒ HOME (SINGLE OR DOUBLE HOUSEHOLD UNIT ONLY) ☐ FARMING (LIVESTOCK WATERING & AGRICULTURAL IRRIGATION) ☐ INDUSTRIAL, COMMERCIAL, STATE AND FEDERAL GOV. ☐ OTHER (REQUIRES APPROPRIATION PERMIT) ☐ PUBLIC OR PRIVATE WATER COMPANY (REQUIRES APPROPRIATION PERMIT AND STATE HEALTH DEPARTMENT APPROVAL) ☐ TEST, OBSERVATION, MONITORING (MAY REQUIRE APPROPRIATION PERMIT)				
APPROXIMATE DEPTH OF WELL 300 FEET APPROXIMATE DIAMETER OF WELL 6 INCH NEAREST				
METHOD OF DRILLING (circle one) BORED (or Augered) ☒ JETTED ☐ Jetted & DRIVEN ☐ AIR-ROTARY ☒ AIR-PERCussion ☐ ROTARY (Hydraulic Rotary) ☐ CABLE ☐ REVerse-ROTary ☐ Drive-POINT ☐ other _____				
REPLACEMENT OR DEEPEMED WELLS (CIRCLE APPROPRIATE BOX) ☒ THIS WELL WILL NOT REPLACE AN EXISTING WELL ☐ THIS WELL WILL REPLACE A WELL THAT WILL BE ABANDONED AND SEALED ☐ THIS WELL WILL REPLACE A WELL THAT WILL BE USED AS A STANDBY-CONTACT LOCAL APPROVING AUTHORITY FOR POLICY ON STANDBY WELLS ☐ THIS WELL WILL DEEPEM AN EXISTING WELL PERMIT NUMBER OF WELL TO BE REPLACED OR DEEPEMED (IF AVAILABLE) _____				
Not to be filled in by driller (MDE OR COUNTY USE ONLY) APPROP. PERMIT NUMBER _____ FORCE ☒ WRITE INITIALS IN BOX PERMIT No. H0-93-0217				
SPECIAL CONDITIONS NOTE - APPROVING AUTHORITIES SHOULD USE SEPARATE SHEET IF NEEDED				

B 3	LOCATION OF WELL 8 COUNTY HOWARD 21 23 SUBDIVISION Sobus FARMS 42 SECTION 46 LOT 26 52 NEAREST TOWN WESTFRIENDSHIP 71 MILES FROM TOWN (enter 0 if in town) 1.5 MI			
B 4	DIRECTION OF WELL FROM TOWN (CIRCLE BOX) 			
NEAR WHAT ROAD Summer Hill Dr. ON WHICH SIDE OF ROAD (CIRCLE APPROPRIATE BOX) 34 260 37 DISTANCE FROM ROAD ENTER FT OR MI FT				
TAX MAP: _____ BLK: _____ PARCEL: _____				
NOT TO BE FILLED IN BY DRILLER HEALTH DEPARTMENT APPROVAL Howard A49915.K COUNTY NAME COUNTY NO. STATE SIGNATURE _____ DATE ISSUED 12/11/95 CO SIGNATURE Ch. W. ... EXP. DATE 12/10/96 NORTH GRID 531000 EAST GRID 0817000				
SHOW MAJOR FEATURES OF BOX & LOCATE WELL WITH AN X SOURCES OF DRILLING WATER 1. WELL 2. _____ 3. _____ WRITE THE BOX NUMBER FROM THE MAP HERE 8107 5301				
DRAW A SKETCH BELOW SHOWING LOCATION OF WELL IN RELATION TO NEARBY TOWNS AND ROADS AND GIVE DISTANCE FROM WELL TO NEAREST ROAD JUNCTION West Friendship MO. 44 Summer Hill Dr. Sobus Dr. W. Field Rd.				

HOWARD COUNTY HEALTH DEPARTMENT
Bureau of Environmental Health
3525-M Ellicott Mills Drive
Ellicott City, MD 21043

Fax 313-2648 • 313-2640

APPLICATION FOR PITLESS ADAPTER, WELL PUMP AND PRESSURE TANK INSTALLATION

New Installation ☒
Replacement ☐

Receipt #
Date

Name of Installer

ROBERT L. FEEZER CO. INC.

Telephone

781-4655

License Number

2122

Certified Well Pump Installer

Well Driller

Registered Plumber

Name of Property Owner

ALTIERI HOMES

Telephone

410-715-4500

Subdivision

YARLEY HUNT

Lot #

26

Well Tag #

40-93-0217

Site Address

SUMMER HILL DRIVE

Pump

1. Type

a. Deep well jet

b. Shallow well jet

c. Submersible ☒

2. Make

GOULD

3. Model #

SG310412

4. Capacity

5

GPM

5. Pump exceeds well capacity

Yes

No ☒

6. If Yes, is low pressure cutoff switch installed?

Yes

No ☒

7. What methods are used to protect the pump and electrical wiring from vibrations? Torque arrestors Cable guards ☒ Other

Motor

1. Horsepower

1/2

2. RPM

3450

3. Voltage

a. 110

b. 220 ☒

Pitless Adapter

1. Make

AM GRABBY

2. Model #

PT500

3. Depth

+ 42"

Tank

1. Capacity

2. Pressure relief valve? ☒

Piping

1. Type

PELETHYLENE

2. Size

1"

3. NSE and/or BOCA

Code approved

4. Depth of supply line

42" +

Well data

1. Depth

54 ft.

2. Yield

GPM

3. Static water level

ft.

4. Will water supply be disinfected by installer? ☒

I understand that it is my responsibility to notify the Howard County Health Department when the installation is ready for inspection (otherwise this permit is null and void).

All information given above is true to the best of my knowledge.

Signature of Applicant:

Date:

Note: A sticker indicating approval/status of the installation will be placed on the well casing at the time of the inspection.

