

WATER WELL ABANDONMENT-SEALING REPORT FORM

SUBMIT COPIES OF COMPLETED FORM TO:

- * COUNTY ENVIRONMENTAL AGENCY (contact MDE, WMA if address needed)
- * WELL OWNER
- * MDE, WATER MANAGEMENT ADMINISTRATION, WELL PROGRAM

DATE WELL ABANDONED: 11-11-19 (month/day/year)

* PERMIT NUMBER OF ABANDONED WELL (if any) _____

* PERMIT NUMBER OF REPLACEMENT WELL: _____

* PERSON ABANDONING WELL: RANDALL L. ALEXANDER WELL DRILLER'S LICENSE NUMBER: 576

* OWNER'S NAME: MARK WILSON

* WELL LOCATION: HOWARD
COUNTY: _____
NEAREST TOWN: CLARKSVILLE MD.
TAX MAP _____ BLOCK _____ PARCEL _____
SUBDIVISION: _____
SECTION: _____ LOT: _____
STREET ADDRESS: 12301 WAKE FOREST ROAD

LATITUDE 3 9 2 0 3 5 6 2

LONGITUDE 7 6 9 3 9 9 8 3

* TYPE OF WELL BEING ABANDONED:

☒ DRILLED ☐ JETTED
☐ BORED ☐ HAND DUG
☐ OTHER (specify) _____

* USE CODE:

☒ DOMESTIC ☐ MUNICIPAL/PUBLIC
☐ IRRIGATION ☐ INDUSTRIAL
☐ TEST/OBSERVATION ☐ GEOTHERMAL

* TYPE OF CASING:

☒ STEEL ☒ PLASTIC
☐ CONCRETE ☐ OTHER (specify) _____

MAIN CASING WAS STEEL. SOMEONE RAISED WELL WITH
A RUBBER COUPLERS AND P.V.C. PIPE.

SIZE OF CASING: 6 INCHES IN DIAMETER

DEPTH OF WELL: 70 FEET DEEP

WAS ANY CASING REMOVED? ☒ YES ☐ NO

If yes, length removed, in feet: 2 FT

WAS CASING RIPPED OR PERFORATED? ☐ YES ☒ NO

SIGNATURE-MASTER WELL DRILLER OR SUPERVISING SANITARIAN LICENSE#


COUNTY

THIS WELL WAS SEALED BECAUSE
MUNICIPAL WATER BECAME AVAILABLE.
PUMP LINES WERE PULLED FROM
WELL BEFORE WELL WAS
SEALED.

APPROVED
2/10/2019
[Signature]

CIRCLE: MWD MSD / MGD

SITE LOCATION MAP

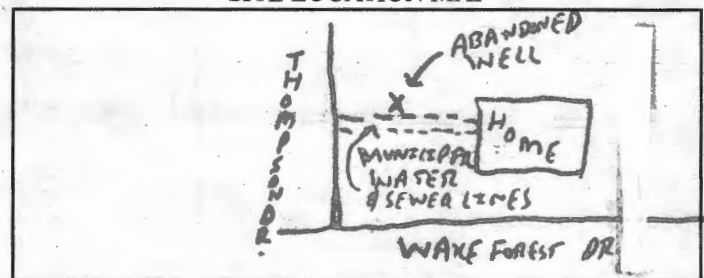

LOG OF SEALING MATERIAL

MATERIAL	FEET	
	FROM	TO
BENTONITE SLURRY	-70	0

VOLUME OF MATERIAL USED

(10) 50 LB BAGS OF BENEFAL BENTONITE
MIXED WITH 20 GALLONS OF WATER PER BAG

Pursuant to § 10-624 of the State Govt. Article of the Maryland Code, personal info requested on this form is used in processing this form pursuant to COMAR 26.04.04. Failure to provide the info may result in this form not being processed. You have the right to inspect, amend, or correct this form. The Maryland Department of the Environment is subject to the Maryland Public Information Act. This form may be made available on the Internet via MDE's website and is subject to inspection or copying, in whole or in part, by the public and other governmental agencies, if not protected by federal or State Law.

CIRCLE ONE MSD / MGS

11-11-19
DATE