

9/19/01  
NOON Repair

# PERMIT

SEWAGE DISPOSAL SYSTEM  
HOWARD COUNTY HEALTH DEPARTMENT  
BUREAU OF ENVIRONMENTAL HEALTH  
410-313-2640

P 514904

A REPAIR

ISSUE DATE 1/25/01

APPROVAL DATE 9/19/01

RPS#409454

INDEXED

Barnard Brothers

IS PERMITTED TO INSTALL ☐ ALTER ☒

ADDRESS \_\_\_\_\_ PHONE 410-489-7621

SUBDIVISION Ridgewood LOT NUMBER 26 ADDRESS 13307 Royden Court

PROPERTY OWNER Earl & Kimberly Scott PROPERTY OWNER'S ADDRESS Same

SEPTIC TANK CAPACITY EX. -OK GALLONS

PUMP CHAMBER CAPACITY \_\_\_\_\_ GALLONS

NUMBER OF BEDROOMS 5 w/finished addition

SQUARE FEET PER BEDROOM 180

LINEAR FEET OF TRENCH REQUIRED ~~225~~ 225' total req'd - 90' existing = 135'

TRENCHES: Trenches to be 2 feet wide. Inlet 4 feet below original grade. Bottom maximum depth

LOCATION: 8 feet below original grade. 4 feet of stone below distribution box.

REPAIR - PURPOSE - In support of Building Permit #B00126824

Call for inspection when ground is opened so sanitarian can recommend repair. 1/26/01

(2) 68' TRENCHES DOWNHILL OF EXISTING (MR)  
1 EX. 90' TRENCH TO BE ABANDONED

PLANS APPROVED \_\_\_\_\_ DATE \_\_\_\_\_

PERMIT VOID AFTER 2 YEARS

NOTE: CONTRACTOR RESPONSIBLE FOR SCHEDULING A PRE-CONSTRUCTION INSPECTION FOR ALL INSTALLATIONS

NOTE: TOP OF SEPTIC TANKS ARE TO BE NO DEEPER THAN 3.0 FEET BELOW FINISH GRADE

NOTE: WATERTIGHT SEPTIC TANKS REQUIRED

NOTE: CLEANOUT REQUIRED EVERY 70 FEET OF SEWER LINE AND/OR AT 90° SWEEPS IN LINES FROM HOUSE TO DRAIN FIELDS, 90° ELBOWS ARE NOT ACCEPTABLE

NOTE: ALL PARTS OF SEPTIC SYSTEMS (I.E. TANK, DISTRIBUTION BOX, DRAINFIELDS) TO BE 100 FEET FROM ANY WATER WELL UNLESS OTHERWISE SPECIFICALLY AUTHORIZED

NOTE: NO ABSORPTION TRENCH TO EXCEED 100 FEET IN LENGTH UNLESS SPECIFICALLY AUTHORIZED

NOTE: ALL PIPE FROM HOUSE TO SEPTIC TANK MUST BE CAST IRON OR SCHEDULE 35/40 PVC OR ABS

NOTE: MANHOLE RISERS REQUIRED ON ALL SEPTIC TANKS AND PUMP CHAMBERS

NOTE: DISTRIBUTION BOXES MUST HAVE BAFFLES

NOTE: IF PUMPED SEPTIC SYSTEM REQUIRED, (1) SEPTIC PUMP DETAIL TO BE PROVIDED BY INSTALLER PRIOR TO ISSUANCE OF SEPTIC PERMIT (2) PUMP PERFORMANCE TEST IS NECESSARY PRIOR TO HEALTH DEPARTMENT APPROVAL OF SEPTIC PERMIT


NEITHER THE HOWARD COUNTY COUNCIL NOR THE HEALTH DEPARTMENT IS RESPONSIBLE FOR THE SUCCESSFUL OPERATION OF ANY SYSTEM

PERMITTEE RESPONSIBLE FOR OBTAINING FINAL APPROVAL ON THIS PERMIT  
CALL 410-313-2640 FOR INSPECTION OF SEPTIC SYSTEM

SEW. PERMIT SIGNED  
AND RETURNED 10/17/01 B00132624  
Install 4G LP tank  
B00132860  
INGROUND POOL

P514904

NOT TO SCALE

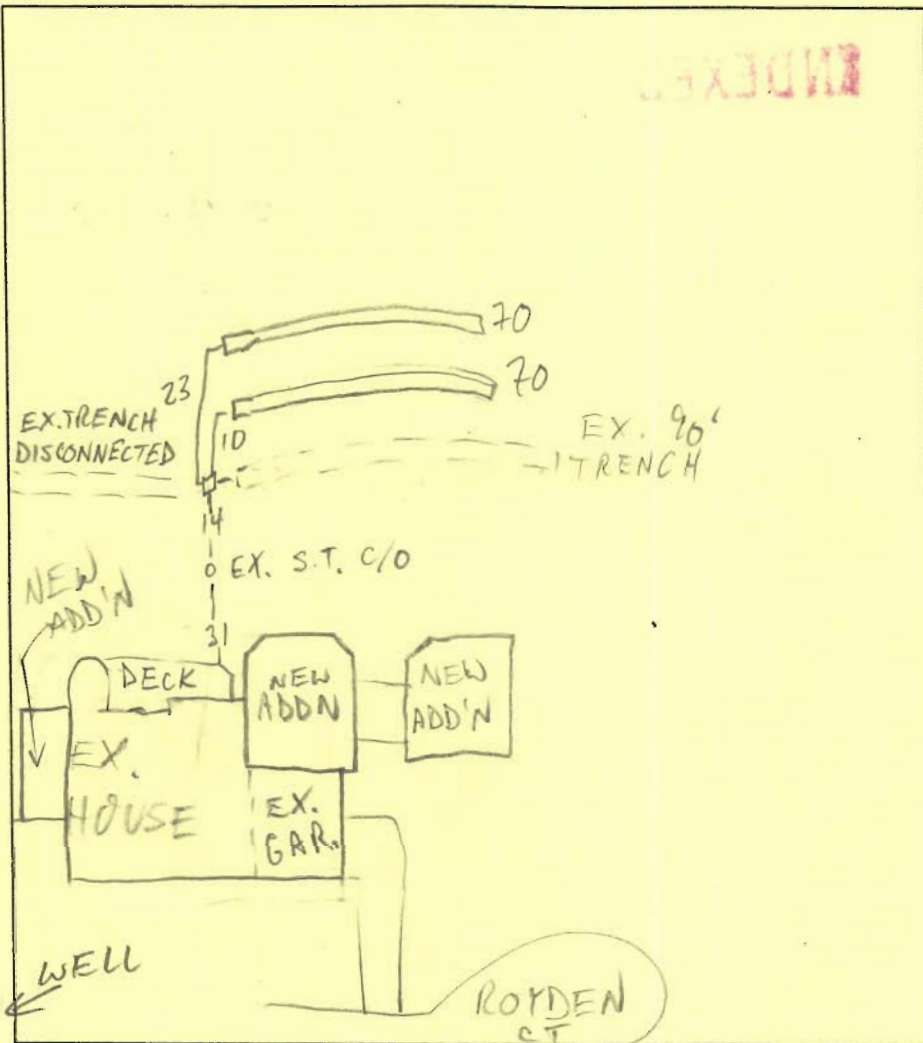

### TRENCH DATA

TRENCH WIDTH 2  
TRENCH INLET DEPTH 4  
TRENCH BOTTOM DEPTH 8  
DEPTH OF STONE 4  
NUMBER OF TRENCHES 2  
TOTAL TRENCH LENGTH EX. 90 + 140 = 230  
ABSORBENT AREA 920  
DISTRIBUTION BOX LEVEL EX.  
BAFFLE IN DISTRIBUTION BOX EX.

### SEPTIC TANK DATA

SEPTIC TANK \_\_\_\_\_ GALLONS  
MANHOLE RISER \_\_\_\_\_  
6 INCH INSPECTION PORT \_\_\_\_\_

### PUMP CHAMBER DATA


PUMP CHAMBER GALLONS \_\_\_\_\_  
MANHOLE RISER \_\_\_\_\_  
ALARM \_\_\_\_\_  
PUMP PERFORMANCE TEST \_\_\_\_\_

PRE-CONSTRUCTION INSPECTION: \_\_\_\_\_

INSPECTION COMMENTS: 9/19/01 OK TO COVER (MR)

INSPECTOR M. Rifkin DATE SYSTEM APPROVED 9/19/01



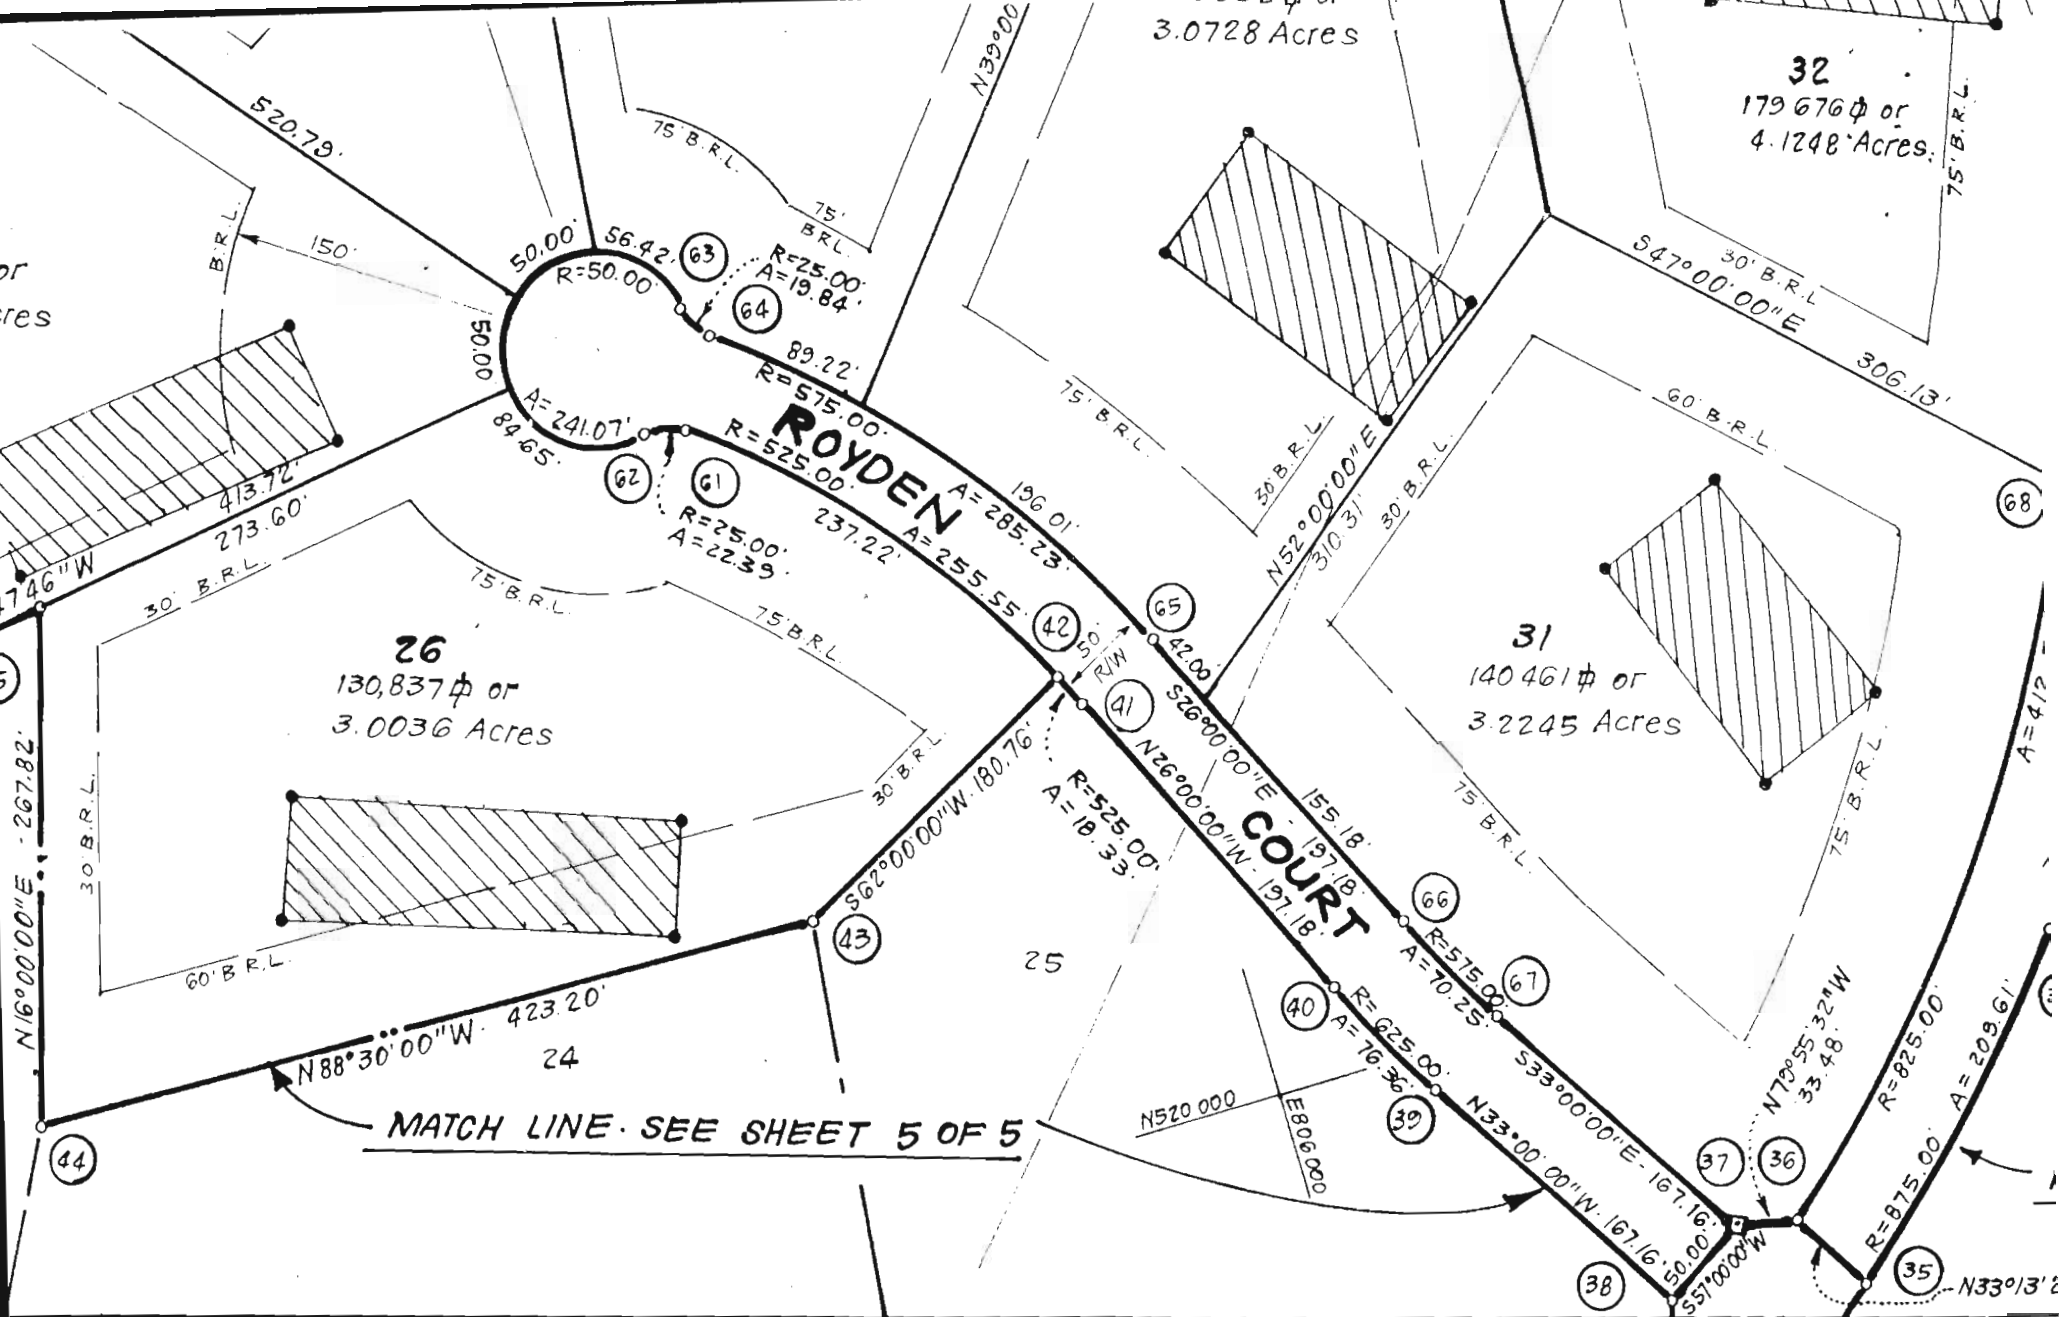

SEWERAGE  
TMENT.

### OWNER'S DEDICATION

We, Ridgewood Associates, owners of the property shown and described hereon, hereby adopt this plan of subdivision and in consideration of the approval of this Final Plat by the Office of Planning and Zoning, establish the minimum building restriction lines and grant unto Howard County, Maryland, its successors and assigns: (1) the right to lay, construct and maintain sewers, drains, water pipes, and other municipal utilities and services, in and under all roads and street right-of-ways and the specific easement areas shown hereon, (2) the right to require dedication for public use the beds of the streets and/or roads and flood plains and open space where applicable, and for good and other valuable consideration, hereby grant the right and option to Howard County, its successors and assigns.

### SURVEYOR'S CERTIFICATE

I, hereby certify that the Final Plat is a subdivision of part of the Estate of Royden A. Blunt to the Safe Deposit and Trust Company, dated March 30, 1988 and recorded in the Office of Howard County, Maryland in and that all monuments are in place.

8/24/88  
DATE