
	oward County ealth Department	Bureau of Environmental Health 8930 Stanford Boulevard, Columbia, MD 21045 Main: 410-313-2640 Fax: 410-313-2648 TDD 410-313-2323 Toll Free 1-866-313-6300 www.hchealth.org Facebook: www.facebook.com/hocohealth Maura J. Rossman, M.D., Health Officer	
RECEIPT D	ATE: 4/15/19 ONS	ITE SEWAGE DISPOSAL SYSTEM	
APPROVAL DATE: 10/31/19 PERMIT: CONSTRUCTION A			
PROPERTY ADDRESS: 13280 Triadelphia Mill Road			
SUBDIVISION: Jacks Landing			
CONTRACTOR:		EMAIL:PHONE:	
CONTRACTOR ADDRESS:			
CONTRACTOR CERTIFIED FOR BAT INSTALLATION: DMDE MANUFACTURER:			
PROPERTY OWNER: James Smith EMAIL:			
OWNER ADDRESS: 81 Country Manor Drive, Fredericksburg, MD 22400			
BAT UNIT MC	DEL: HOOT 600GPD BN		
OPERATION & MAINTENANCE AGREEMENT DATE SIGNED: DATE RECORDED:			
DISTRIBUTION SYSTEM: GRAVITY RESSURE DOSED BEDROOMS: 5 APPLICATION RATE: 0.8			
	LINEAR FEET REQUIRED:	INLET DEPTH: 4.0	
TRENCHES:	TRENCH WIDTH:	MAXIMUM BOTTOM DEPTH: 7.5	
	MINIMUM SPACE BETWEEN TRENCHES:	O EFFECTIVE AREA BEGINNING DEPTH: 4.5	
LOCATION:	PER APPROVED SITE PLAN.	SEWAGE DISPOSAL AREA AND BAT UNIT LOCATION MUST BE STAKED BY LICENSED	
LUCATION.	SURVEYOR PRIOR TO PRE-C	DNSTRUCTION INSPECTION.	
NOTES:			
NOTES.			
		UNIST & EVENATION DATE: 15/15/20	
ISSUED BY:	Robert Bricker	ISSUE DATE: 4//S/9 EXPIRATION DATE: 4//S/20	
NOTE: CONTRACTOR MUST SCHEDULE A PRE-CONSTRUCTION INSPECTION PRIOR TO BEGINNING ANY INSTALLATION			
NOTE: CON	NTRACTOR MUST SCHEDULE AN INSPECTION AND GAIN APPROVAL OF ALL COMPONENTS PRIOR TO COVERING ONE MUST BE APPROVED BY HEALTH DEPARTMENT AND GRAVEL TICKET MUST BE AVAILABLE FOR REVIEW.		
NOTE MAAT	AVATED TICHT SEDTIC TANKS REQUIRED		
NOTE: ALL	TE: ALL PARTS OF SEPTIC SYSTEM SHALL BE AT LEAST 100 FEET DOWNGRADIENT FROM ANY WATER WELL		
NOTE: MANHOLE RISERS REQUIRED ON ALL SEPTIC TANKS AND PUMP CHAMBERS NOTE: AN ELECTRICAL PERMIT IS REQUIRED FOR INSTALLATION OF ANY ELECTRICAL COMPONENTS OF THE SYSTEM			
THE REPORT OF THE PROPERTY AND THE PROPE			
NOTE: MDE RECOMMENDS SEPTIC TANKS, BAT, AND OTHER PRETREATMENT UNITS BE PUMPED AT A PREQUENCY ADEQUATE			
NEITHER THE HOWARD COUNTY COUNCIL NOR THE HEALTH DEPARTMENT IS RESPONSIBLE FOR THE			
SUCCESSFUL OPERATION OF ANY SYSTEM.			
PERMITTEE RESPONSIBLE FOR OBTAINING FINAL APPROVAL ON THIS PERMIT.			
	CAL	410-313-1771 TO SCHEDULE INSPECTIONS.	

NOT TO SCALE **TRENCH/DRAINFIELD DATA** WIDTH INLET BOTTOM 3 2.4 NUMBER OF TRENCHES TOTAL LENGTH ABSORPTION AREA 4% DISTRIBUTION BOX LEVEL NIA DISTRIBUTION BOX BAFFLE DISTRIBUTION BOX PORT _____ SEPTIC TANK DATA SEPTIC TANK 1 LEVEL MANUFACTURER MAYER BLOS SEE ATTACHED CAPACITY 600 BNR GAL SEAM LOC TOP ASBULLT TANK LID DEPTH 9 BAFFLES -00T BAFFLE FILTER HOOT MANHOLE LOC_ HOOT 0 6" PORT LOC **Q** WATERTIGHT TEST - SLOTTED Hoot DATE ON LID PUMP/SEPTIC TANK LEVEL MANUFACTURER CAPACITY _____ GAL SEAM LOC 5 + head on all laterals TANK LID DEPTH BAFFLES 10/31/19 P/A test restered. "4" loves above grade over 1"" lateral turn -ps. BAT start p ok. BAFFLE FILTER MANHOLE LOC 6" PORT LOC WATERTIGHT TEST SLOTTED **ROAD NAME** DATE ON LID PRE-CONSTRUCTION: 26/2019 CONFIRMED TANK, SDA, AND TRENCH STAKES FROM EVEYOR - REVIEWED PLAN SPECS. OK TO START. INSTALLATION: 4/29/2019 TREUCHES IN PROGRESS. TWO UPDER UPPER TRENGH (+) 4/30/2019 Cla DISTAL OR C/A COMPLETE COMPLET INSTALLED COVERED BEFORE INSPECTION OF LATERALS (P. S/8 DOIG SHE INSTALLED AND SEWER LINE FLECTRICAL BE ANI TNR INSTALLET NAIN) CONNECTING TANK 1Pr (Colubora MANIFOLT CIA-TURN UPS NOT PROTECTED. UNCOVER AND FINAL INSPECTOR DATE OF APPROVAL ____





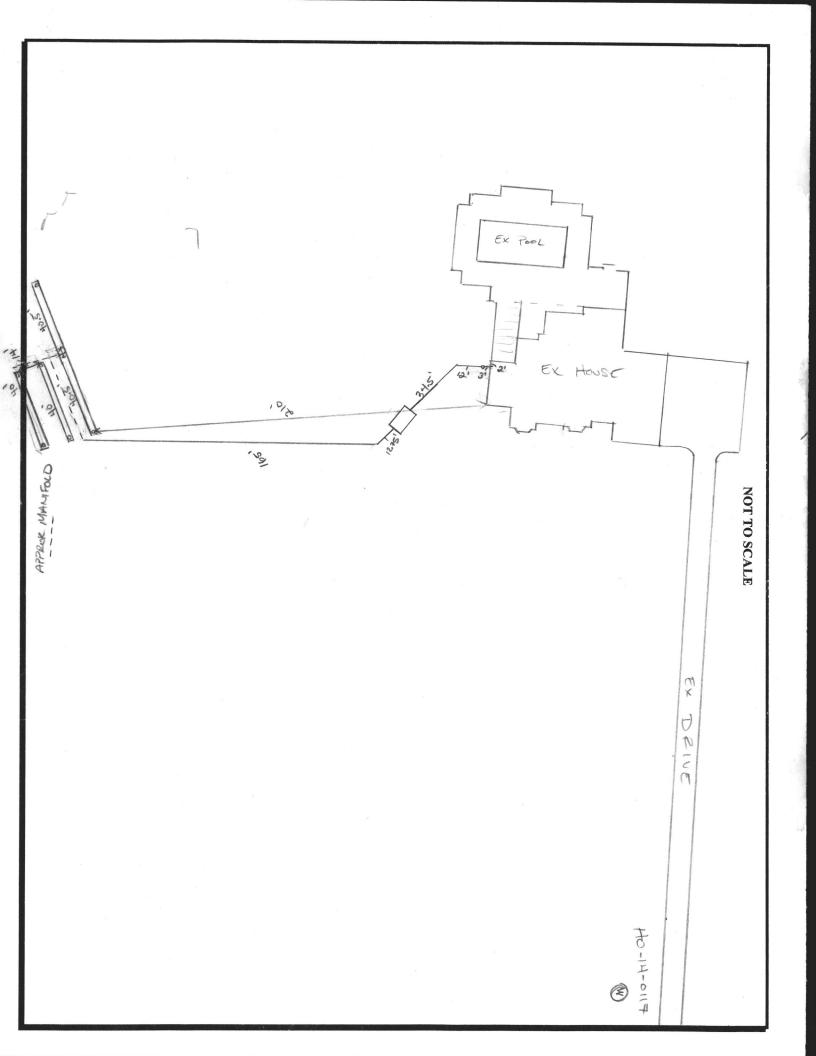

Bureau of Environmental Health 8930 Stanford Blvd | Columbia, MD 21045 410.313.2640 - Voice/Relay 410.313.2648 - Fax 1.866.313.6300 - Toll Free

Maura J. Rossman, M.D., Health Officer

20

20

OPERATION AND MAINTENANCE AGREEMENT FOR AN ON-SITE SEWAGE DISPOSAL SYSTEM HAVING AN ADVANCED PRE-TREATMENT SYSTEM

THIS AGREEMENT is made this 27 day of Nor M & , among orny. Janes. , hereinafter collectively referred to as "Owner", and the Howard County Health Department hereinafter referred to as the "County".

WHEREAS, Owner is the owner or contract owner of a parcel of land located at 13280 Triadellin Mill KI , in the Sth Election District of Howard County, Maryland, and the deed and subdivision plat of the property is recorded among the Land Records of Howard County, Maryland, Tax Map # 34, Block # 0, Parcel #5 99 78, Deed Reference # 17637 /14 and Tax Account # 05-59948 / ("the Property").

WHEREAS, The Property is suitable for the installation of a conventional on-site sewage disposal system with an advanced pre-treatment system, utilizing best available technology to perform nitrogen reduction, in accordance with the Code of Maryland Regulations 26.04.02.07, effective November 24, 2016. The pre-treatment device being installed is HOOT GOO RNR.

NOW, THEREFORE, the parties hereto agree as follows:

A. Owner hereby grants to the County the right to enter upon the Property at any reasonable time with prior notice for access to the system to make periodic inspections and the Owner agrees to provide any information and data in Owner's possession reasonably requested and needed by the County.

B. Owner acknowledges and agrees that neither the County nor any of its agents or employees, either officially or individually, underwrites the operation of any system approved by them.

C. The Owner will devote reasonable care and effort to the operation and maintenance of the system in perpetuity or until a public sewer connection is made so that a system malfunction is not the result of poor maintenance, faulty operation, or neglect.

D. The Owner agrees to enter into a contract reasonably acceptable to the Owner and the County with a private entity to operate and maintain on a regularly scheduled basis an approved 027 advanced pre-treatment system. The owner shall supply a copy of the contract to the County Recording F Name: 1

when it is renewed or altered. Agreement fee

CCB5-B3-F85 Website: www.hchealth.org Facebook: www.facebook.com/hocohealth ŝ 5 JAW 4/23/18 T

the property is in existence and after installation of the system. Owner further agrees that they shall inform in writing any subsequent purchaser or lessee of the Property that the system shall require maintenance or other attention. Upon taking title to the Property, the Owner agrees to cause this agreement to be recorded in the Land Records of Howard County and assure that it becomes part of the Deed for the subject property in order that prospective buyers may be aware of the special conditions affecting this property.

F. This agreement shall not be construed to limit any authority of the County to protect the public health, safety or comfort or to issue any other orders to take any other action which is now or may hereafter be within its authority.

G. This agreement may be voided at any time at the discretion of the County.

H. This agreement contains the entire agreement and understanding between the County and the Owner. There are no additional terms other than as contained in this agreement. This agreement may not be modified, except in writing signed by each of the parties or by their authorized representatives.

I. The laws of the State of Maryland govern the provisions of all transactions pursuant to this agreement.

J. Owner acknowledges and agrees that interior renovations to increase the number of bedrooms or an increase in living space shall not be permitted without approval from the County.

IN WITNESS WHEREOF, the parties have signed this agreement on the date indicated above.

Howard County Health Department

Owner# Signature

Owner #1 Print Name

Buyer #1 Signature

Date

Owner#2 Signature Date


Owner #2 Print Name

Buyer #2 Signature

Date

Buyer #1 Print Name

Buyer #2 Print Name

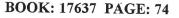

AFTER RECORDING RETURN TO: James Smith Jacks Landing Road 13 acre parcel Clarksville, MD 21029

Tax ID#:

/13/2017 01:42 PM Csh 0045 Reg 0048 T/Ref 0048109229 Grp 000001 R/Lne 000001 01 - Main Location \$3,125.00 Validation Number: 0048-123023 DOCUMEROPPRETARE_1879.10-130000000-999999 981289998 Group, LLC 8737 Colesville Ridger, Suffe 20287 SilveDSpringpMDD20940 File Numberle19584281\$Sount: \$625,000.00

This Deed, MADE THIS 27th day of February, 2017, by and between Marty Howard, and FAL Properties, LLC, a Maryland Corporation, as Lot Developer, party of the first part, and James Smith, party of the second part.

WITNESSETH, That in consideration of the sum of SIX HUNDRED TWENTY FIVE THOUSAND AND 00/100 DOLLARS (\$625,000.00), the receipt of which is hereby acknowledged, the said party of the first part does grant and convey to the said party of the second part, in fee simple, all that parcel of ground situated in Howard County, Maryland and as described as follows, that is to say:

Parcel "A" consisting of 13.1894 acres in the subdivision known as "JACK'S LANDING, PHASE 1" per Plat recorded among the Land Records of Howard County, Maryland in Plat Book 23954.

The improvements thereon being known as 13280 Triadelphia Mill Road, Clarksville, Maryland 21029.

Tax ID#: 05-599487

BEING part of the same property which by deed dated February 16, 1994 and recorded among the Land Records of Howard County, Maryland in Liber No. 3172, folio 336, was granted and conveyed by Samuel T. Nichols, Jr. and Janet D. Nichols, his wife and James S. Nichols and G. Dale Nichols, his wife unto Marty Anthony Howard.

TOGETHER with the buildings thereupon, and the rights, alleys, ways, waters, privileges, appurtenances and advantages thereto belonging, or in anywise appertaining.

SUBJECT TO all rights, easements, restrictions, covenants and reservations of record.

TO HAVE AND TO HOLD the said described lot(s) of ground and premises to the said party of the second part, as sole owner, his personal representatives, heirs and assigns, in fee simple.

Buyers' Initials:

02:31

CC13-SE

5

435.00

CC05_03_04

Xel

ŝ

125.

00

Transfer d 8,250.00

9,435.

90

AND the said party of the first part does hereby covenant that he has not done or suffered to be done any act, matter or thing whatsoever to encumber the property hereby conveyed; that he will warrant specially the property hereby granted; and that he will execute such further assurances of the same as may be requisited; and that hereby granted; be requisited a constant 11: 33/21017 County linked

5 State ₩. ₩. (with Taxes) 2 no RT 20. Taxes) 40.002 20

ST. DEPT. ASSMTS. & TAX Ag. Transfer Tax Due In The Amount Qf: \$ 23 437 .50

119



MAYER BROS., INC. Precast Concrete Products

6264 Race Rd. Elkridge, MD 21075

Letter of Satisfaction Hoot System Installation

Address of Property: 1328	Tridelphia mill Rd.
	ille, mp 21029
Date of Final Inspection: 10/	31/19 201 Jr. Inc.

Hoot Technician/Inspector: Mike Sample

I hereby certify that the Hoot system installed at the property listed above has been installed according to proper Hoot installation practices. I have also verified the startup of the system and it is in proper working order.

Sincerely,

N.m Name of Inspector Mayer Bros. Inc.

PH: 410-796-1434 FX: 410-796-1438

WBE NPCA Certified Plant

mayerbro@connext.net www.mayerbrosprecast.com

Grease Interceptors, Grunze Solutions, Asrobic Treatment Units, Septie Tanks, Holding Tanks, Storm Water Structures, Hydroceptors, Benck Barrier, Water Meter Vaults, Sectional Valvo Vaults, Top Slaks, Carb Benedes, Carb Bennpers, PernaEntry Basement Entries, Support With Carting Proceedings.

