

APPLICATION

PERCOLATION TESTING

HOWARD COUNTY HEALTH DEPARTMENT
BUREAU OF ENVIRONMENTAL HEALTH
P.O. BOX 476 ELLICOTT CITY, MARYLAND 21043
TELEPHONE: 461-9933

5-27-87
Perks ok pending
plat approval JEN

A 38862

P _____

DISTRICT _____

DATE 2/26/87

TO: THE COUNTY HEALTH OFFICER
ELLICOTT CITY, MARYLAND

I, HEREBY, APPLY FOR THE NECESSARY TEST IN ORDER TO CONSTRUCT (OR RECONSTRUCT) A SEWAGE DISPOSAL SYSTEM.

PROPERTY OWNER Royden A. Blunt DC FAKUNLE Abaydomi
c/o F.A.M. Equities, Inc. 233 E. Redwood Street.
ADDRESS Baltimore, MD 21202 PHONE 922-0240

PROSPECTIVE BUYER F.A.M. Equities, Inc.
802 Garrett Bldg., 233 E. Redwood Street
ADDRESS Baltimore, MD 21202 PHONE 301-685-8588

PROPERTY LOCATION: Intersection of Rt. 32 and Folly Quarter Road

SUBDIVISION Ridgewood LOT NO. 18

ROAD AND DESCRIPTION Public CT. A

TAX MAP 22 PARCEL # 160
SIZE OF LOT 3.0 AC TYPE BLDG. Single Family - 5 Bm
(SINGLE FAMILY DWELLING OR COMMERCIAL)

BLDG. PERMIT SIGNED
AND RETURNED 10/28/84
Serial # 56823-510-

THE SYSTEM INSTALLED UNDER THIS APPLICATION IS ACCEPTABLE ONLY UNTIL PUBLIC FACILITIES BECOME AVAILABLE. I FULLY UNDERSTAND THE

FEE CONNECTED WITH THE FILING OF THIS PERC TEST APPLICATION IS NON-REFUNDABLE UNDER ANY CIRCUMSTANCES. I ALSO AGREE TO COMPLY

WITH ALL M.O.S.H.A. REQUIREMENTS IN TESTING THIS LOT. Wigand H. Theimer (Agent for F.A.M. Ea.)
(SIGNATURE OF APPLICANT)

APPROVED BY _____ FOR _____ DATE _____

REJECTED BY _____ FOR _____ DATE _____

HOLD PENDING FURTHER TESTS _____ DATE _____


REASONS FOR REJECTION OR HOLDING for plat location & subdivision plat approval

THIS IS NOT A PERMIT

X=3m7N
INLET 4'
MAX D 8'
1875/BSO

SOIL PROFILE

0-3.0	Orange br si lm
3.0-6.5	Yellow-red si lm
6.5-13.0	Br micaceous si lm, 4-10% Saprolite
13.0	Bottom

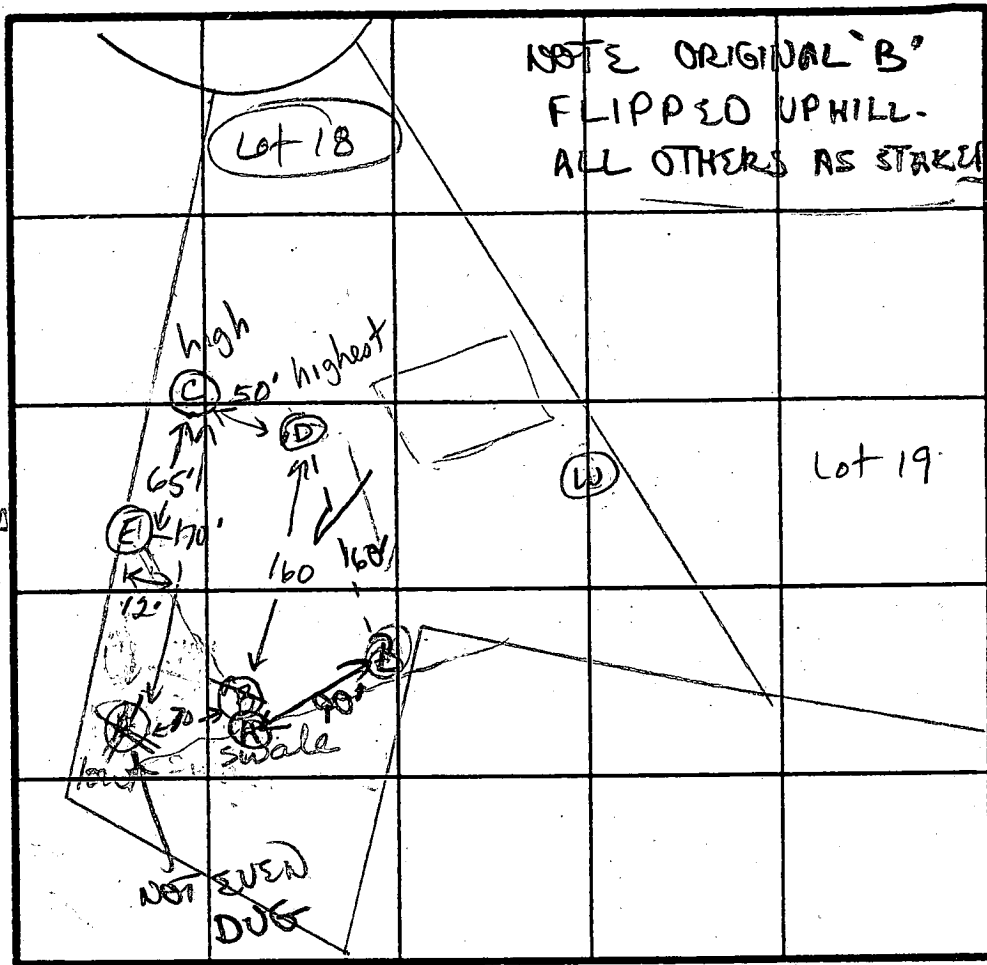

(B)
0-3.0 Rd br si
lm

3.0-6.0 Br-yellow
micaceous
si lm

6.0-13.0 Rd-br
micaceous
si lm

13.0 Bottom

(A)

0-3.5 Rd br si
loam

3.5-6.5 Yellow br
micaceous
si loam

6.5-12.5 Rd br
si lm,
10% sap.
12.5 Bottom

(C)
0-3.0 Rd br si
lm

3.0-5.0 Yellow
br si
sa lm

5.0-14.0 Red-
Yellow
micaceous
si lm
4-10%
saprolite

14.0 Bottom

(E)

0-6.0 Orange br
si lm

6.0-12.5 Br micas
si lm, 25%
saprolite

12.5 Bottom

INDICATE NORTH - NAME ADJOINING ROADWAY AS BASE LINE.
TRIADELPHIA ROAD

DATE	TEST NO.	DEPTH	PRE-WET		TEST - 1" DROP		TIME	
			START	STOP	START	STOP		
5-27-8	D	3.5 S	10:34	10:36	10:36	10:38	2min	ok
		6.5 M	10:38	10:40	10:40	10:42	2min	ok
		13.0 D	bottom	(see profile)				
	C	4.0 S	10:49	10:51	10:51	10:54	3min	ok
		14.0 D	bottom	(see profile)				
	B	3.5 S	10:56	10:58	10:58	11:00	2min	ok
		13.0 D	bottom	(see profile)				
	A	3.5 S	11:01	11:06	11:06	11:11	5min	ok
		6.5 M	11:01	11:03	11:03	11:06	3min	ok
		12.5 D	bottom	(see profile)				

E 12.5 V bottom see (profile) (C) new ok

REMARKS Holes (C) (D) as shown on plat. (A) moved up slope. (B) moved up slope.

TYPE OF SOIL Rd br si lm; Yellow-br micaceous si lm, Rd br mic. si lm 4-10% saprol.

TESTED BY J. Nordean / B. Nixon

ALSO PRESENT Chris Neil, Jeffery