
APPLICATION

PERCOLATION TESTING A 516525 HOWARD COUNTY HEALTH DEPARTMENT DISTRICT BUREAU OF ENVIRONMENTAL HEALTH 3525-H ELLICOTT MILLS DRIVE/ELLICOTT CITY, MARYLAND 21043 DATE **TELEPHONE: 313-2640** TO: THE COUNTY HEALTH OFFICER ELLICOTT CITY, MARYLAND I HEREBY APPLY FOR THE NECESSARY TEST PRIOR TO APPLICATION FOR PERMIT TO CONSTRUCT (OR RECONSTRUCT) A SEWAGE DISPOSAL S' PROPERTY LOCATION: THE SYSTEM INSTALLED UNDER THIS APPLICATION IS ACCEPTABLE ONLY UNTIL PUBLIC FACILITIES BECOME AVAILABLE. I FULLY UNDERST FEE CONNECTED WITH THE FILING OF THIS PERC TEST APPLICATION IS NON-REFUNDABLE UNDER ANY CIRCUMSTANCES. I ALSO AC COMPLY WITH ALL M.O.S.H.A. REQUIREMENTS IN TESTING THIS LOT. APPROVED BY HOLD PENDING FURTHER TESTS. REASONS FOR REJECTION OR HOLDING. PERCOLATION TEST PLAT/PRELIMINARY PLAT - TITLE OR I.D. # DATE SITE DEVELOPMENT PLANFINAL PLAT - TITLE OR I.D. #_ DATE

THIS IS NOT A PERMIT

HD-216 (3/92)

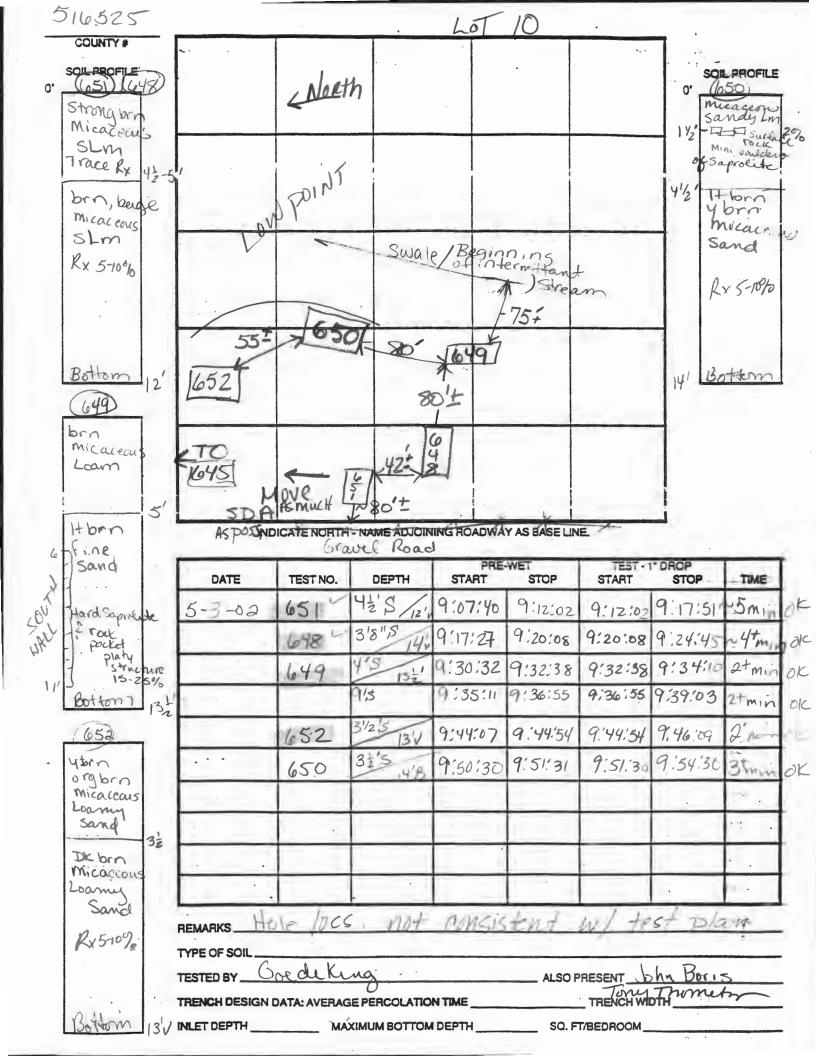

Signed P. cert 5/03 638D LOT 9 MON-BUILDABLE
PRESERVATION
PARCEL 'C'
Howard County Oung
and Hainfained
and Hainfained
(18) 442, 795+2 643 LOT 10 Lot 10 Final NON-BUILDABLE 6600 659 HOREBUILDABLE