


38862 A

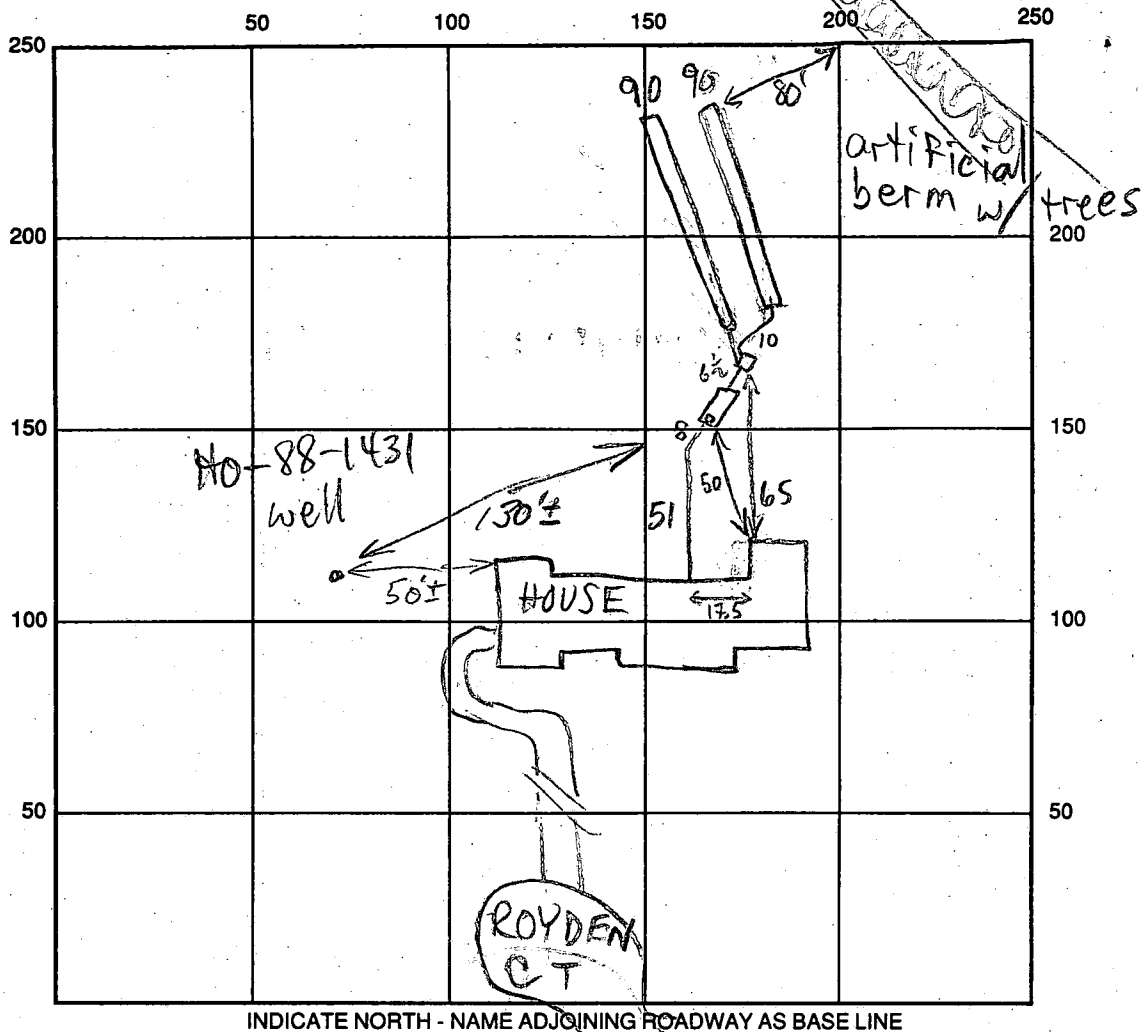

SEPTIC TANK LEVEL 1500 GAL-OK

CLEANOUTS S.T.-OK

DISTRIBUTION BOX LEVEL OK - BAFFLE IN

DRAIN FIELD/TITLE DEPTH 8.5/8.5 FT.

TRENCH WIDTH 2 FT.

INLET DEPTH 3.5/3.5 FT.

EFFECTIVE GRAVEL DEPTH 5/5 FT.

TOTAL LENGTH 2 @ 90 FT.

NUMBER OF TRENCHES 2

ONE SIDEWALL/BOTTOM AREA 2 @ 450 SQ. FT.

DRYWALL INSIDE DIAMETER — FT.

EFFECTIVE DEPTH BELOW INLET — FT.

ABSORBENT AREA 900 SQ. FT.

REMARKS: 5/5/95 TRENCHES 20' LOWER THAN SPECS DUE TO PLUMBING (THAT IS, HOUSE LOWER THAN ELEV. ON PLAN?) PER CONTRACTOR; MEASUREMENTS ON SITE PLAN INDICATE 35' IS MUCH MORE ACCURATE, BUT SUFF. ROOM REMAINING FOR 2 REPAIRS MRL

DATE SYSTEM APPROVED


5/5/95

INSPECTOR

M. REPKE

NOTES:

1. TOPOGRAPHY TAKEN FROM PRELIMINARY PLAN FOR 'RIDGEWOOD' DATED 10-5-87.
2. DIMENSIONS OF INFILTRATION TRENCH IN SEPTIC FIELD TO BE DETERMINED BY HOWARD COUNTY HEALTH DEPARTMENT.

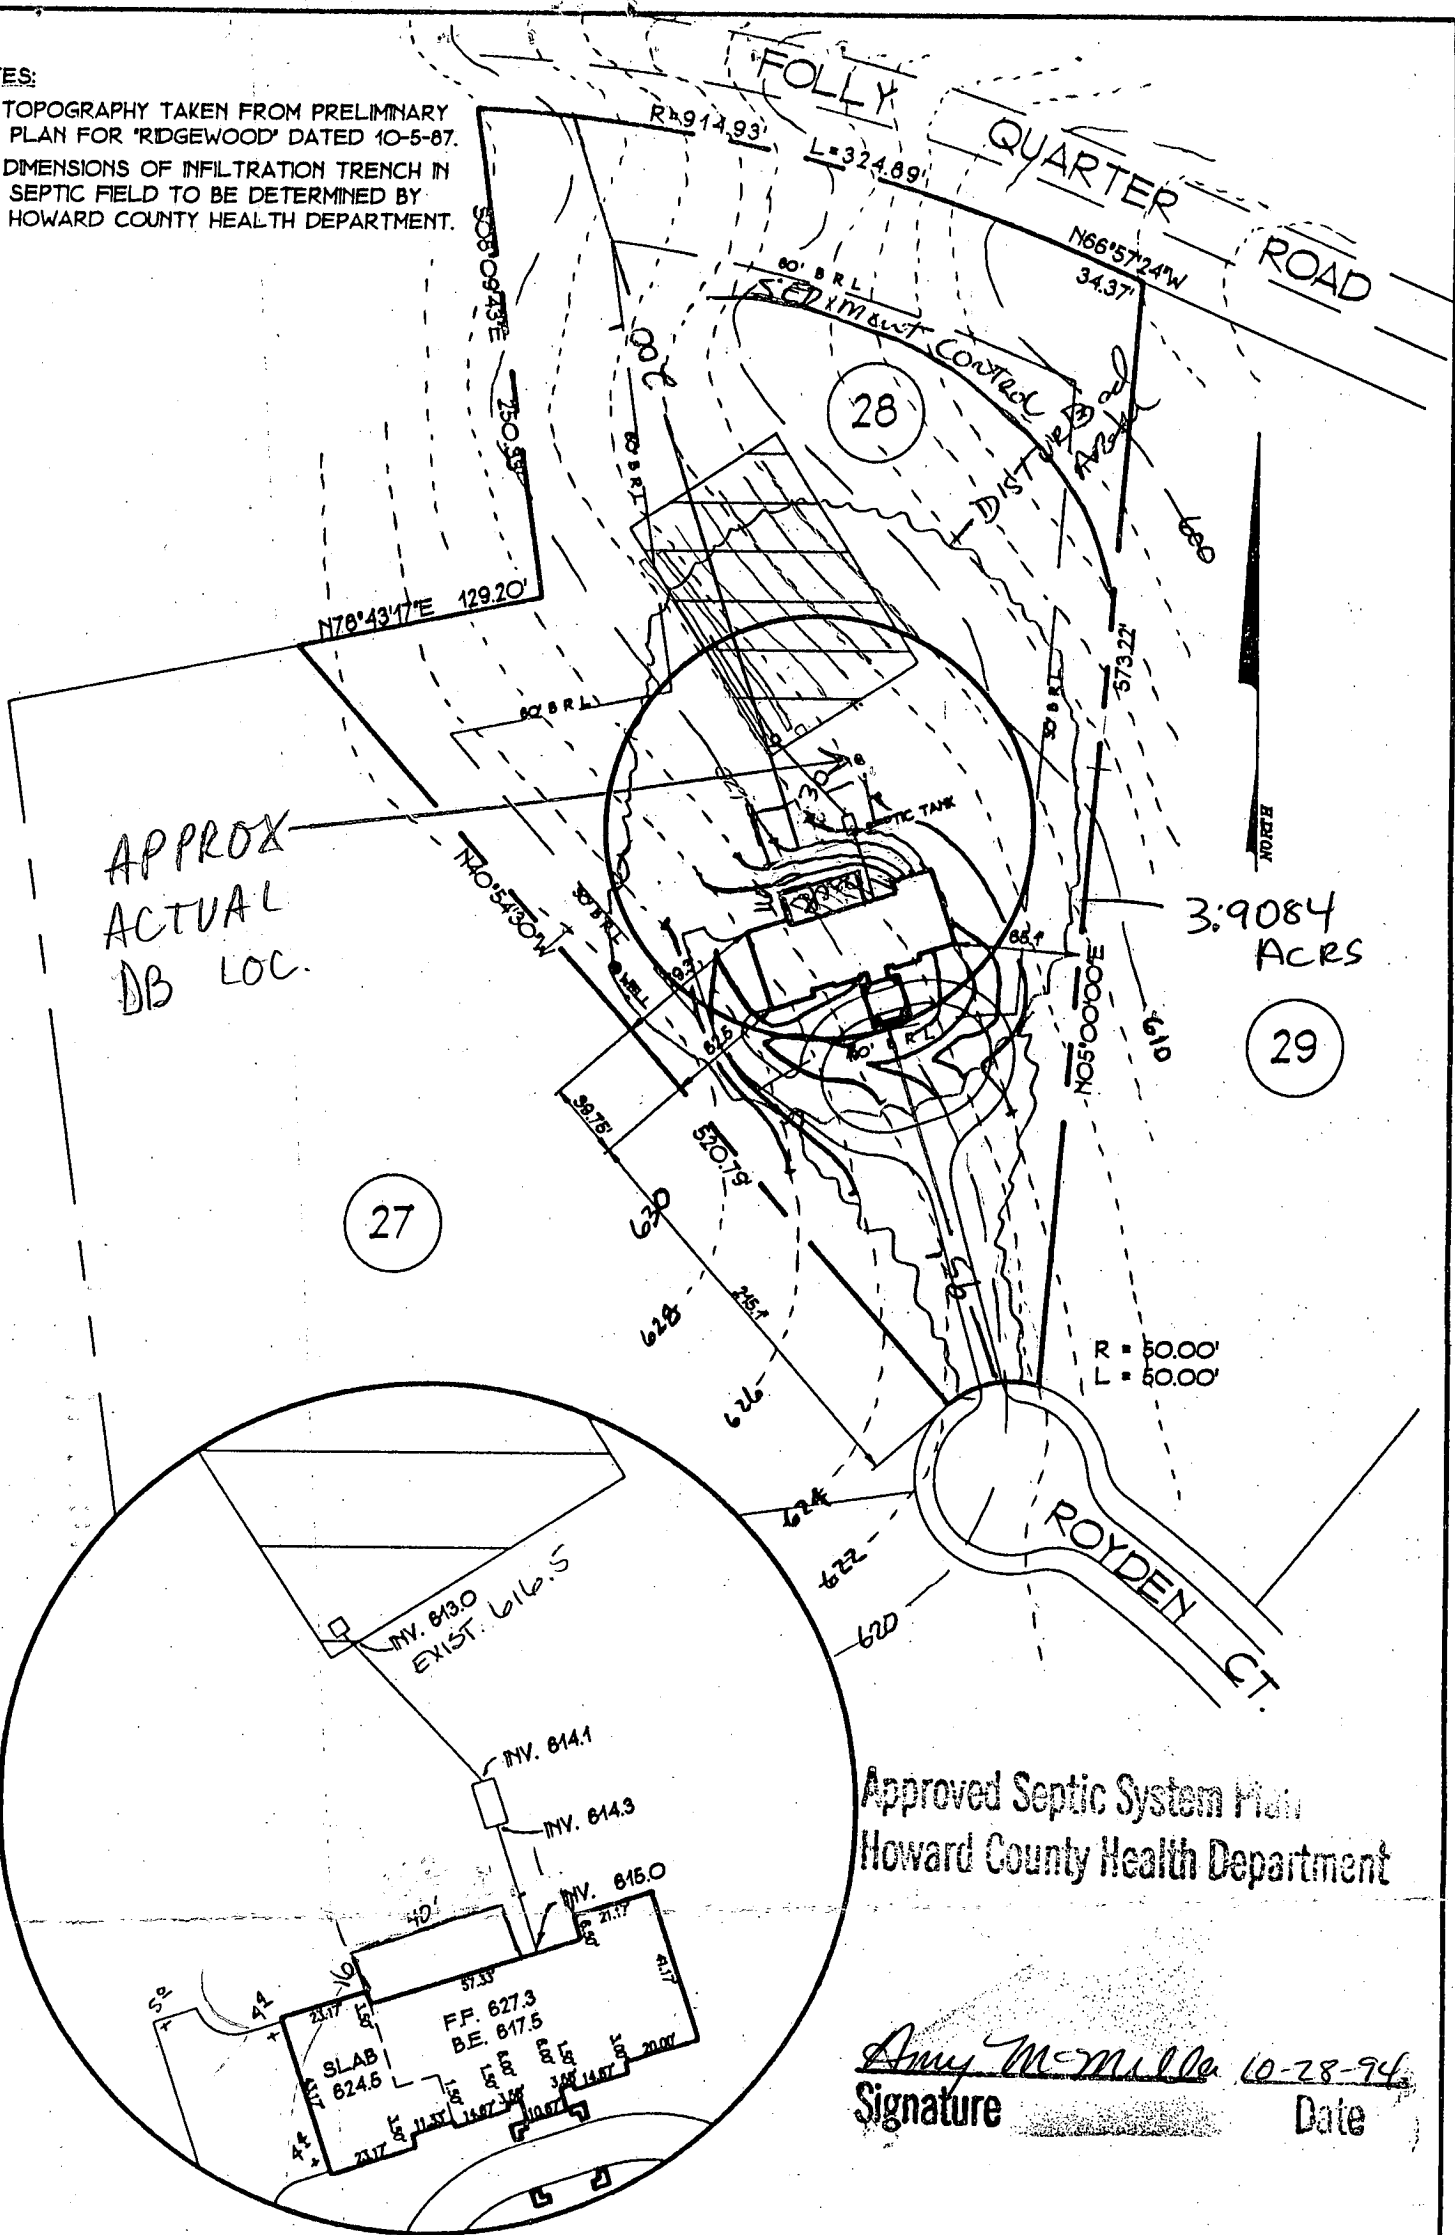

Approved Septic System Plan
Howard County Health Department

Amy McMillan 10-28-94
Signature Date

PREPARED BY:

MILLER & ASSOCIATES
13054 TARRAGON ROAD
REISTERSTOWN, MARYLAND 21136
(410) 633-5905

PREPARED FOR:

FAKULE RESIDENCE
B. & H. C. OF MD., INC.
219 DELIGHT MEADOW RD.
REISTERSTOWN, MARYLAND 21136
(410) 526-0023

DATE: 9-27-94

SCALE: 1" = 50'


SITE GRADING PLAN

FOR

LOT 28
'RIDGEWOOD'
PLAT #8089

END OF CUL-DE-SAC ROYDEN COURT
HOWARD COUNTY

MARYLAND

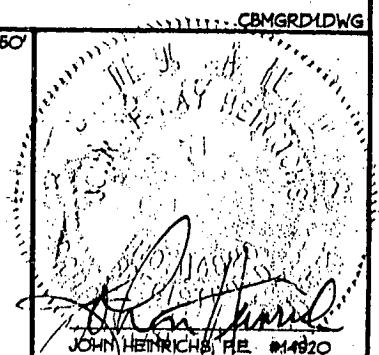


D.A. BRYANT
L. 739! F. 130

TRIADELP
ROAD

THE CORNERS
P.B. 30
P. 40

FOLLY QUARTER

Vehicular Ingress & Egress is Restricted.

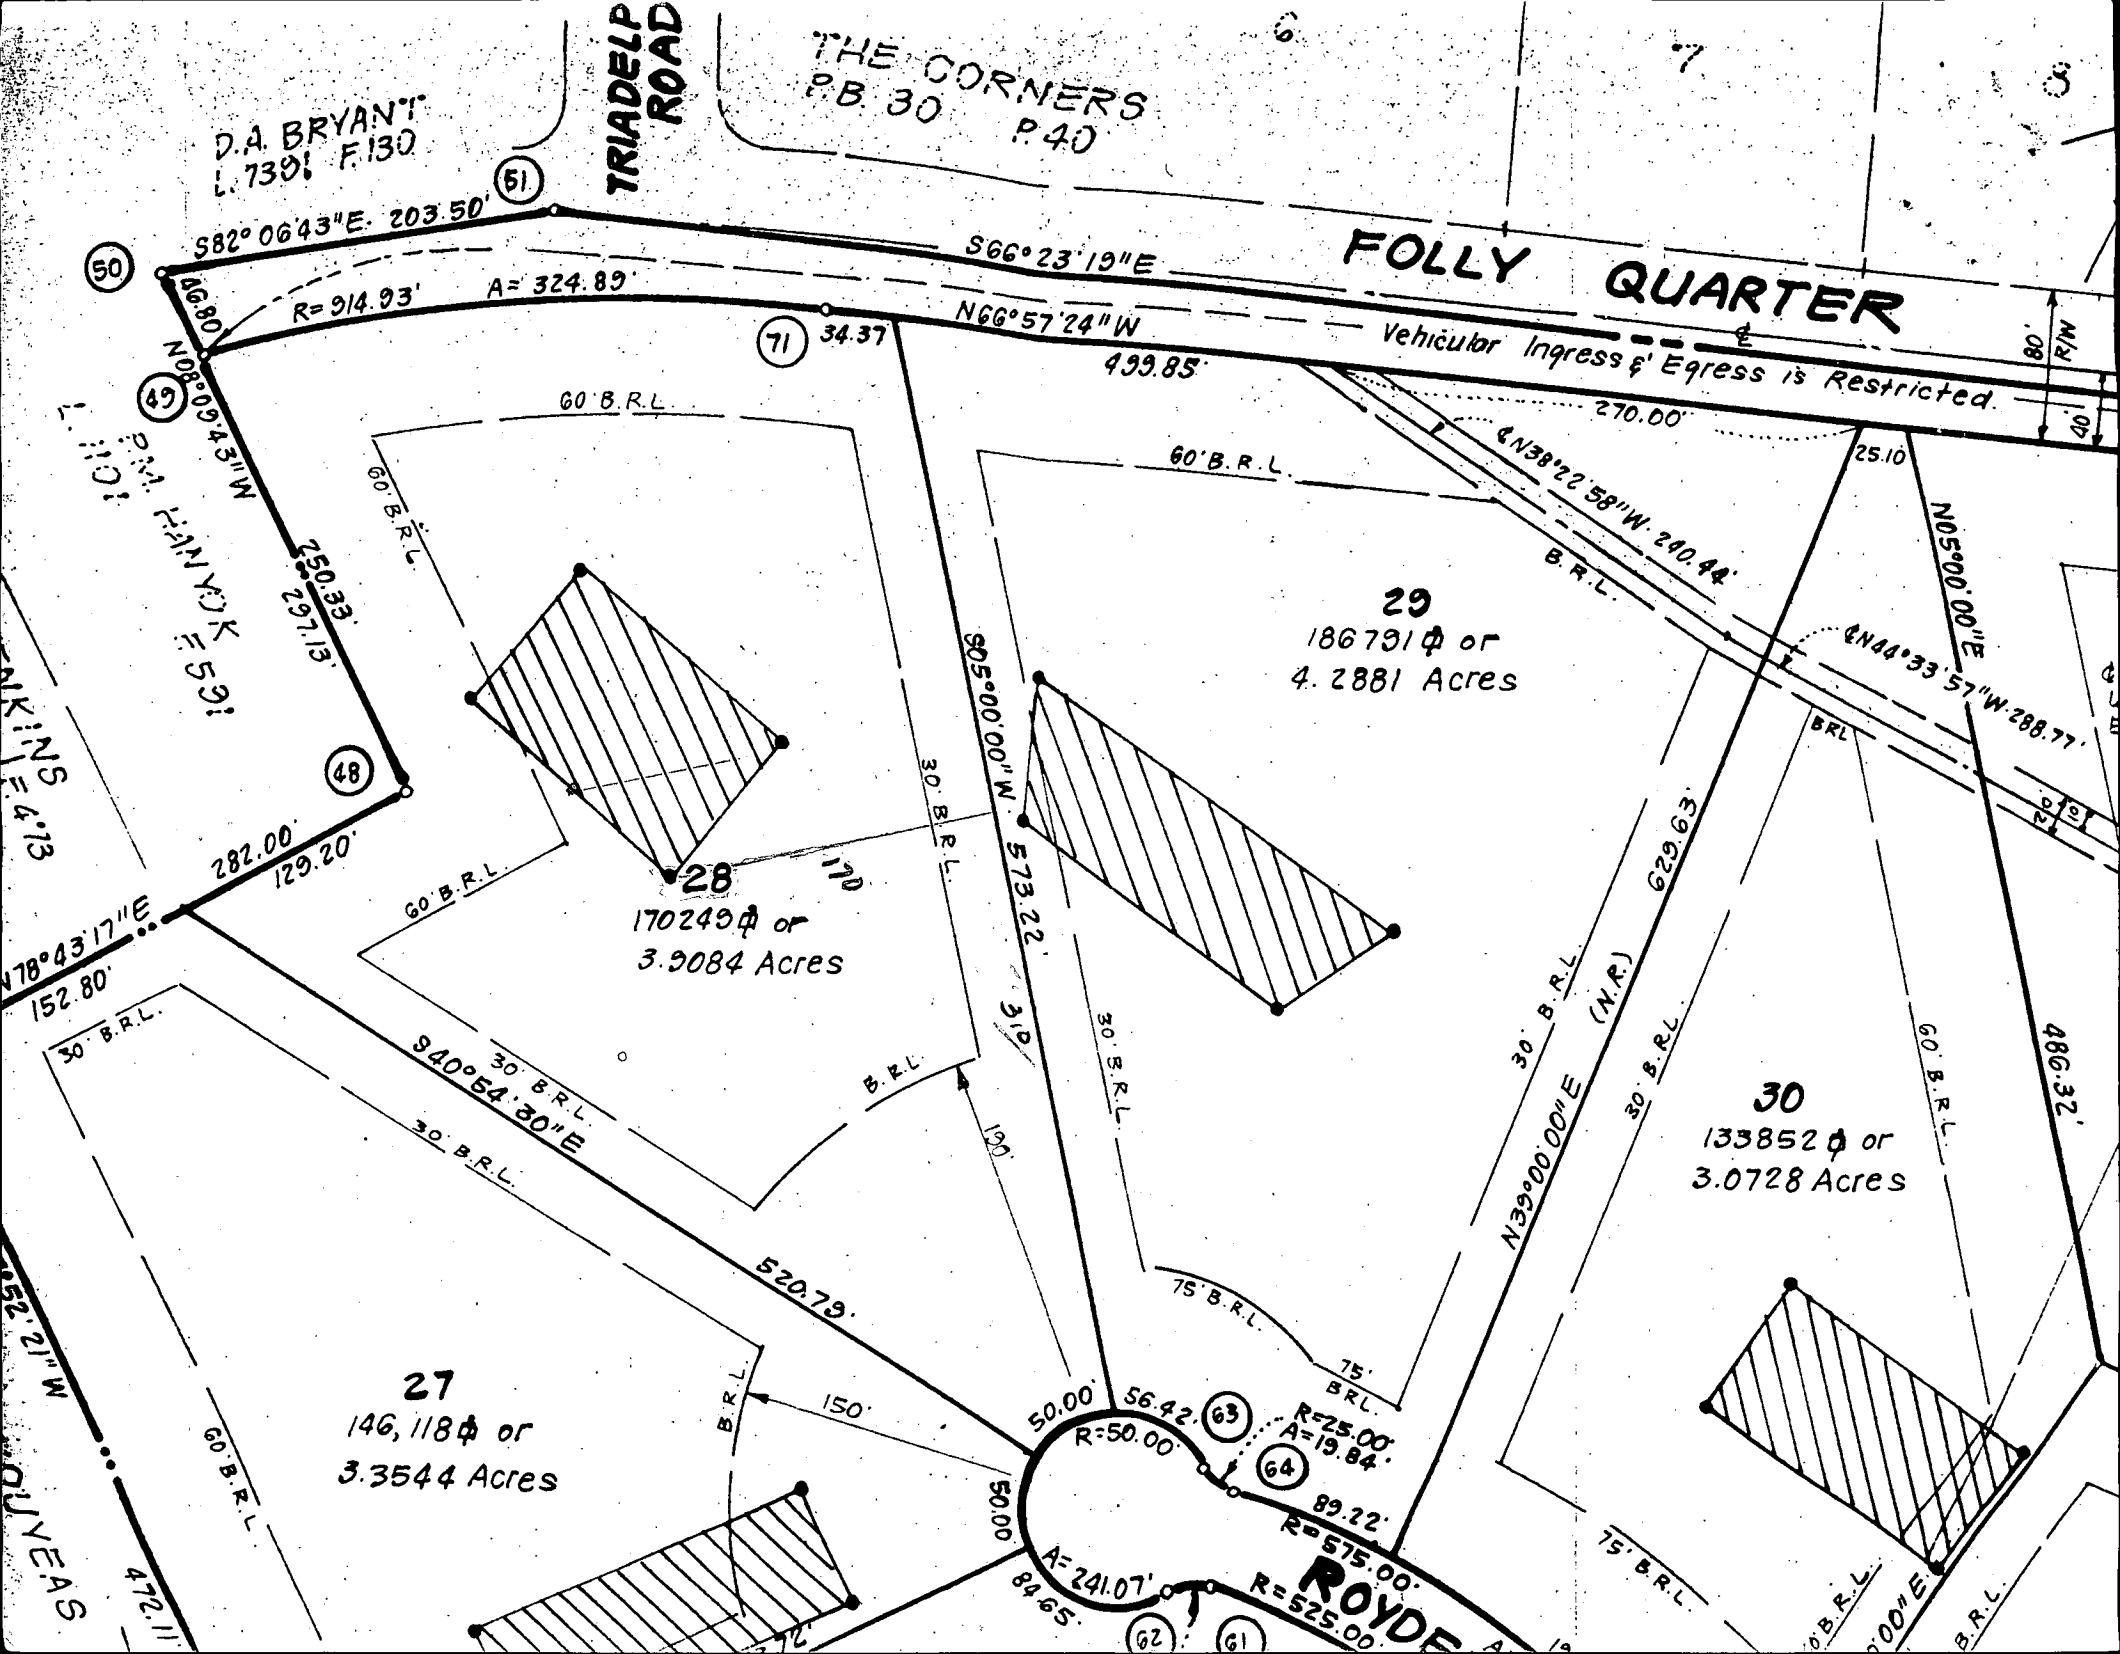

FOLLY QUARTER
ROAD

MATCH LINE ~ SEE SHEET 1

Roxden Ct
WOOD

ROAD

D.A. BRYANT
L. 7391 F. 130

P.M. HANYOK
L. 1101 F. 591

C.M. JENKINS
L. 454 F. 473

28
4.1 Acres

27
3.3 Acres

18

17

19

612

614

616

1274</