
DATE ACCEPTED: 2 (77/70/0/



RESIDENTIAL BUILDING PERMIT APPLICATION

HOWARD COUNTY DEPARTMENT OF INSPECTIONS, LICENSES, AND PERMITS 3430 COURT HOUSE DRIVE, ELLICOTT CITY, MD 21043 - PHONE: (410) 313-2455 OPTION #4 www.howardcountymd.gov

BUILDING SITE AD	DRESS REQUIREL	,	Alexander Sand				4.	_ ***	
Street Address: 5041	LINDERA COUR	f.				Uni			
City: ELLICOTT C	111			State: MD		Zip	Code: 2104	-2	
Subdivision/Village/Comple		IT CREE	K	-	SDP/V	VP/BA #:			
Lot: 122	Tax Map: 28	Pa	arcel: 45)	Grading Permit	#:			
DESCRIPTION OF W	ORK REQUIRED								
Existing Use: RESIDENT	TIAL , PERSONAL	Proposed U	se: RESIDE	MINAL, PE	RSONAL	Est	imated Cost: \$ /	2,000	
Trade Work to Be Complet	ed (Separate Permits Re	quired): 🗆 M	1echanical (H	/ACR)	Electrical	umbing [None		
BUILDING A	DECK IN MY 1	BACKYAR	DIFRE	E STAND	ING DECK	23/9	17', FRA	ME ALL	
PRESSURE TRE	THED LUMBER	2 (Prosis	, Torsis	AND SE	IMS , BO	MARS V	WILL BE C	eMPOSITE	
TRANSCEND PI	RODUCT FROM	TREX.	(0	4		7	- V 0 - V		
PROPERTY OWNER	INFORMATION	REQUIRED							
Owner(s) Name(s) (As it a	appears on tax records):	RAO A. K	HAN &	KANWAL	RAZZAQ	Pri	mary Residence:	Yes 🗆 No	
Owner's Street Address:	5041 LINDERA	COURT							
City: ELLICOTT CI	TY, MD			State:	10	Zip	Code: 2104	2	
Phone: 786 - 489			Email: A	LIHASHI	ARAO@GN	MAIL . CO	M		
APPLICANT NAME	REQUIRED - INDI	VIDUAL WH	O SIGNS T	HIS APPLIC	ATION				
Business Name: SEL	F (HOME OWN	ERI		Contact Nan	ne: RAO AL	1 HASH	IM KHAN		
Street Address: 5041		100							
City P	TTY			State:	MD	Zip	Code: 2104	2	
	9838		Email: A	HASHI	MRAO @ GI	MAIL CO	M.		
CONTRACTOR INFO		IRED							
Business Name:	N/A								
Licensee's Name:				License #:					
Street Address:								,	
City:	ty:			State:			Zip Code:		
Phone:			Email:			_			
ARCHITECT/ENGIN	EER INFORMATIO	N INDIVID	UAL WHO S	IGNED PLA	NS, IF APPLICA	4 <i>BLE</i>			
Business Name:	N/A			Name:					
Street Address:	1								
City:				State:			Zip Code:		
Phone:			Email:						
BUILDING CHARAC	TERISTICS REQU	JIRED							
Primary Structure: SF D	welling	se 🗆 SF Dupl	ex	Home 🗆 Mu	lti-Family Dwelling	g (MF*)	Condo: 🗆 Ye	es 🗀 No	
Utilities: Electric	Gas Water Supp	ly: D Public	Private	(Well)	Sewage Disposa	l:∍⊡ Public	Private (Sep	tic)	
Heating System: ☐ Electr	ic Matural Gas D. P.	ropane Ot	her:		Roadside Tree P	roject: 🗆 N	O 🗆 Yes: #		
Sprinkler System: NFPA	A 13 NFPA 13R)	NFPA 13D	□ None	Fire Ala	arm System:	Yes 🗆 No	☐ Voice Evac		
ADDITIONAL RESID	DENTIAL INFORMA	TION (PL	EASE' SELEC	CT/COMPLE	TE ALL THAT A	PPLY)			
Model Name & Options:							-9-7-		
# of Bedrooms (SF):	# of efficiency units (*	1F*):	# of 1 BR (MF*):	# of 2 BR (MF*)		# of 3 BR (M	F*):	
# Rooms:	# Full Baths	B:	,	# Half Baths	s: ·	#	Fireplaces:		
Garage/Carport Info: □	Attached Garage D	etached Garag	e 🔲 Integ	ral Garage	☐ Carport ☐	None	1		
Basement/Foundation Info		Post & Pier		ned Basement	☐ Finished Ba	sement: 🛘 F	ull or D Partial		
1st Fl Width:	1st Fl Depth:	2 nd Fl Width	1;	2 nd Fl Depth	: Bsi	nt Width:	Bsmt D	epth:	
Energy Method: Prescr		☐ UA Alternat	ive 🗆 ERI	Gross Area:		sq ft Oc	cupiable Area:	sq ft	
Allahim	TFIES AND AGREES AS FOLLOWS WARD COUNTY WHICH ARE APP HE/SHE GRANTS COUNTY OFFICE	: (1) THAT HE/SHE LICABLE THERETO;	(4) THAT HE/SHE	WILL PERFORM.N	O WORK ON THE ABOV	VE REFERENCED I	PROPERTY NOT SPECIFIC	CALLY DESCRIBED IN	
APPLICANT'S ORIGINAL SIGNA									
FOR OFFICE USE OF	NLY			CHECKS PAY	ABLE TO: DIRECTOR	OF FINANCE O	F HOWARD COUNTY		
AGENCIES REQUIRED/APP	PROVALS:								
16 PR	DPZ	_ 80	DED		Health -	3/10/20 mk 054		□ CID	
SUBMITTAL FEES:	45 2 P	PAYMENT:		1.1	<i>a</i>	AC	CEPTED BY:	(200	

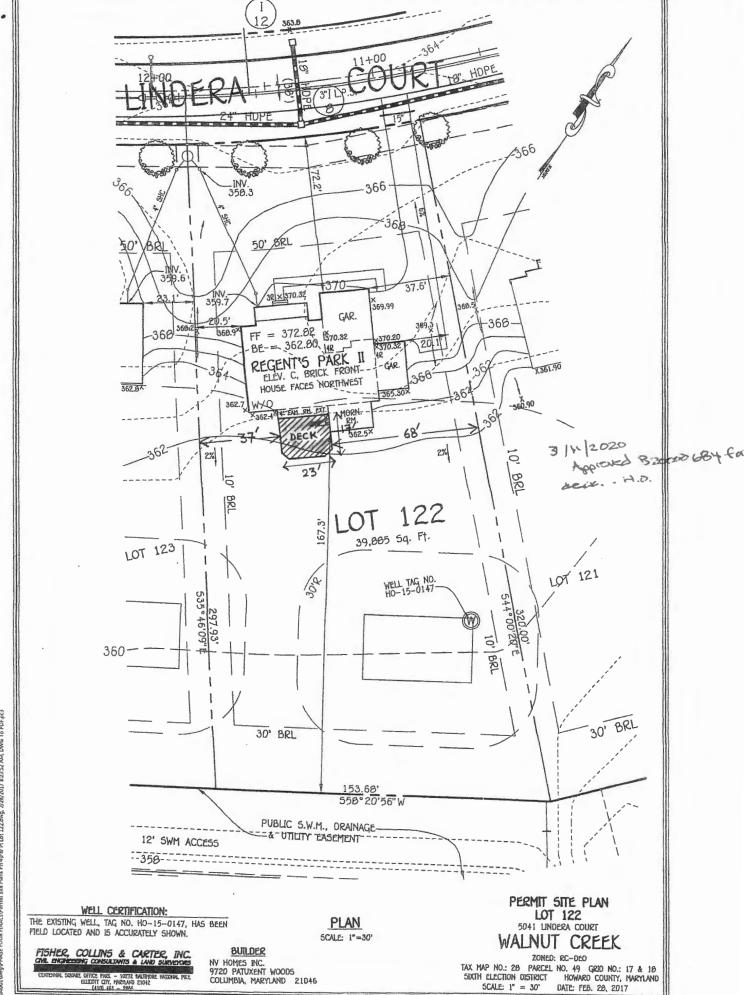

Plans Ph 4/Per Pl Lot 122.dvg, 2/28/2017 8:23:52 AM, DWG To PDF.pc3