


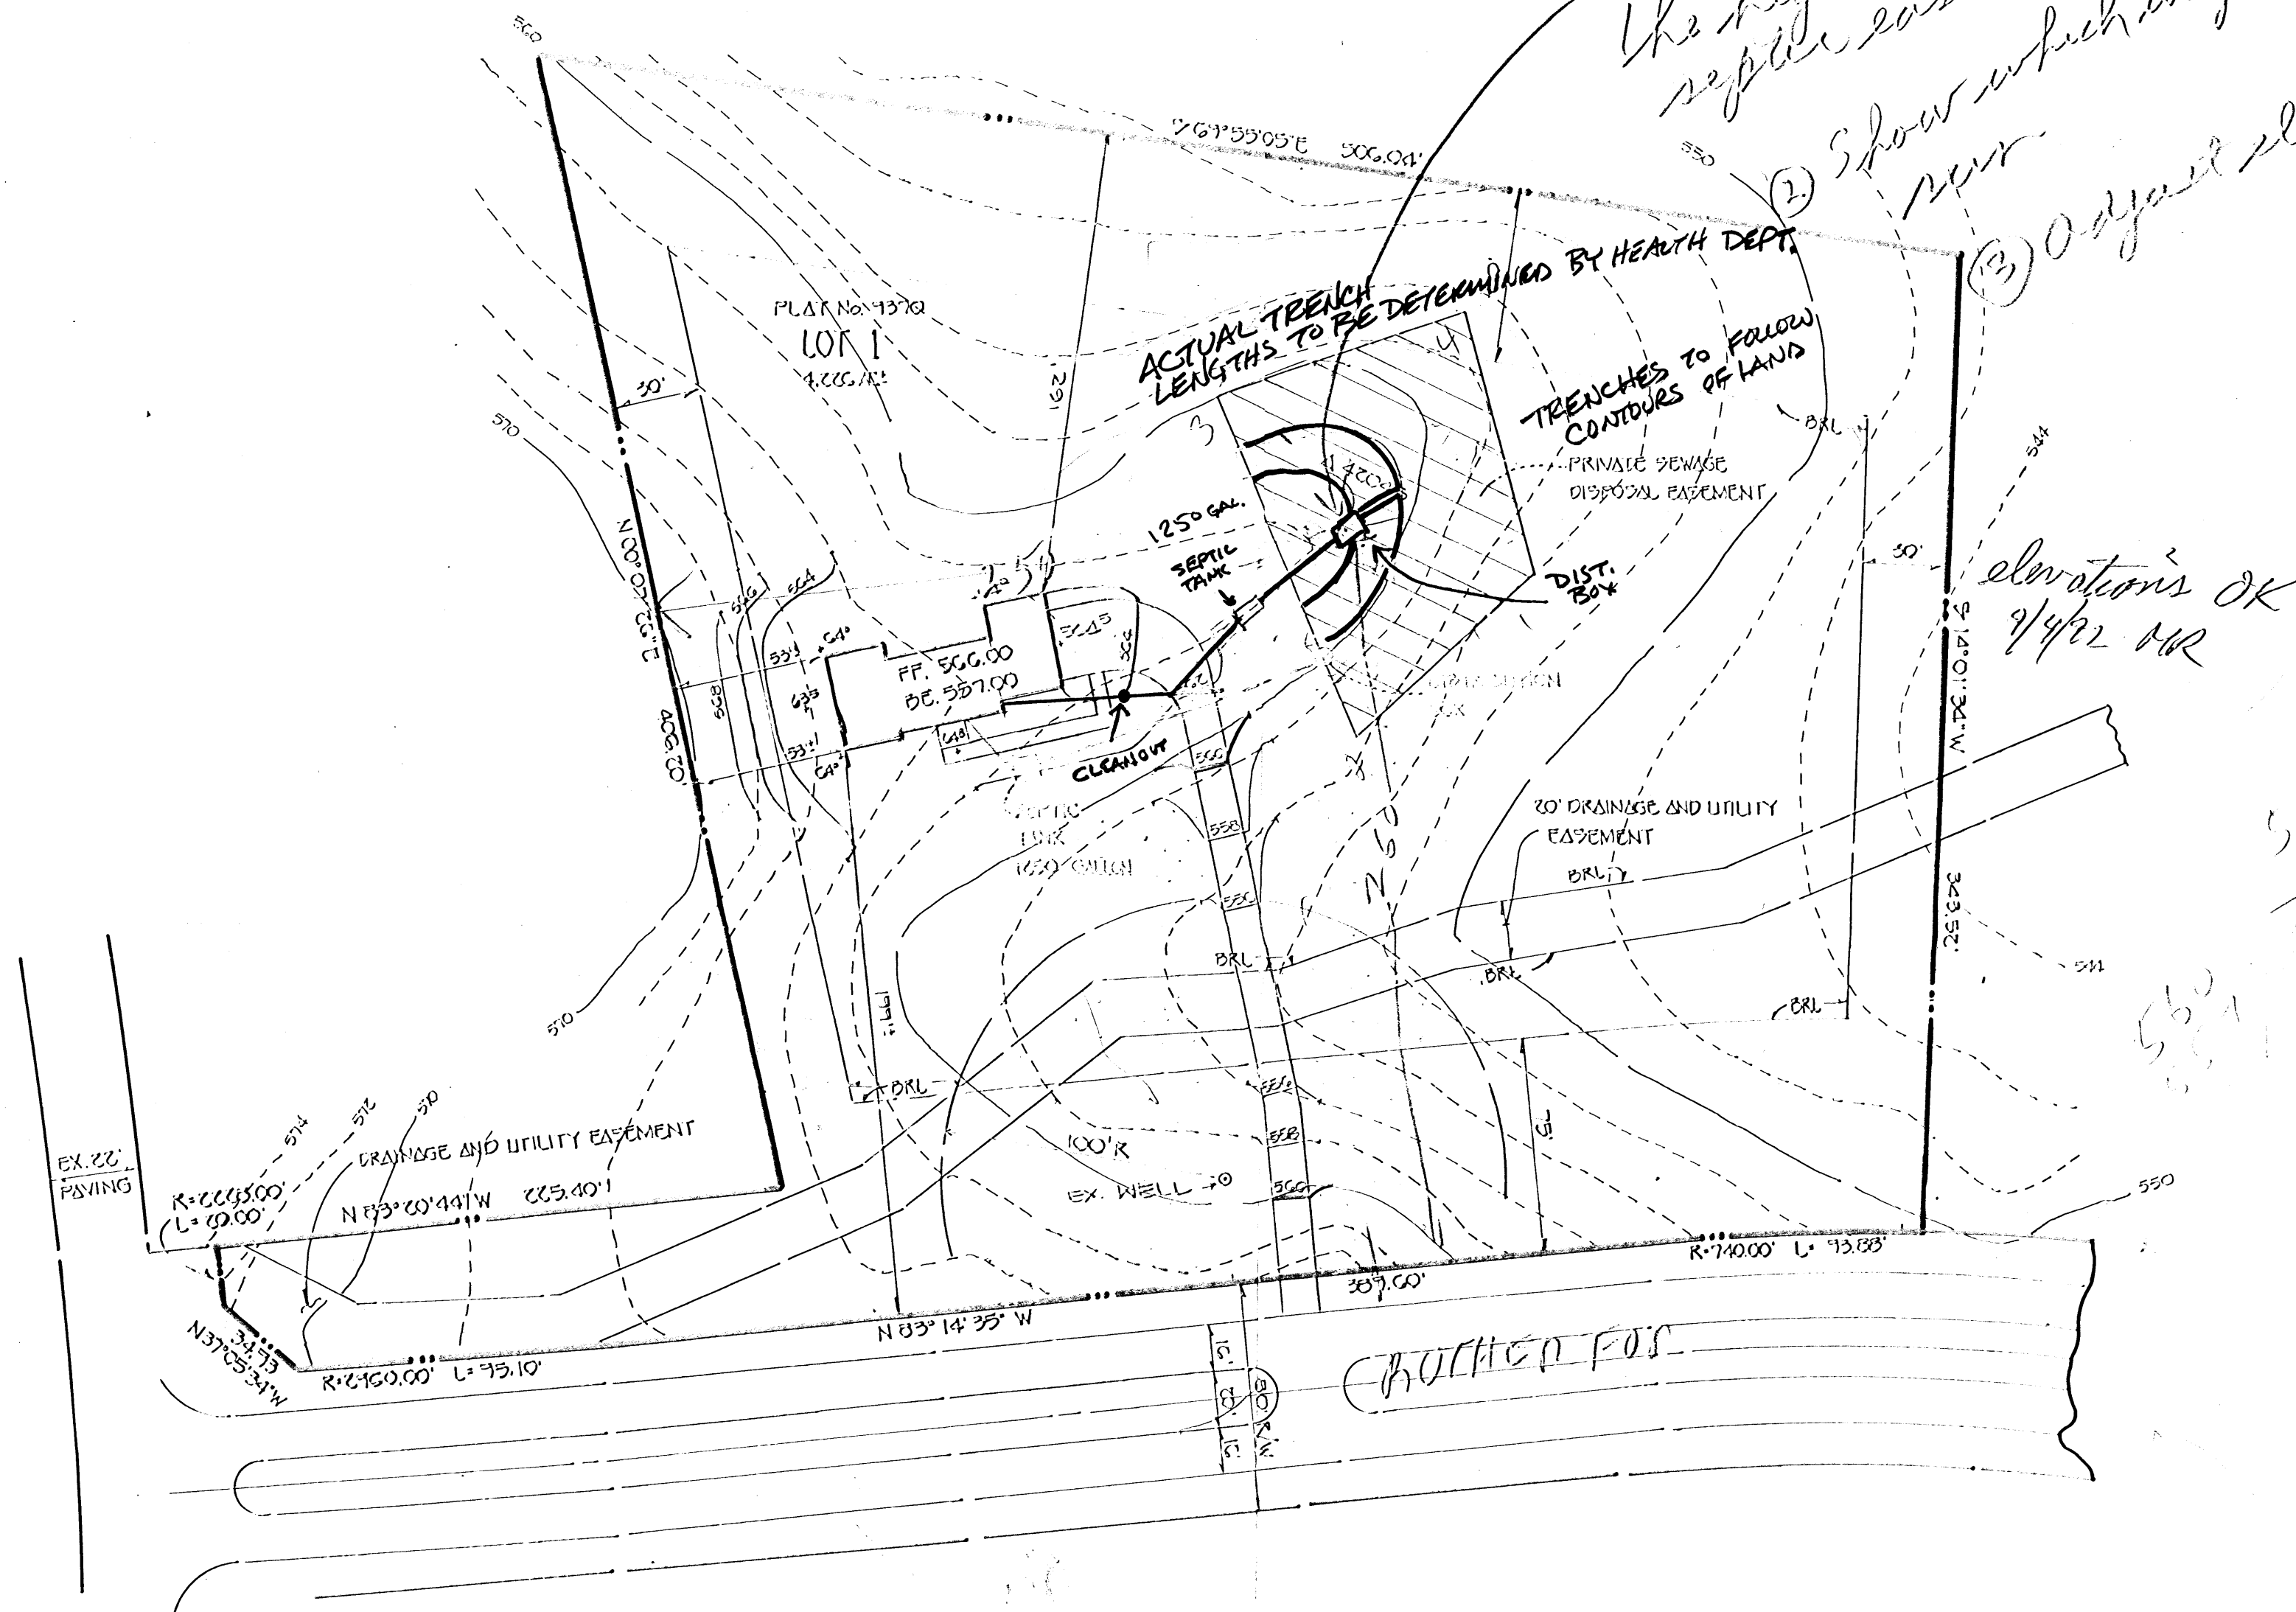

GENERAL NOTES

1. SEPTIC EASEMENT SUBJECT TO HOWARD COUNTY HEALTH DEPARTMENT NUMBERS A-100-13
2. PROPOSED 3 BEDROOM DWELLING
3. PROPOSED 1250 GALLON SEPTIC TANK
4. AT FIRST FLOOR - 566.00
 - a. BASEMENT - 557.00
 - b. INVERT OF SEPTIC SYSTEM AT HOUSE - 560.4
 - c. INVERT IN AT SEPTIC TANK - 551.4
 - d. INVERT OUT AT SEPTIC TANK - 559.1
 - e. INVERT AT DISTRIBUTION BOX - 558.0
5. LENGTH OF TRENCH TO BE DETERMINED TIME OF SEPTIC PERMIT ISSUANCE.
6. BRL - DENOTES BUILDING RESTRICTION LINE

WELL TAG # 92-1036
0136


PLOT PLAN
TO ACCOMPANY APPLICATION FOR BUILDING PERMIT
FOR
LOT 1
RUTHERFORD

TAX MAP 23 ZONE R PART OF PARCEL 75
5TH ELECTION DISTRICT HOWARD COUNTY, MARYLAND
SCALE: 1" = 50' DATE: JULY 21, 1992



FISHER, COLLINS & CARTER, INC.
CIVIL ENGINEERING CONSULTANTS & LAND SURVEYORS
5111 BOUTWORTH NATIONAL PIKE, SUITE 100
ELLICOTT CITY, MARYLAND 21042
TELEPHONE: (410) 461-0935
FAX: (410) 750-3784

APPROVED
WALK-THRU BUILDING PERMIT
BP# 600155706 A# 42045
APP. SAN KJB DATE: 8/15/05
DESC. OF WORK: 24x24 Deck same

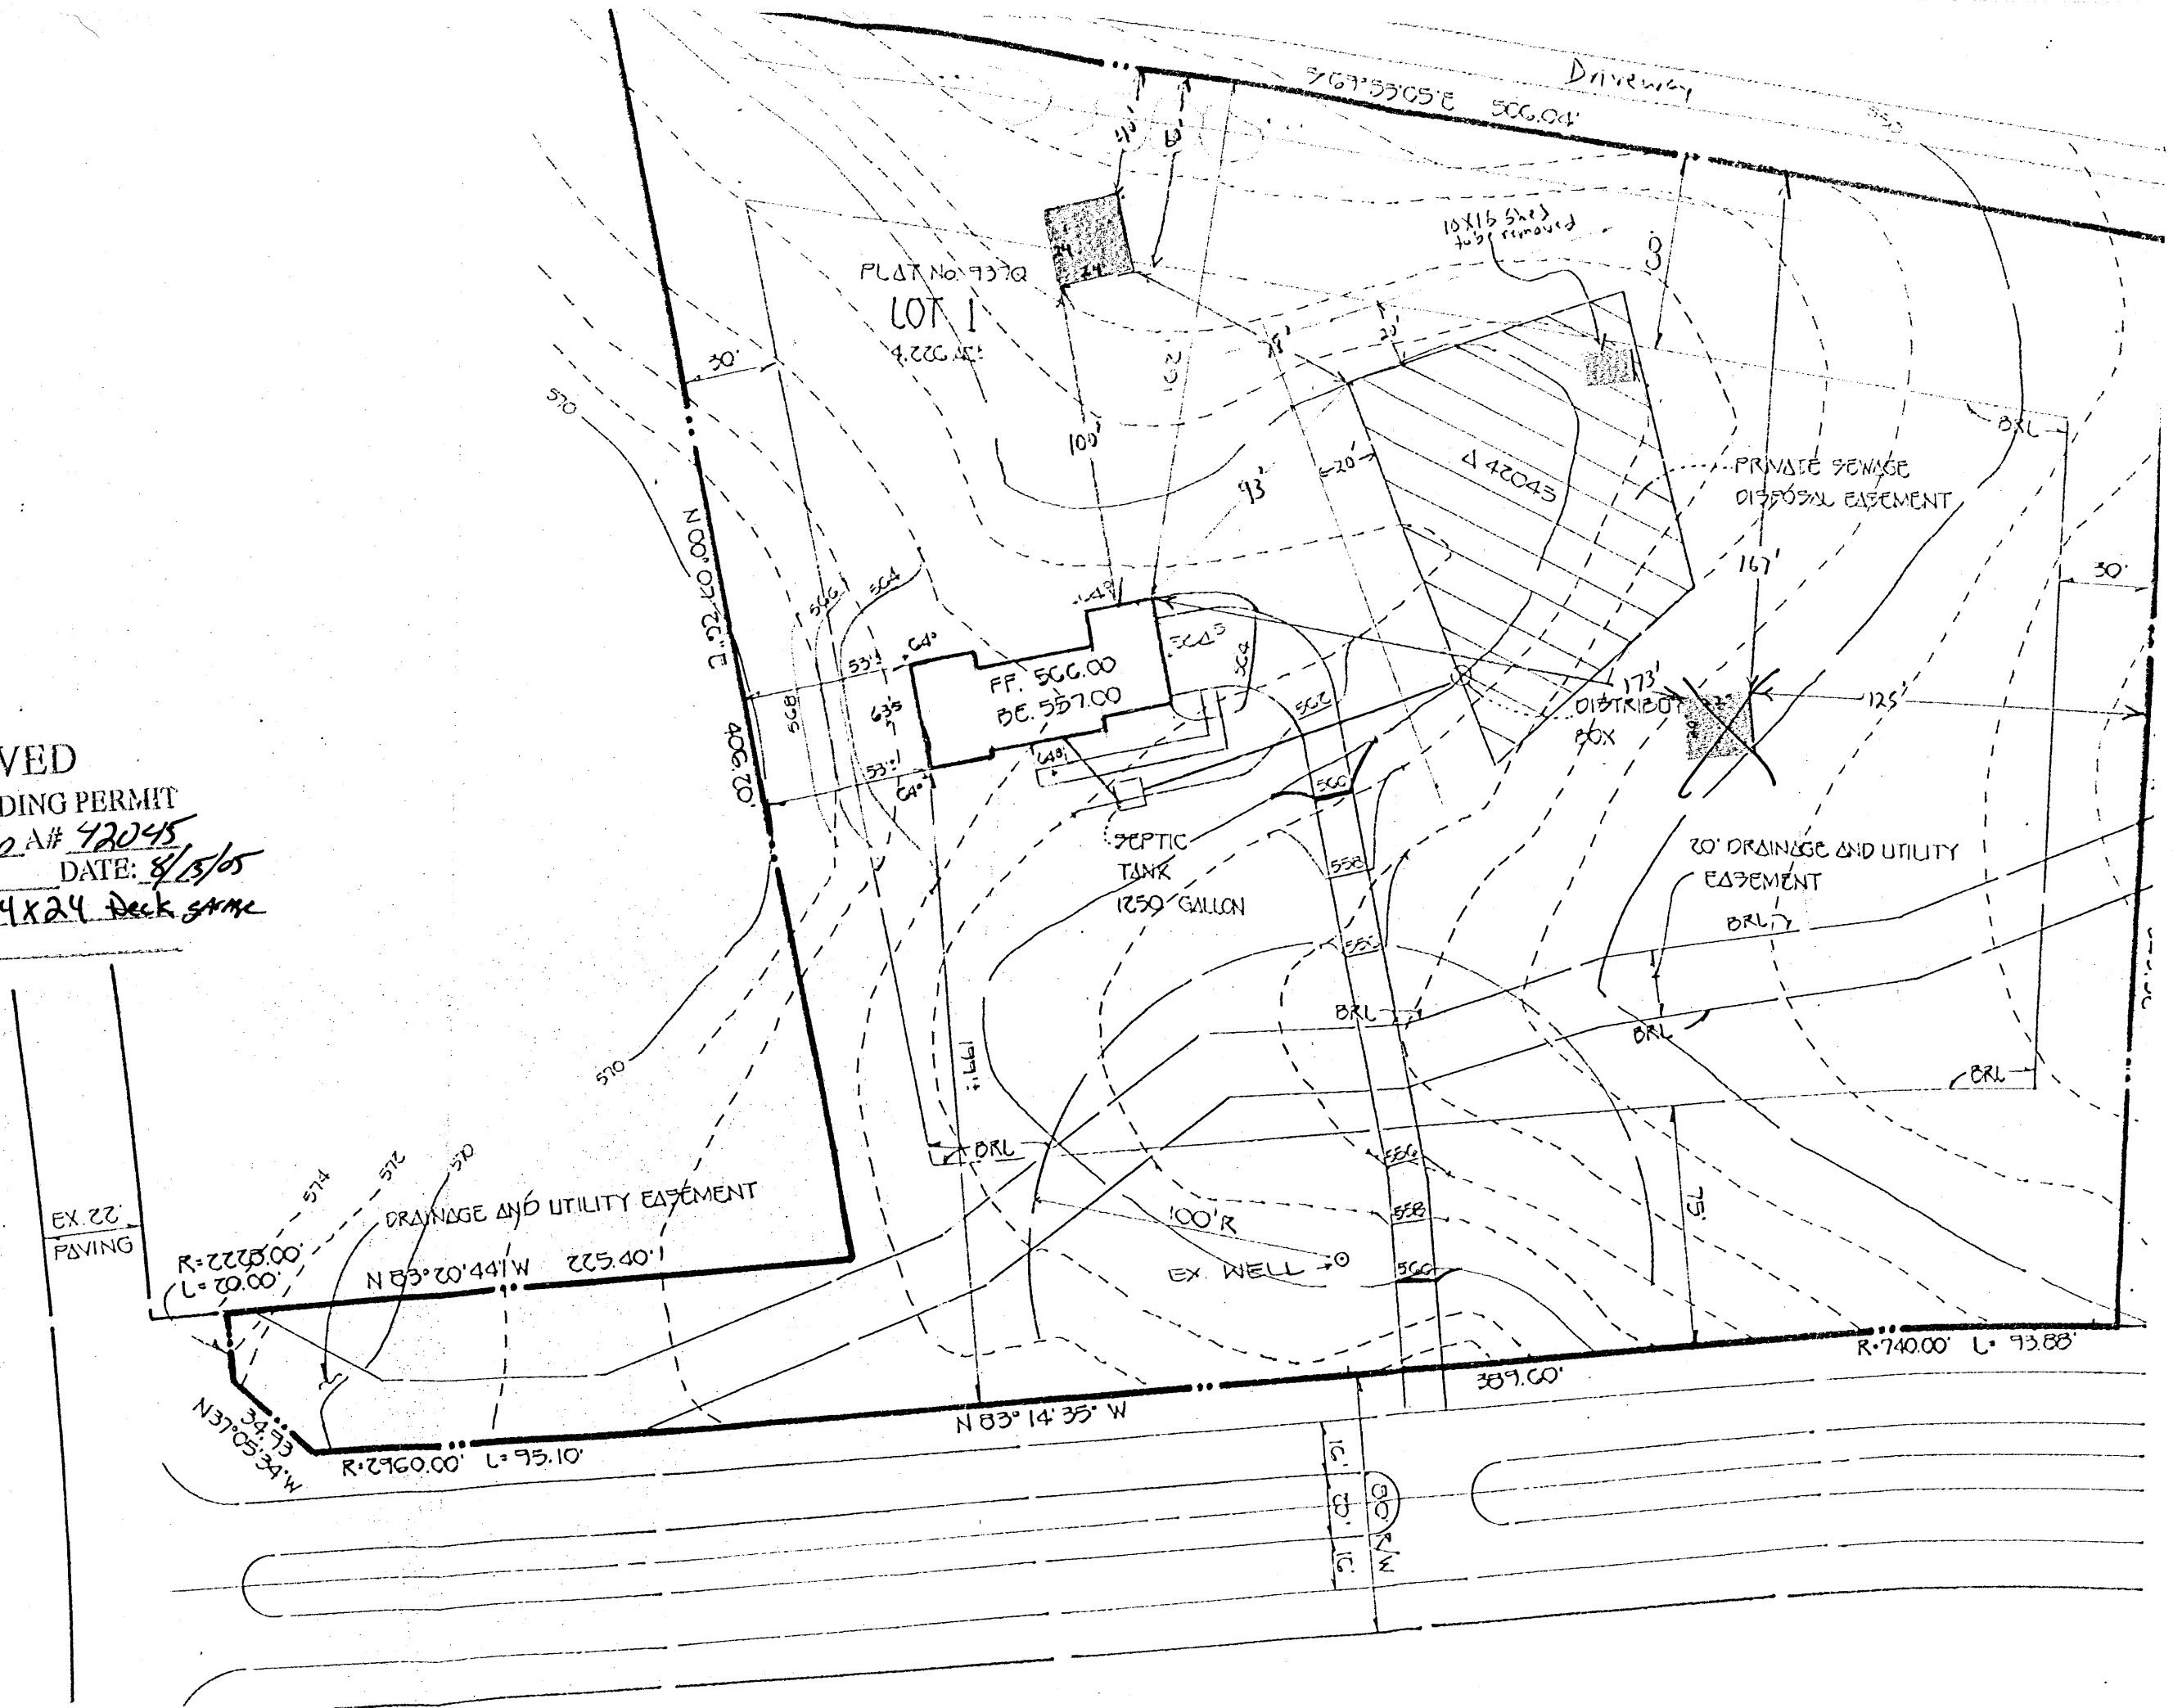

EX. 22
PAVING

