

APPLICATION

HOWARD COUNTY HEALTH DEPARTMENT
BUREAU OF ENVIRONMENTAL HEALTH
P.O. BOX 476 ELLICOTT CITY, MARYLAND 21043
TELEPHONE: 461-9933

PERCOLATION TESTING

3/31/88

(check is in
2509

A 42045

P _____

DISTRICT 5TH

DATE 3/8/88

TO: THE COUNTY HEALTH OFFICER
ELLICOTT CITY, MARYLAND

I, HEREBY, APPLY FOR THE NECESSARY TEST IN ORDER TO CONSTRUCT (OR RECONSTRUCT) A SEWAGE DISPOSAL SYSTEM.

PROPERTY OWNER MARY C. HILL ET AL Westin Builders

ADDRESS 6642 SENECA DRIVE COLUMBIA PHONE 301-776-0980
MARYLAND 21044 301-881-4444

PROSPECTIVE BUYER _____

ADDRESS _____ PHONE _____

PROPERTY LOCATION:

SUBDIVISION 4501 RUTHERFORD LOT NO. 1

ROAD AND DESCRIPTION WEST SIDE OF MD RTE 32, EAST SIDE OF TEN
GAWS ROAD (4501 Rutherford Way)

TAX MAP 28 PARCEL # 75

SIZE OF LOT 3.2 ACRES TYPE BLDG. SFD
(SINGLE FAMILY DWELLING OR COMMERCIAL)

THE SYSTEM INSTALLED UNDER THIS APPLICATION IS ACCEPTABLE ONLY UNTIL PUBLIC FACILITIES BECOME AVAILABLE. I FULLY UNDERSTAND THE
FEE CONNECTED WITH THE FILING OF THIS PERC TEST APPLICATION IS NON-REFUNDABLE UNDER ANY CIRCUMSTANCES. I ALSO AGREE TO COMPLY
WITH ALL M.O.S.H.A. REQUIREMENTS IN TESTING THIS LOT.

Mary C. Hill
(SIGNATURE OF APPLICANT)

APPROVED BY _____ FOR _____ DATE _____

REJECTED BY _____ FOR _____ DATE _____

HOLD PENDING FURTHER TESTS _____ DATE _____

REASONS FOR REJECTION OR HOLDING 10/17/88 Percolation Test (SFD)

REG. PERMIT SIGNED

AND RETURNED

9/9/92
Serial # 45034-SFD
3 Bedrooms

THIS IS NOT A PERMIT

10/19/88

SOIL PROFILE

0
BROWN
RED
CLAY

3
BROWN
GRAY
SAND
M CA
LOAM

0
CLAY
TOPSOIL

2
GRAY
BROWN
SAND
LOAM


12
WATER

0
CLAY
TOPSOIL

2
BROWN
GRAY
SAND
LOAM

0
BROWN
RED CLAY

3
BROWN
GRAY
SAND
LOAM

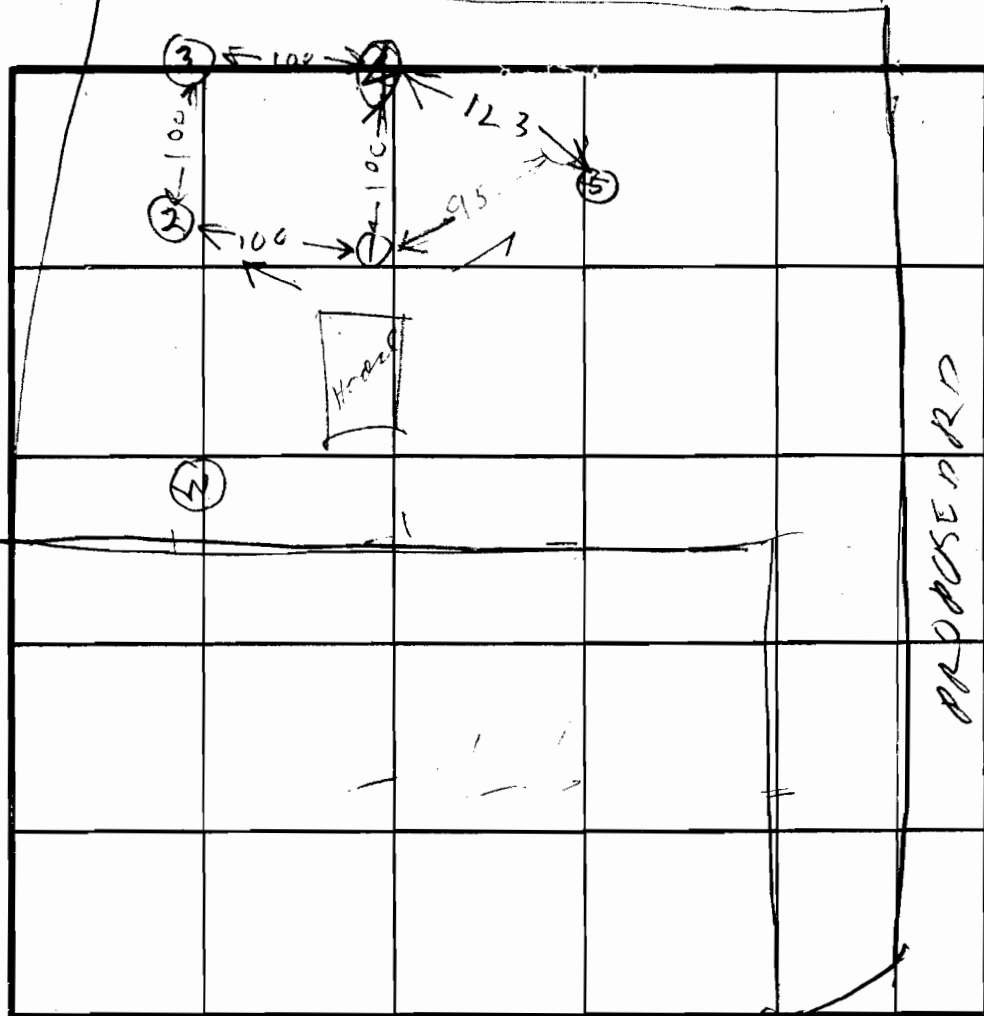

0
BROWN
RED
CLAY

4
GRAY
SAND
LOAM
FEN
ROCK

INDICATE NORTH - NAME ADJOINING ROADWAY AS BASE LINE.

TEN OAKS RD

CONTAIN REQUIRES

DETAIL C.W.

DATE	TEST NO.	DEPTH	PRE-WET		TEST - 1" DROP		TIME
			START	STOP	START	STOP	
10/19/88	1 S	4.5	1121	1123	1123	1127	4
	1 D	8.5	1121	1123	1123	1127	7
	1 V	12.5	OK				
	2 V	12	WATER 12 FT				
	3 S	9	1130	1131	1131	1134	3
	3 V	12.5	OK				
	4 V	12	OK				
	5 S	5	1138	1139	1139	1140	1
	5 V	13	OK				
	(TESTS LOWER ON PROJECTIONS FOR DIFFERENT LOT CONFIGURATION)						
	NOT SUCCESSFUL DUE TO WATER TABLE						
	SEE 442046 & 442047 IN SUBD. UNAPPROVED FIVE						

Airline
Time
3 min

max
Depth
3 ft

REMARKS

Holer 10/19/88 dug 12' at Hole (5) adjacent

TYPE OF SOIL

TESTED BY

R. Hodge

ALSO PRESENT

M. H. H. - Bagley