

# APPLICATION

PERCOLATION TESTING

A 42057

P \_\_\_\_\_

HOWARD COUNTY HEALTH DEPARTMENT  
BUREAU OF ENVIRONMENTAL HEALTH  
P.O. BOX 476 ELLICOTT CITY, MARYLAND 21043  
TELEPHONE: 461-9933

DISTRICT 5TH

DATE 3/8/88

TO: THE COUNTY HEALTH OFFICER  
ELLICOTT CITY, MARYLAND

I, HEREBY, APPLY FOR THE NECESSARY TEST IN ORDER TO CONSTRUCT (OR RECONSTRUCT) A SEWAGE DISPOSAL SYSTEM.

PROPERTY OWNER MARY C. HILL ET AL Pulte Home Corporation  
644-5603

ADDRESS 6642 SEVECA DRIVE COLUMBIA PHONE 301-381-4444  
MARYLAND 21044

PROSPECTIVE BUYER \_\_\_\_\_

ADDRESS \_\_\_\_\_ PHONE \_\_\_\_\_

PROPERTY LOCATION:

SUBDIVISION RUTHERFORD LOT NO. 12  
14

ROAD AND DESCRIPTION WEST SIDE OF MD RTE 32, EAST SIDE OF TEN  
GABLE ROAD (4578 Rutherford Way)

TAX MAP 28 PARCEL # 75

SIZE OF LOT 3.1 ACRES TYPE BLDG SFD  
(SINGLE FAMILY DWELLING OR COMMERCIAL)

BLDG. PERMIT SIGNED  
AND RETURNED 4/30/88  
Severca 48065 - 4 Bedrooms

THE SYSTEM INSTALLED UNDER THIS APPLICATION IS ACCEPTABLE ONLY UNTIL PUBLIC FACILITIES BECOME AVAILABLE. I FULLY UNDERSTAND THE

FEE CONNECTED WITH THE FILING OF THIS PERC TEST APPLICATION IS NON-REFUNDABLE UNDER ANY CIRCUMSTANCES. I ALSO AGREE TO COMPLY

WITH ALL M.O.S.H.A. REQUIREMENTS IN TESTING THIS LOT. Mary C. Hill  
(SIGNATURE OF APPLICANT)

APPROVED BY \_\_\_\_\_ FOR \_\_\_\_\_ DATE \_\_\_\_\_

REJECTED BY \_\_\_\_\_ FOR \_\_\_\_\_ DATE \_\_\_\_\_

HOLD PENDING FURTHER TESTS \_\_\_\_\_ DATE \_\_\_\_\_


REASONS FOR REJECTION OR HOLDING 10/19/88 HOLD FOR PLAT. THERE IS  
A WET HOLE BUT IT CAN BE EXCLUDED FROM PERC  
AREA WITHOUT CHANGING LOT LINES

## THIS IS NOT A PERMIT

47057  
 New 11

SOIL PROFILE

0  
 BROWN  
 CLAY  
 4  
 BROWN  
 SAND  
 M/L  
 LOAM  
 12.5

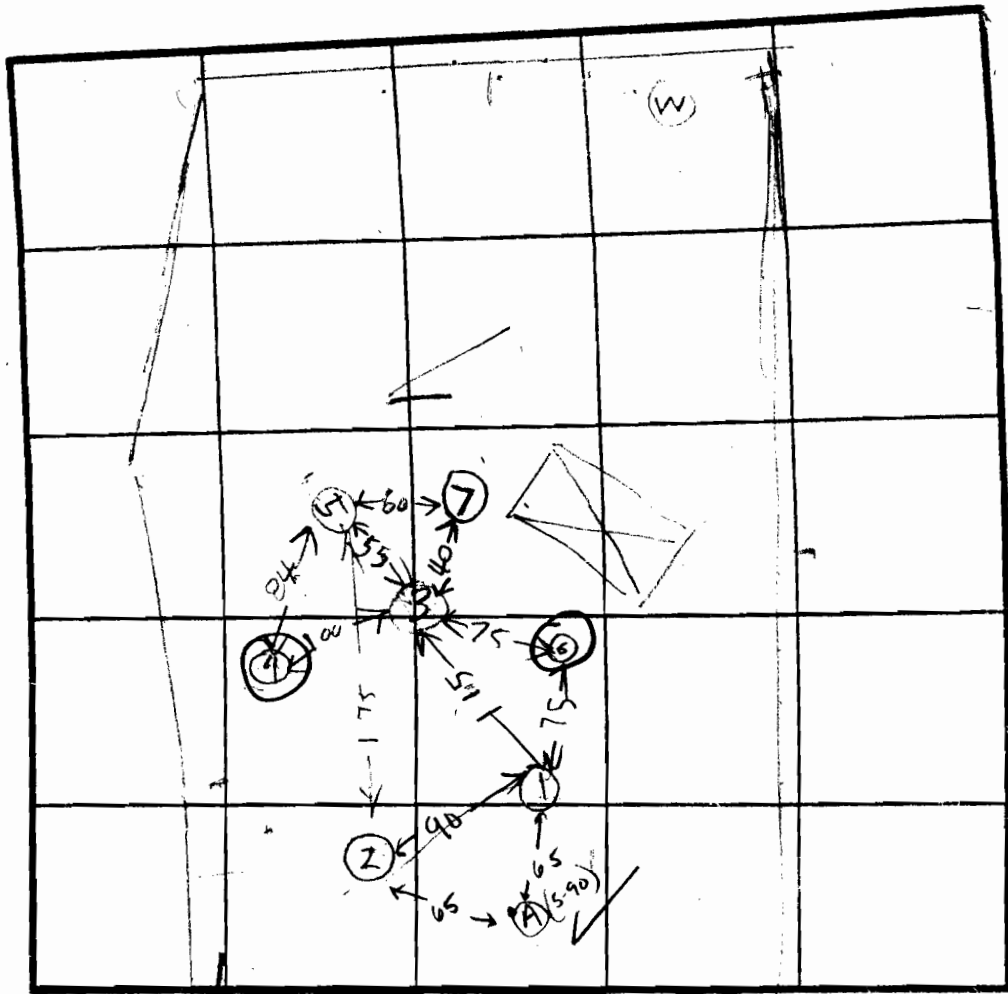

INDICATE NORTH - NAME ADJOINING ROADWAY AS BASE LINE

5  
 TOPSOIL  
 BROWN  
 CLAY  
 5  
 BROWN  
 SAND  
 LOAM  
 13  
 6  
 CLAY  
 8  
 BROWN  
 SAND  
 LOAM  
 13  
 7  
 CLAY  
 5  
 SAND

0  
 RED  
 BROWN  
 SAND  
 LOAM

13  
 3  
 TOPSOIL  
 BROWN  
 SAND  
 LOAM

13  
 0  
 1  
 TOPSOIL  
 RED CLAY  
 5  
 DARK  
 GRAY  
 SAND  
 LOAM  
 11  
 WATER  
 12

DATE	TEST NO.	DEPTH	PRE-WET		TEST - 1" DROP		TIME
			START	STOP	START	STOP	
10/17/88	1S	4	317	325	325	335	10
10/17/88	1V	7.5	317	320	320	322	2
10/17/88	1V	12.5	OK				
	2S	9	327	327	329	332	3
	2V	13	OK				
	3V	13	OK				
	4V	12	WATER		11 F 7		
	5S	6	335	356	356	420	24
	5V	13	OK				
3/23/89	6S	3	1044	1051	1051		
3/23/89	6V	13	240				
3/23/89	5V	13	DRY				
3/23/89	6ES	6 1/2	1108		1113		
3/23/89	TV	13	OK				

av  
 time  
 10 min  
 max  
 depth  
 5 FT

17.90  
 153.00

REMARKS 3/23/89. NO DECESSION LOT LINE CHANGED DO NOT HAVE PLAT R.

TYPE OF SOIL \_\_\_\_\_  
 TESTED BY B. Hodge ALSO PRESENT Backholly

# APPLICATION

PERCOLATION TESTING

A 42057

P \_\_\_\_\_

HOWARD COUNTY HEALTH DEPARTMENT  
BUREAU OF ENVIRONMENTAL HEALTH  
P.O. BOX 476 ELLICOTT CITY, MARYLAND 21043  
TELEPHONE: 461-9933

DISTRICT \_\_\_\_\_

DATE \_\_\_\_\_

TO: THE COUNTY HEALTH OFFICER  
ELLICOTT CITY, MARYLAND

I, HEREBY, APPLY FOR THE NECESSARY TEST IN ORDER TO CONSTRUCT (OR RECONSTRUCT) A SEWAGE DISPOSAL SYSTEM.

PROPERTY OWNER \_\_\_\_\_

ADDRESS \_\_\_\_\_ PHONE \_\_\_\_\_

PROSPECTIVE BUYER \_\_\_\_\_

ADDRESS \_\_\_\_\_ PHONE \_\_\_\_\_

PROPERTY LOCATION:

SUBDIVISION Rutherford LOT NO. 12 (Prelim)

ROAD AND DESCRIPTION Ten Oaks Road

TAX MAP \_\_\_\_\_ PARCEL # \_\_\_\_\_

SIZE OF LOT \_\_\_\_\_ TYPE BLDG SFD

(SINGLE FAMILY DWELLING OR COMMERCIAL)

THE SYSTEM INSTALLED UNDER THIS APPLICATION IS ACCEPTABLE ONLY UNTIL PUBLIC FACILITIES BECOME AVAILABLE. I FULLY UNDERSTAND THE FEE CONNECTED WITH THE FILING OF THIS PERC TEST APPLICATION IS NON-REFUNDABLE UNDER ANY CIRCUMSTANCES. I ALSO AGREE TO COMPLY WITH ALL M.O.S.H.A. REQUIREMENTS IN TESTING THIS LOT.

(SIGNATURE OF APPLICANT) \_\_\_\_\_

APPROVED BY \_\_\_\_\_ FOR \_\_\_\_\_ DATE \_\_\_\_\_

REJECTED BY \_\_\_\_\_ FOR \_\_\_\_\_ DATE \_\_\_\_\_

HOLD PENDING FURTHER TESTS \_\_\_\_\_ DATE \_\_\_\_\_

REASONS FOR REJECTION OR HOLDING 5-24-90 Recommend approval of lot pending

perc hole location and plat approval TEN.


HD-216

## THIS IS NOT A PERMIT

A 42057

(A)  
SOIL PROFILE

0-4.0 Rd-br sil  
4-14.0 white decomposed weathered rock and sil, some broken fragments  $\pm 15\%$   
No structure  
dry  
14.0 Bottom

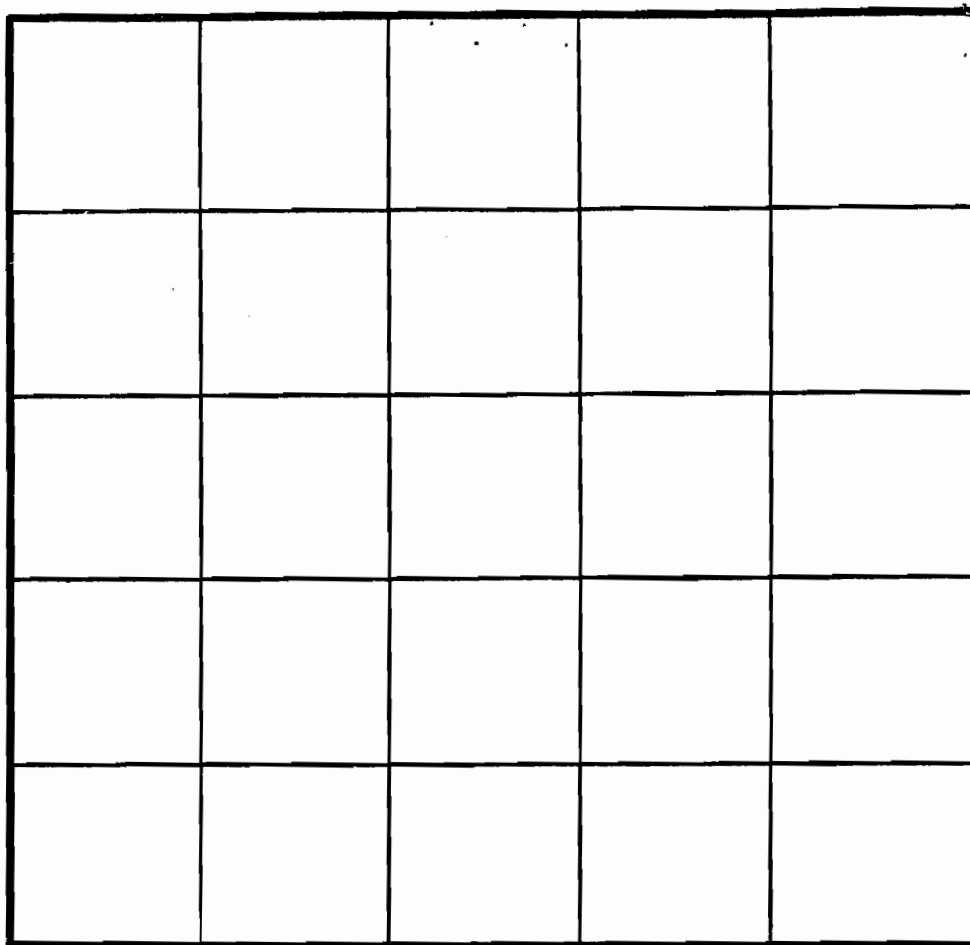

INDICATE NORTH - NAME ADJOINING ROADWAY AS BASE LINE.

DATE	TEST NO.	DEPTH	PRE-WET		TEST - 1" DROP		TIME
			START	STOP	START	STOP	
5-24-90	A	14.0 V	Bottom (see profile)				OK

REMARKS No water observed.TYPE OF SOIL Decomposed pegmatite and quartzite below 4.0 ft. No structure.TESTED BY Jane E. NadeauALSO PRESENT Rick, Ken  
Paul Moore