



APPLICATION

FOR PERCOLATION TESTING AND SITE EVALUATION

TEST DATE(S) _____ TEST TIME _____

AP 520078-0

AGENCY REVIEW: _____

DATE 3/2/04

DO NOT WRITE ABOVE THIS LINE

I HEREBY APPLY FOR THE NECESSARY TESTING/EVALUATION PRIOR TO ISSUANCE OF SEWAGE DISPOSAL SYSTEM PERMIT(S) TO:

CHECK AS NEEDED:

- ☒ CONSTRUCT NEW SEPTIC SYSTEM(S)
☐ REPAIR/ADD TO AN EXISTING SEPTIC SYSTEM
☐ REPLACE AN EXISTING SEPTIC SYSTEM

CHECK AS NEEDED:

- ☒ NEW STRUCTURE(S)
☐ ADDITION TO AN EXISTING STRUCTURE
☐ REPLACE AN EXISTING STRUCTURE

CHECK ONE:

- ☒ CREATE NEW LOT(S)
☐ BUILD ON AN EXISTING LOT IN A SUBDIVISION
☐ BUILD ON AN EXISTING PARCEL OF RECORD

IS THE PROPERTY WITHIN 2500' OF ANY RESERVOIR?

- ☐ YES
☒ NO

THE TYPE OF STRUCTURE IS:

- ☒ RESIDENTIAL WITH unknown PROPOSED BEDROOMS IN THE COMPLETED STRUCTURE (NOTE UNKNOWN IF APPROPRIATE)
☐ COMMERCIAL (PROVIDE DETAIL OF NUMBERS AND TYPES OF EMPLOYEES/ CUSTOMERS ON ACCOMPANYING PLAN)
☐ INSTITUTIONAL/GOVERNMENT (PROVIDE DETAIL OF NUMBERS AND TYPES OF EMPLOYEES/USERS ON ACCOMPANYING PLAN)

PROPERTY OWNER(S) LDG, Inc.

DAYTIME PHONE (301) 585-7000 CELL _____

FAX (301) 585-4604

MAILING ADDRESS Lee Plaza, Suite 200 Silver Spring MD 20910-3437
8601 Georgia Avenue STREET CITY/TOWN STATE ZIP

APPLICANT VanMar Associates, Inc.

DAYTIME PHONE (301) 829-2890 CELL _____

FAX (301) 831-5603

MAILING ADDRESS 310 South Main St. NH. Airy MD 21771
STREET CITY/TOWN STATE ZIP

APPLICANT'S ROLE: DEVELOPER BUILDER BUYER RELATIVE/FRIEND REALTOR CONSULTANT

PROPERTY LOCATION
SUBDIVISION/PROPERTY NAME Patapsco Overlook LOT NO. Parcel

PROPERTY ADDRESS Old Frederick Road Lisbon
STREET TOWN/POST OFFICE

TAX MAP PAGE(S) 2 GRID 24 PARCEL(S) 32 PROPOSED LOT SIZE 33.47 Ac ±

AS APPLICANT, I UNDERSTAND THE FOLLOWING: THE SYSTEM INSTALLED SUBSEQUENT TO THIS APPLICATION IS ACCEPTABLE ONLY UNTIL PUBLIC SEWERAGE IS AVAILABLE. THIS APPLICATION IS COMPLETE WHEN ALL APPLICABLE FEES AND A SUITABLE SITE PLAN HAVE BEEN RECEIVED. I ACCEPT THE RESPONSIBILITY FOR COMPLIANCE WITH ALL M.O.S.H.A. AND "MISS UTILITY" REQUIREMENTS. APPROVAL IS BASED UPON SATISFACTORY REVIEW OF A PERC CERTIFICATION PLAN.

TEST RESULTS WILL BE MAILED TO APPLICANT.

Melanie Rupp
SIGNATURE OF APPLICANT


HOWARD COUNTY HEALTH DEPARTMENT, BUREAU OF ENVIRONMENTAL HEALTH, WELL AND SEPTIC PROGRAM
3525-H ELLICOTT MILLS DRIVE, ELLICOTT CITY, MARYLAND 21043-4544 (410) 313-1771 FAX (410) 313-2648
TDD (410) 313-2323 TOLL FREE 1-877-4MD-DHMH

AVP
 579
 Dense
 sil
 RD BRN
 Rx frags 3 1/2'
 4'
 DK brn
 Brn
 S Loam
 6'
 Hard
 SAP
 pocket
 w wall
 8' - 40% +
 ENOUGH
 SOIL AROUND
 SAP

577 OK 12' BOTTOM
 Strong
 rd brn
 red
 CLL 4 1/2'

Pink
 magenta
 rd brn
 yellow
 SLm
 Qtz frags
 SAP 20%
 Bottom 13'

575
 Dense
 RED SIL
 2'
 Wrd brn
 3'
 SIL - hvy
 Loam
 6'
 Str rd brn
 Str brn
 loam
 w/ SAP lite
 frags (small)
 ~35-45%
 Bottom 13'

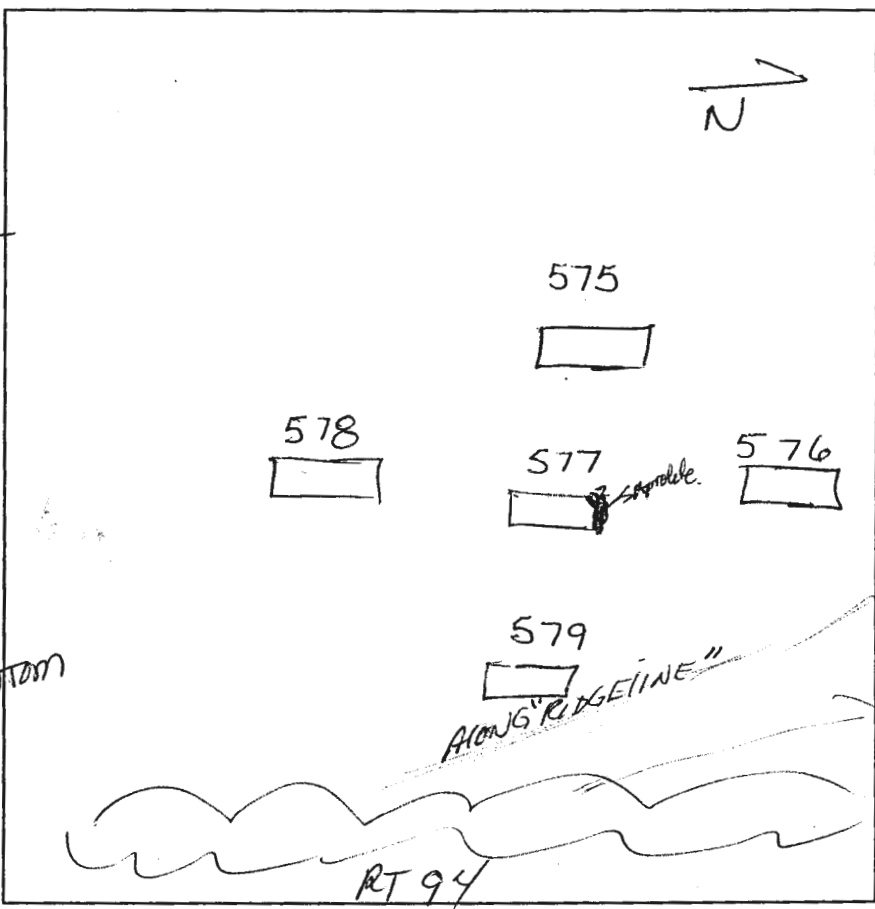


576
 DENSE
 org. mty
 Loam
 Rx < 50%
 3 1/2'
 4'
 brn
 y brn
 Loam -
 overall
 sm SAP
 frags 25-35%
 12'
 H. Bottom

578
 SEE
 577

DATE	TEST #	DEPTH	START	BREAK 1" DROP	STOP 2" DROP	TIME OF 2ND INCH	P/F/H
6/16/04	(579)	7' A	7:49	7:50 ⁺	7:53 ⁺	~3	P
		TESTING IN TX ZONE W/ ROCK					
		4' S'	7:51	7:53	7:55 ⁺	2 ⁺	P
	(577)	4' 8"	7:58	8:03	8:08	~5	P
	(575)	6' 1/2	8:06	8:08	8:11	3 min	P ^M
	(576)	4 1/2'	8:12	8:15	8:20	5 min	P
	(578)	SEE	577	BUT NO SAP or lite			P

REMARKS Holes dug on stake
 SANITARIAN Kace BACKHOE J. Brendel OTHERS _____
 TEST HOLES USED IN SDA _____ AVG. PERC TIME _____ SQ. FT/BR _____
 TRENCH WIDTH _____ INLET DEPTH _____ MAX. BOT DEPTH _____ EFFECTIVE S/W _____

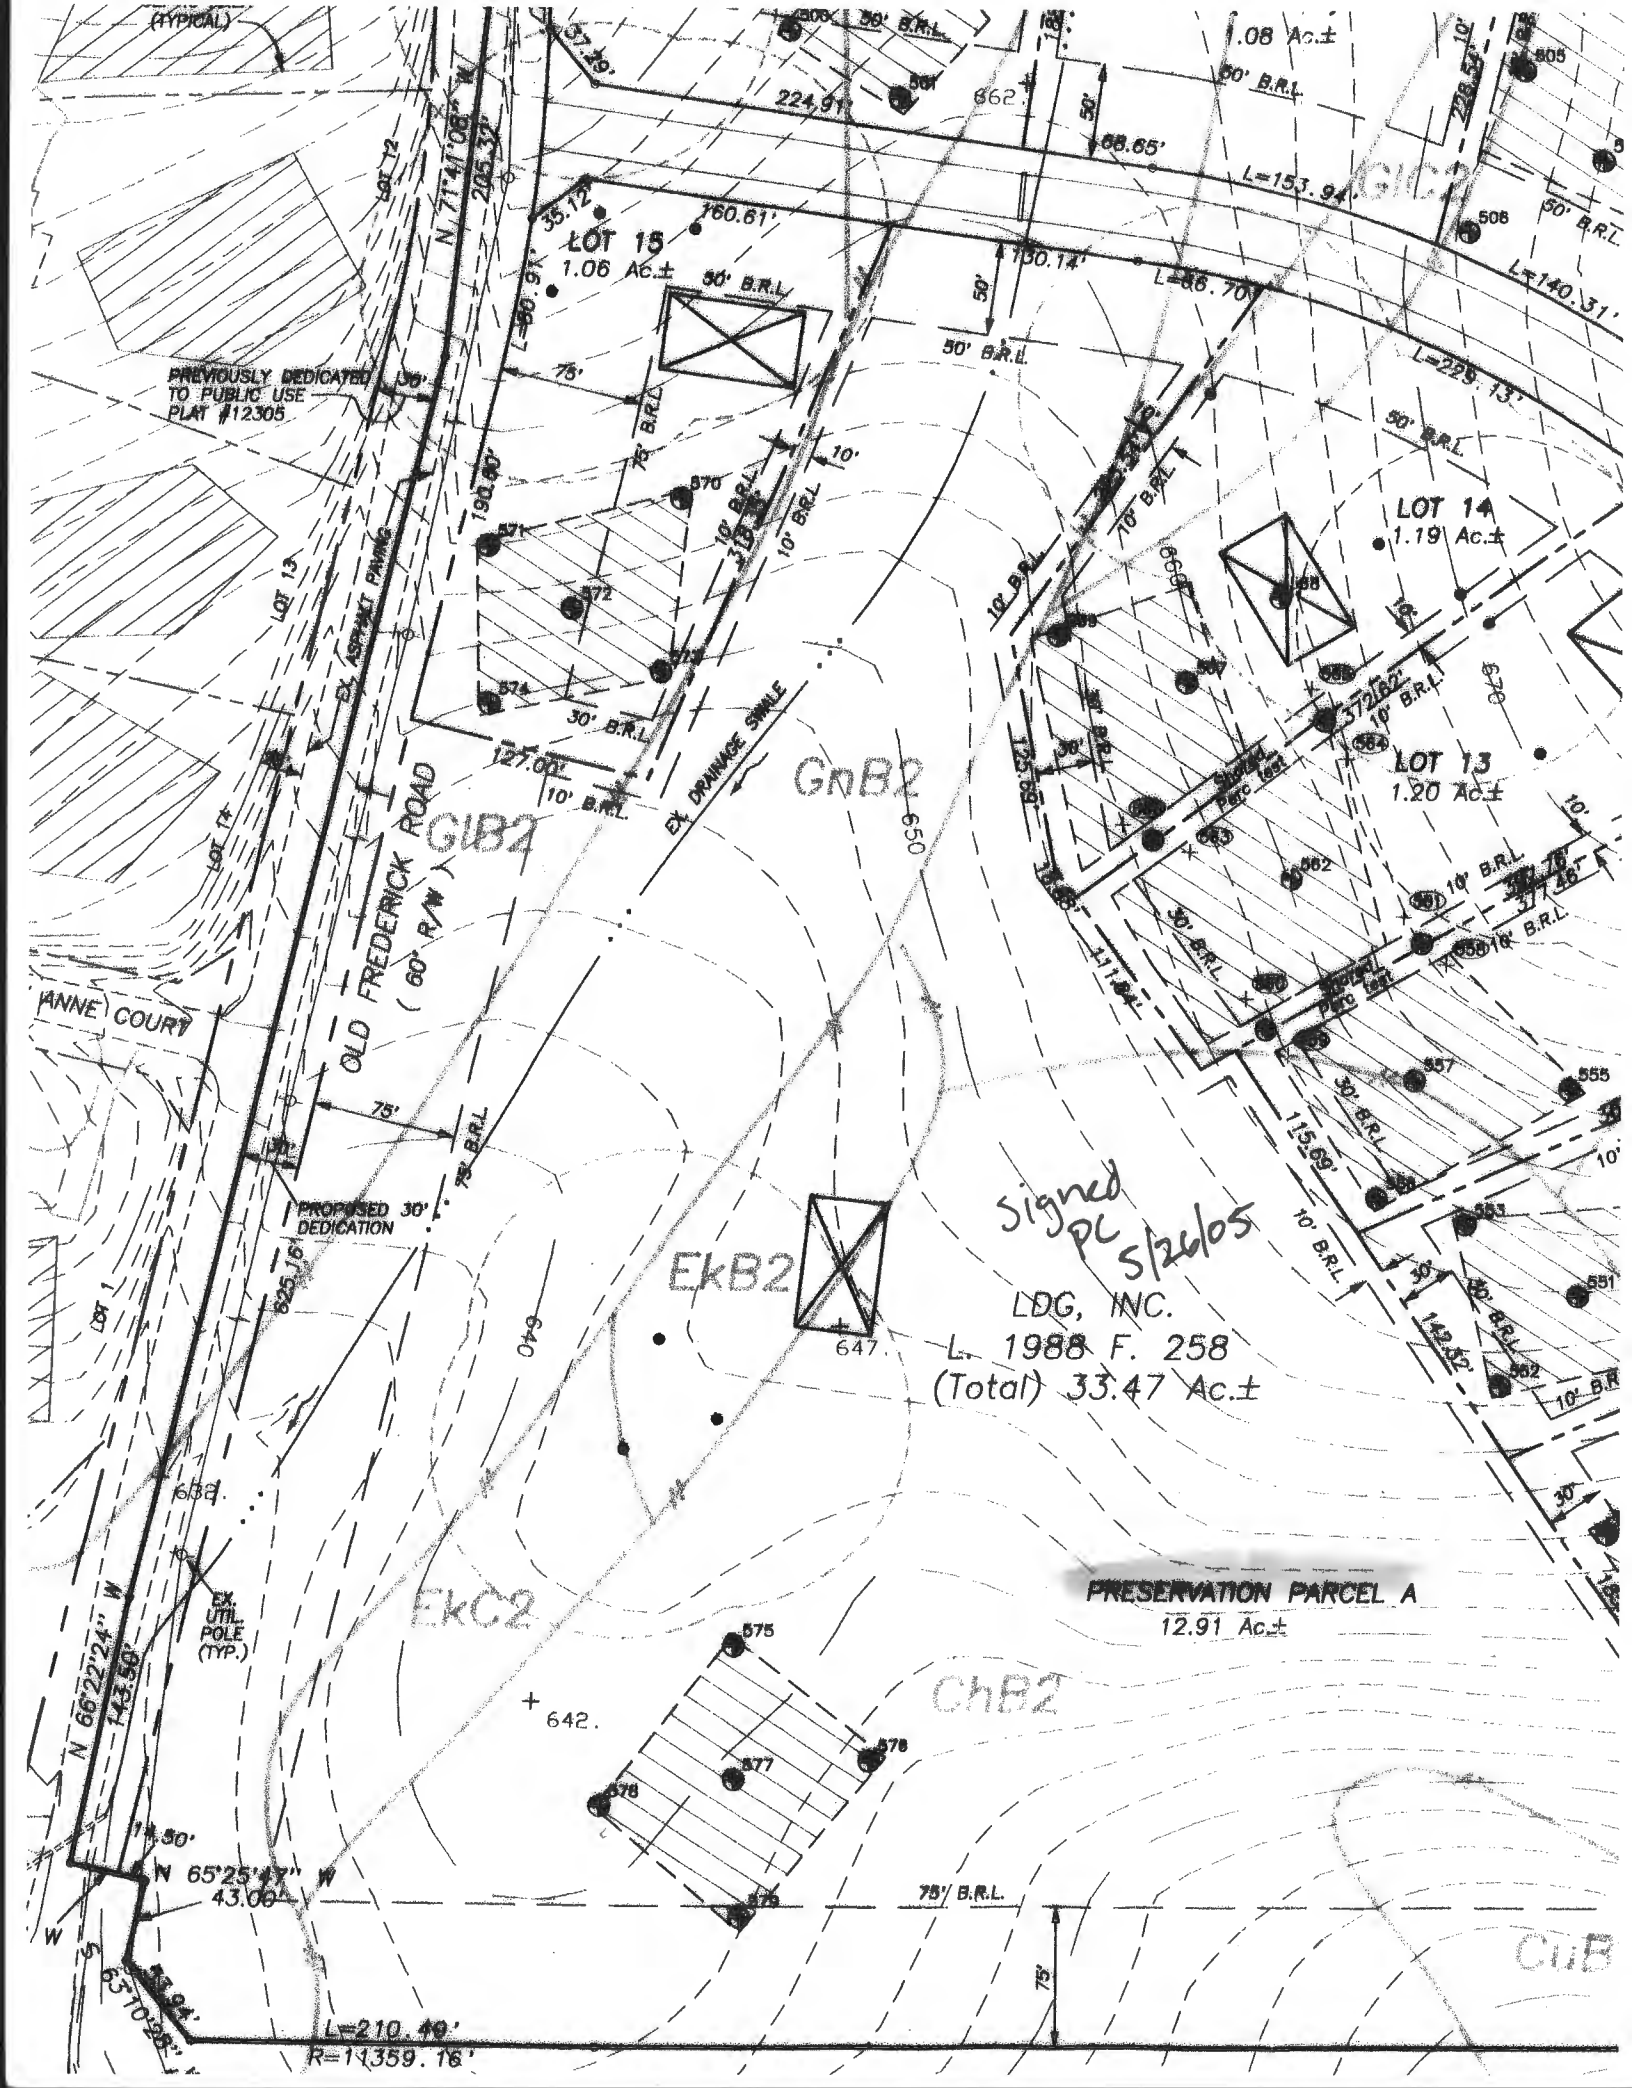

PREVIOUSLY DEDICATED
TO PUBLIC USE
PLAT #12305

OLD FREDERICK ROAD
(60' R/W)

ANNE COURT

PROPOSED 30'
DEDICATION

EX.
UTIL.
POLE
(TYP.)

EKB2

EKC2

ChB2

CuB

Signed
PC
5/26/05

LDG, INC.
L. 1988 F. 258
(Total) 33.47 Ac.±

PRESERVATION PARCEL A
12.91 Ac.±

LOT 15
1.06 Ac.±

LOT 14
1.19 Ac.±

LOT 13
1.20 Ac.±

- Need 2 compart. tank detail
- Raise tank
- Raise trenches invert
- Trenches on contour
- Lot lines accurate?
(doesn't match PC)
- down grad wells?

