

DATE Received
AUG 22 1988

DATE WELL COMPLETED
08 17 88

Depth of Well
22 503 26
(TO NEAREST FOOT)

PERMIT NO.
FROM "PERMIT TO DRILL WELL"
40-88-0077

OWNER
Wimsatt Construction Co., TE

STREET OR RFD
8401 Murphy Road

TOWN
Laurel

SUBDIVISION
Bracciale Property

SECTION

LOT
2

WELL LOG		
Not required for driven wells		
STATE THE KIND OF FORMATIONS PENETRATED, THEIR COLOR, DEPTH, THICKNESS AND IF WATER BEARING		
DESCRIPTION (Use additional sheets if needed)	FEET FROM TO	Check if water bearing
Dirt	0 1	
Soft Brown Mica & Red Clay	1 8	
Soft Brown Mica	8 30	
Hard Blue Mica	30 42	
Hard, Soft, Brown & Blue Mica	42 58	
Hard, Soft, Brown & Blue Mica	58 90	X
Hard Blue & Black Mica & Sandstone	90 390	X
Hard Black Granite	390 440	X
Hard Blue & Black Mica	440 503	

WELL HAS BEEN GROUTED (Circle Appropriate Box)
TYPE OF GROUTING MATERIAL
CEMENT **CM** BENTONITE CLAY **BC**

NO. OF BAGS 16 NO. OF POUNDS 1504

GALLONS OF WATER 96

DEPTH OF GROUT SEAL (to nearest foot)
from 0 48 ft. to 61 54 ft.
(enter 0 if from surface)

CASING RECORD
casing types insert appropriate code below
ST **CO**
STEEL CONCRETE
PL **OT**
PLASTIC OTHER

MAIN CASING TYPE
S **T**
Nominal diameter top (main) casing (nearest inch) 6 63
Total depth of main casing (nearest foot) 63 70

OTHER CASING (if used)
diameter inch depth (feet) from to

SCREEN RECORD
screen type or open hole insert appropriate code below
ST **BR** **HO**
STEEL BRASS OPEN HOLE
PL **OT**
PLASTIC OTHER

DEPTH (nearest ft.)
EACH SCREEN
1 **H** **O** 63 503
2
3

C 3

PUMPING TEST
HOURS PUMPED (nearest hour) 3
PUMPING RATE (gal. per min. to nearest gal.) 10
METHOD USED TO MEASURE PUMPING RATE **Submersible**
WATER LEVEL (distance from land surface)
BEFORE PUMPING 39
WHEN PUMPING 182
TYPE OF PUMP USED (for test)
A air **P** piston **T** turbine
C centrifugal **R** rotary **O** other (describe below)
J jet **S** **submersible**

PUMP INSTALLED
DRILLER WILL INSTALL PUMP YES (NO)
IF DRILLER INSTALLS PUMP, THIS SECTION MUST BE COMPLETED FOR ALL WELLS EXCEPT HOME USE
TYPE OF PUMP INSTALLED PLACE (A,C,J,P,R,S,T,O) IN BOX - SEE ABOVE:
CAPACITY: GALLONS PER MINUTE (to nearest gallon) 31 35
PUMP HORSE POWER 37 41
PUMP COLUMN LENGTH (nearest ft.) 43 47
CASING HEIGHT (circle appropriate box and enter casing height)
+ above **-** below
LAND SURFACE 2 (nearest foot)

CIRCLE APPROPRIATE LETTER
A A WELL WAS ABANDONED AND SEALED WHEN THIS WELL WAS COMPLETED
E ELECTRIC LOG OBTAINED
P TEST WELL CONVERTED TO PRODUCTION WELL

I HEREBY CERTIFY THAT THIS WELL HAS BEEN CONSTRUCTED IN ACCORDANCE WITH COMAR 10.17.13 "WELL CONSTRUCTION" AND IN CONFORMANCE WITH ALL CONDITIONS STATED IN THE ABOVE CAPTIONED PERMIT, AND THAT THE INFORMATION PRESENTED HEREIN IS ACCURATE AND COMPLETE TO THE BEST OF MY KNOWLEDGE.

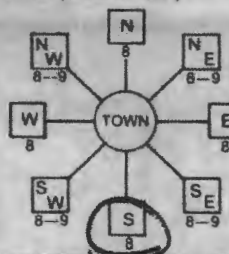

DRILLERS IDENT. NO. 296
Ronald L. Kyker
DRILLERS SIGNATURE (MUST MATCH SIGNATURE ON APPLICATION)
SITE SUPERVISOR (sign. of driller or journeyman responsible for sitework if different from permittee)

SLOT SIZE 1 2 3
DIAMETER OF SCREEN 56 60 (NEAREST INCH)
GRAVEL PACK
IF WELL DRILLED WAS FLOWING WELL INSERT F IN BOX 68
OEP USE ONLY (NOT TO BE FILLED IN BY DRILLER)
T (E.R.O.S.) WQ
70 72 74 75 76
TELESCOPE CASING LOG INDICATOR OTHER DATA

LOCATION OF WELL ON LOT
SHOW PERMANENT STRUCTURE SUCH AS BUILDING, SEPTIC TANKS, LANDMARKS AND INDICATE NOT LESS THAN TWO DISTANCES (MEASUREMENTS TO WELL)
Woodstock Rd
Md. 99
1 DRY Hole - 403 Ft.

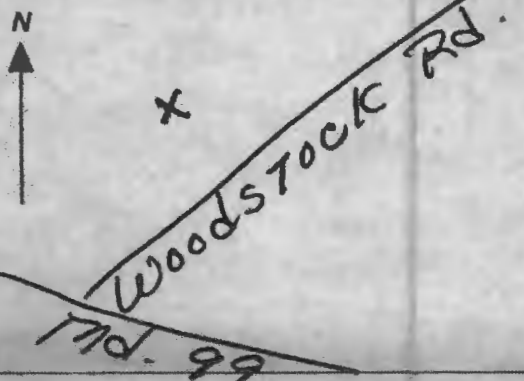
B 1 <div style="border: 1px solid black; padding: 2px; display: inline-block; font-size: 1.2em; font-weight: bold;">6319</div> <small>(THIS NUMBER IS TO BE PUNCHED IN COLS. 3-6 ON ALL CARDS)</small>	SEQUENCE NO. (DP USE ONLY) <div style="text-align: center; font-weight: bold;">STATE OF MARYLAND PERMIT TO DRILL WELL</div> <p style="text-align: center;">please print or type</p>	STATE PERMIT NUMBER <div style="border: 1px solid black; padding: 2px; display: inline-block; font-size: 1.2em; font-weight: bold;">H0-88-0077</div> <small>fill in this form completely</small>
---	---	---

Date Received (APA) <div style="border: 1px solid black; padding: 2px; display: inline-block; font-size: 1.2em; font-weight: bold;">072088</div> OWNER INFORMATION <div style="border: 1px solid black; padding: 2px; display: inline-block; font-size: 1.2em; font-weight: bold;">T E W. MURPHY</div> OWNER <div style="border: 1px solid black; padding: 2px; display: inline-block; font-size: 1.2em; font-weight: bold;">COWST. CO</div> FIRST NAME <div style="border: 1px solid black; padding: 2px; display: inline-block; font-size: 1.2em; font-weight: bold;">3401 MURPHY RD.</div> STREET OR RD. <div style="border: 1px solid black; padding: 2px; display: inline-block; font-size: 1.2em; font-weight: bold;">LAUREL</div> TOWN <div style="border: 1px solid black; padding: 2px; display: inline-block; font-size: 1.2em; font-weight: bold;">MD 20707</div> ZIP	B 3 LOCATION OF WELL <div style="border: 1px solid black; padding: 2px; display: inline-block; font-size: 1.2em; font-weight: bold;">HOWARD</div> COUNTY <div style="border: 1px solid black; padding: 2px; display: inline-block; font-size: 1.2em; font-weight: bold;">BRACCALES PROA</div> SUBDIVISION <div style="border: 1px solid black; padding: 2px; display: inline-block; font-size: 1.2em; font-weight: bold;">SECTION 44 46 LOT 2 48 50</div> <div style="border: 1px solid black; padding: 2px; display: inline-block; font-size: 1.2em; font-weight: bold;">WOODSTOCK</div> NEAREST TOWN <div style="border: 1px solid black; padding: 2px; display: inline-block; font-size: 1.2em; font-weight: bold;">1</div> MILES FROM TOWN (enter 0 if in town) <div style="border: 1px solid black; padding: 2px; display: inline-block; font-size: 1.2em; font-weight: bold;">MI</div>
---	--

DRILLER INFORMATION <div style="border: 1px solid black; padding: 2px; display: inline-block; font-size: 1.2em; font-weight: bold;">Ronald L. Kyker</div> DRILLER'S NAME <div style="border: 1px solid black; padding: 2px; display: inline-block; font-size: 1.2em; font-weight: bold;">Westminster Rotary Well Drilling, Inc.</div> FIRM NAME <div style="border: 1px solid black; padding: 2px; display: inline-block; font-size: 1.2em; font-weight: bold;">P.O. Box #861., Westminster, Md. 21157</div> <div style="border: 1px solid black; padding: 2px; display: inline-block; font-size: 1.2em; font-weight: bold;">Ronald L. Kyker</div> SIGNATURE <div style="border: 1px solid black; padding: 2px; display: inline-block; font-size: 1.2em; font-weight: bold;">07/15/88</div> DATE	B 4 DIRECTION OF WELL FROM TOWN (CIRCLE BOX)  ON WHICH SIDE OF ROAD (CIRCLE APPROPRIATE BOX)  <div style="border: 1px solid black; padding: 2px; display: inline-block; font-size: 1.2em; font-weight: bold;">Woodstock Road</div> NEAR WHAT ROAD <div style="border: 1px solid black; padding: 2px; display: inline-block; font-size: 1.2em; font-weight: bold;">400</div> DISTANCE FROM ROAD <div style="border: 1px solid black; padding: 2px; display: inline-block; font-size: 1.2em; font-weight: bold;">FT</div> ENTER FT or MI
---	--

WELL INFORMATION <div style="border: 1px solid black; padding: 2px; display: inline-block; font-size: 1.2em; font-weight: bold;">5</div> APPROX. PUMPING RATE (GAL. PER MIN.) <div style="border: 1px solid black; padding: 2px; display: inline-block; font-size: 1.2em; font-weight: bold;">350</div> AVERAGE DAILY QUANTITY NEEDED (GAL. PER DAY)	USE FOR WATER (CIRCLE APPROPRIATE BOX) <div style="border: 1px solid black; padding: 2px; display: inline-block; font-size: 1.2em; font-weight: bold;">D</div> HOME (SINGLE OR DOUBLE HOUSEHOLD UNIT ONLY) <div style="border: 1px solid black; padding: 2px; display: inline-block; font-size: 1.2em; font-weight: bold;">F</div> FARMING (LIVESTOCK WATERING & AGRICULTURAL IRRIGATION) <div style="border: 1px solid black; padding: 2px; display: inline-block; font-size: 1.2em; font-weight: bold;">I</div> INDUSTRIAL, COMMERCIAL, STATE AND FEDERAL GOV. OTHER (REQUIRES APPROPRIATION PERMIT) <div style="border: 1px solid black; padding: 2px; display: inline-block; font-size: 1.2em; font-weight: bold;">P</div> PUBLIC OR PRIVATE WATER COMPANY (REQUIRES APPROPRIATION PERMIT AND STATE HEALTH DEPARTMENT APPROVAL) <div style="border: 1px solid black; padding: 2px; display: inline-block; font-size: 1.2em; font-weight: bold;">T</div> TEST, OBSERVATION, MONITORING (MAY REQUIRE APPROPRIATION PERMIT)
---	---

<div style="border: 1px solid black; padding: 2px; display: inline-block; font-size: 1.2em; font-weight: bold;">200</div> APPROXIMATE DEPTH OF WELL FEET <div style="border: 1px solid black; padding: 2px; display: inline-block; font-size: 1.2em; font-weight: bold;">6"</div> APPROXIMATE DIAMETER OF WELL NEAREST INCH METHOD OF DRILLING (circle one) <div style="border: 1px solid black; padding: 2px; display: inline-block; font-size: 1.2em; font-weight: bold;">BORED (or Augered)</div> <div style="border: 1px solid black; padding: 2px; display: inline-block; font-size: 1.2em; font-weight: bold;">JETTED</div> <div style="border: 1px solid black; padding: 2px; display: inline-block; font-size: 1.2em; font-weight: bold;">Jetted & DRIVEN</div> <div style="border: 1px solid black; padding: 2px; display: inline-block; font-size: 1.2em; font-weight: bold;">AIR-ROTARY</div> <div style="border: 1px solid black; padding: 2px; display: inline-block; font-size: 1.2em; font-weight: bold;">AIR-PERCussion</div> <div style="border: 1px solid black; padding: 2px; display: inline-block; font-size: 1.2em; font-weight: bold;">ROTARY (Hydraulic Rotary)</div> <div style="border: 1px solid black; padding: 2px; display: inline-block; font-size: 1.2em; font-weight: bold;">CABLE</div> <div style="border: 1px solid black; padding: 2px; display: inline-block; font-size: 1.2em; font-weight: bold;">REVERSE-ROTARY</div> <div style="border: 1px solid black; padding: 2px; display: inline-block; font-size: 1.2em; font-weight: bold;">Drive-POINT</div> <div style="border: 1px solid black; padding: 2px; display: inline-block; font-size: 1.2em; font-weight: bold;">other</div>	NOT TO BE FILLED IN BY DRILLER HEALTH DEPARTMENT APPROVAL <div style="border: 1px solid black; padding: 2px; display: inline-block; font-size: 1.2em; font-weight: bold;">Howard</div> COUNTY NAME <div style="border: 1px solid black; padding: 2px; display: inline-block; font-size: 1.2em; font-weight: bold;">A34925</div> COUNTY NO. <div style="border: 1px solid black; padding: 2px; display: inline-block; font-size: 1.2em; font-weight: bold;">080988</div> DATE ISSUED <div style="border: 1px solid black; padding: 2px; display: inline-block; font-size: 1.2em; font-weight: bold;">2/4/89</div> EXP. DATE <div style="border: 1px solid black; padding: 2px; display: inline-block; font-size: 1.2em; font-weight: bold;">542000</div> NORTH GRID <div style="border: 1px solid black; padding: 2px; display: inline-block; font-size: 1.2em; font-weight: bold;">0833000</div> EAST GRID
---	--

REPLACEMENT OR DEEPEMED WELLS (CIRCLE APPROPRIATE BOX) <div style="border: 1px solid black; padding: 2px; display: inline-block; font-size: 1.2em; font-weight: bold;">N</div> THIS WELL WILL NOT REPLACE AN EXISTING WELL <div style="border: 1px solid black; padding: 2px; display: inline-block; font-size: 1.2em; font-weight: bold;">Y</div> THIS WELL WILL REPLACE A WELL THAT WILL BE ABANDONED AND SEALED <div style="border: 1px solid black; padding: 2px; display: inline-block; font-size: 1.2em; font-weight: bold;">S</div> THIS WELL WILL REPLACE A WELL THAT WILL BE USED AS A STANDBY <div style="border: 1px solid black; padding: 2px; display: inline-block; font-size: 1.2em; font-weight: bold;">D</div> THIS WELL WILL DEEPEMED AN EXISTING WELL <div style="border: 1px solid black; padding: 2px; display: inline-block; font-size: 1.2em; font-weight: bold;">41</div> PERMIT NUMBER OF WELL TO BE REPLACED OR DEEPEMED (IF AVAILABLE) <div style="border: 1px solid black; padding: 2px; display: inline-block; font-size: 1.2em; font-weight: bold;">52</div>	SHOW MAJOR FEATURES OF BOX & LOCATE WELL WITH AN X SOURCES OF DRILLING WATER 1. City 2. 3. WRITE THE BOX NUMBER FROM THE MAP HERE <div style="border: 1px solid black; padding: 2px; display: inline-block; font-size: 1.2em; font-weight: bold;">83</div> BOX NUMBER <div style="border: 1px solid black; padding: 2px; display: inline-block; font-size: 1.2em; font-weight: bold;">54</div> BOX NUMBER DRAW A SKETCH BELOW SHOWING LOCATION OF WELL IN RELATION TO NEARBY TOWNS AND ROADS AND GIVE DISTANCE FROM WELL TO NEAREST ROAD JUNCTION 
---	--

Not to be filled in by driller (OEP USE ONLY) <div style="border: 1px solid black; padding: 2px; display: inline-block; font-size: 1.2em; font-weight: bold;">GAP</div> APPROP. PERMIT NUMBER <div style="border: 1px solid black; padding: 2px; display: inline-block; font-size: 1.2em; font-weight: bold;">CL</div> WRITE INITIALS IN BOX <div style="border: 1px solid black; padding: 2px; display: inline-block; font-size: 1.2em; font-weight: bold;">H0-88-0077</div> PERMIT NO. SPECIAL CONDITIONS <div style="border: 1px solid black; padding: 2px; display: inline-block; font-size: 1.2em; font-weight: bold;">490-3666</div>	<div style="border: 1px solid black; padding: 2px; display: inline-block; font-size: 1.2em; font-weight: bold;">H0-88-0077</div> PERMIT NO.
---	--

HOWARD COUNTY HEALTH DEPARTMENT
BUREAU OF ENVIRONMENTAL HEALTH
WELL & SEPTIC PROGRAM
TEL: (410) 313-1771 FAX: (410) 313-2648

Information Form for the Installation of the Well Pump, Pileless Adapter, and Supply Line

NOTE: The installer is responsible for requesting an inspection prior to 9 am on the day of the desired inspection. No work is to be covered until approved by the Health Department. All installations must comply with the National Standard Plumbing Code (NSPC, as amended locally) and COMAR 26.04.04 (MD Well Construction Regulations). Submission of a complete form is required prior to Use and Occupancy approval.

Company Name: Fogles Well Pumps & Water Treatment, LLC Telephone: 410 795 5670
Address: 580 Obrecht Rd
Syring, MD 21784

(Must circle one) Licensed Plumber ☒ Licensed Well Driller ☒ Licensed Well Pump Installer
License # and name of individual responsible for the field installation:

Name (Print): David C Fogle License #: MSD226

*A licensed individual must perform the actual installation. Apprentices must be under the supervision of a licensed journeyman or master plumber, pump installer or well driller. Licenses may be subjected to field verification. Unlicensed individuals may be reported to the appropriate licensing agency.

Name of Property Owner: Budell Ward Telephone: _____
Subdivision: _____ Lot #: _____ Well Tag #: HO-488-0077
Site Address: 1820 Woodstock Rd
Woodstock, MD 21163

Submersible Pump Data: Pileless Adapter: Well Cap and Electric Conduit:
Make: _____ Make: _____ Two piece watertight cap: _____
Model #: _____ Model #: _____ Screened, vented well cap: _____
Pump Capacity: _____ GPM Depth: (36" min) _____ Cap secured to casing: _____
Well Yield: 10 GPM NSF/ANSI approved: _____ Conduit min 1" E.G.: _____
Depth of well encountered at time of pump installation: 500 (ft) Conduit secured to well cap: _____
If pump capacity exceeds well yield, a low water cutoff switch is required by NSPC 1990 Section 17.3.4
Torque wrenches, Cable guards, or other acceptable method used - Must circle one
Safety rope, if used, attached to Ingers rope adapter or other acceptable method inside of well casing.

Pipe to house: _____ House Connection: existing well line
Type: 1" poly pipe PVC sleeve to undisturbed soil at wall penetration: yes
PSI: 300 (psi) Length of sleeve (5' minimum from foundation): 10'
Depth of supply line: 36" (36" min) Sleeve sealed properly: yes

The water supply line is required to be at least 18 feet from the septic tank, pump chamber, sewage piping, distribution box, drainfields, and sewage reserve area. If this cannot be accomplished, contact this office for approval prior to installation.

Signature of company representative responsible for installation: David C Fogle date: 9/26/19

For Health Department Use Only - Not to be completed by installer

Date Insp Requested: 9/26/19 Date Insp Approved: 9/27/19 Inspector: SP

Inspection Data: Pileless adapter, watertight & water supply line at least 36" below grade ✓
Two piece cap installed and attached to casing securely ✓
Elec. conduit extends at least 18" below grade/attached to cap properly ✓
Safety rope not outside of well cap/lashing ✓
Correct well tag attached properly and casing 8" above finished grade ✓
Water supply line sleeved adequately at house connection ✓
Adequate grout observed below pileless adapter ✓

← will connect electric and run w/ well line.

2.5'

8' casing

outside house
ex. well

INTERIM CERTIFICATE OF POTABILITY

Expiration Date – NOVEMBER 6, 2020

May 6, 2020

Homeowner
1820 Woodstock Road
Woodstock, MD 21163

**RE: Parkside, Lot 16
1820 Woodstock Road
Building Permit: B19000383
Well Permit: HO-88-0077**

Dear Homeowner:

This is to advise you that the septic system installation and water well construction for the above referenced property have been inspected and approved. Final approval of the septic system was granted on **1/7/2020**. Final approval of the well line connection to the dwelling was granted on **9/27/2019**. The well construction was completed on **8/17/1988**. Water samples were collected on **5/1/2020**.

The water sample results indicate that the water samples submitted for testing were free of coliform and fecal coliform bacteria at the time of sampling and are bacteriologically safe for drinking. This certifies that the initial sampling requirements of COMAR 26.04.04 "Well Regulations" have been met for the water supply system installed under well permit HO-88-0077. Although the submitted sample results are in compliance with COMAR standards, the Health Department does not guarantee water supplies.

This Interim Certificate of Potability will expire **six months** from the date of issuance. Submission of a second bacteriological test indicating the water is free of coliform and fecal coliform bacteria is required prior to the expiration date, after which time a Final Certificate of Potability will be issued. **Failure to submit an additional sample and obtain a Final Certificate of Potability will result in a Notice of Violation and is punishable as a misdemeanor under the *Annotated Code of Maryland, Environment Article, 9-1311*, subject to a fine of up to \$500 or imprisonment not to exceed three months.**

Please contact (410) 313-1773 to schedule a final water sample appointment or contact a Maryland certified water laboratory to schedule a water sample. A list of laboratories certified by the state of Maryland may be found at the following website:

<http://www.mde.state.md.us/assets/document/WSP-Labs-2010apr16.pdf>



Bureau of Environmental Health
8930 Stanford Blvd | Columbia, MD 21045
410.313.2640 - Voice/Relay
410.313.2648 - Fax
1.866.313.6300 - Toll Free

Maura J. Rossman, M.D., Health Officer

In closing, please refer to our "Homeowner Fact Sheet" which illustrates a better understanding for your Onsite Sewage Disposal System. You will also find a link to Maryland Department of the Environments website which describes in further detail operation and maintenance of your septic system.

Approving Authority,

Kevin M. Wolf, LEHS, R.S./REHS, Supervisor
Groundwater Management Section
Well & Septic Program

cc: Howard County Dept. of Inspections, Licenses, and Permits
Community Hygiene Program
File

FOUNTAIN VALLEY ANALYTICAL LABORATORY, INC.

1413 Old Taneytown Rd. Westminster, MD (410) 848-1014 (410) 876-4554 FAX (410) 848-0298

REPORT OF ANALYSIS

Laboratory ID #: 137041 Account #: 1933
Reference: Gudell Ward Company: Fogles Well Pump & Treatment
Location: 1820 Woodstock Road Requested By: Dave Fogle
Woodstock, MD 21163 Source: Well Water
Date/ Time Collected: 5/1/2020 1115 Site: Kitchen Sink Tap
Date/Time Rec'd: 5/1/2020 1225 Treatment: None
Chlorine ppm: Free: ND Total: ND pH: 7.1
Collected By: J. Evans 0309JE Well #: HO-88-0077

PARAMETERS	RESULTS	UNITS	REFERENCE	METHOD	DATE/TIME/ANALYST
Bacteria, Coliform, Total, MPN	<1.0	MPN/ 100 ml	<1.0	SM20 9223B	5/2/2020 / 1000 / BCD
Bacteria, E. coli, MPN	<1.0	MPN/ 100 ml	<1.0	SM20 9223B	5/2/2020 / 1000 / BCD
Nitrate	<1.0	mg/L	10	601	5/1/2020 / 1500 / CRS
Turbidity	0.49	NTU	<10	SM20 2130B	5/1/2020 / 1520 / CRS
Sand	NS	mg/L	5	Visual/Gravimetric	5/1/2020 / 1520 / CRS

NOTES

- 1 mg/L = milligrams per liter (also, parts per million)
- 2 MPN/ 100 ml = Most Probable Number [of viable bacteria] per 100 ml of sample.
- 3 NS = None Seen (NS indicates less than 5 mg/L)
- 4 NTU = Nephelometric Turbidity Units
- 5 Results less than or within the reference range are considered satisfactory and within potable water limits at the time of sampling.
- 6 Sample collected by client, analyzed as received
- 7 ND = None Detected; N/A: Not Available
- 8 Sample collected by client, analyzed as received
- 9 Visual well check: Sealed, vented cap

Reason for Test : Use & Occupancy

Building Permit # : 19000383


Date Reported: 5/4/2020

Maura J. Rossman, M.D., Health Officer

MEMORANDUM

Sent via email to gward@imecgroupllc.com

TO: Gudell Ward (owner)

FROM: Kevin M. Wolf, LEHS, REHS/RS, Supervisor 
Groundwater Mgmt. Sec.
Well & Septic Program

DATE: January 28, 2019

RE: **1820 Woodstock Road**
Woodstock, MD 21163
M. 10 G. 23 P. 36 3.091AC
(Demolition of existing building – rebuild new SFD)

This is to advise that the Howard County Health Department recommends issuance of the demolition permit for the above referenced property.

The existing well (HO-88-0077) that was used for the existing dwelling will be utilized for the new single-family dwelling. Standard potability testing must occur at a minimum once the well is connected to the new dwelling. Protective devices (i.e. snow fencing, etc.) must be installed around the well and be kept in place during demolition and construction phases of the project.

The existing septic system was pumped out by Freedom septic on 1/25/2019. A copy of the invoice was submitted to our office for confirmation. The septic tank will be collapsed during demolition. Documentation of this abandonment must be submitted to our office for review of compliance. Pictures of the abandonment are not required but are encouraged.

If plans to rebuild on this parcel you will must install the new septic system per Howard county code and the approved percolation certification plan.

IF ANY WELL OR SEPTIC COMPONENTS ARE FOUND DURING SITE WORK, YOU MUST NOTIFY THIS OFFICE IMMEDIATELY!!

KMW
Cc: File

FREEDOM SEPTIC SERVICE, INC.

JOB WORK ORDER

24 Hour Service
2809 Liberty Road
Eldersburg, Maryland 21784
(410) 795-2947

DATE OF ORDER

PHONE

BILL TO

ADDRESS

CITY

LOCATION OF SEPTIC

LAST PUMPED

NEW CUSTOMER

DESCRIPTION OF WORK

Pump Septic

Will pay w/ cc

Friday 1/25/19

A 15% Late Charge will be assessed 30 days after date of service.

NOTICE TO CUSTOMERS

I understand that Freedom Septic Service, Inc. is not responsible for any damage to driveway or lawn while rendering services on the above property.

1/25/19 Andy
Date Completed

TOTAL MATERIALS		
TOTAL LABOR		
TAX		
TOTAL AMOUNT	\$225	—

- ☐ NO ONE AT HOME
☐ TOTAL AMOUNT DUE FOR ABOVE WORK; OR
☐ TOTAL BILLING TO BE MAILED AFTER COMPLETION OF THE WORK

Signature

I hereby acknowledge the satisfactory completion of the above described work