

DEPARTMENT OF INSPECTIONS, LICENSES AND PERMITS
3430 COURT HOUSE DRIVE
ELLCOTT CITY, MD 21043
PERMITS (410) 313-2455 INSPECTIONS (410) 313-1810
AUTOMATED INFORMATION (410) 313-3800

HOWARD COUNTY
PERMIT APPLICATION

PERMIT NUMBER
B09002602

Building Address 2822 SpazzBRe Ct
Suite/Apt. #: _____ SDP/WP/Petition #: _____
Census Tract _____ Subdivision _____
Section _____ Area _____ Lot 14
Tax Map _____ Parcel _____ Grid _____
Zoning _____ Map Coordinates _____ Lot size _____
Existing Use _____
Proposed Use _____
Estimated Construction Cost \$ _____
Description of Work _____
Occupant or Tenant _____
Contact Name _____
Address _____
City _____ State _____ Zip Code _____
Phone _____ Fax _____

Property Owner's Name _____
Address _____
City _____ State _____ Zip Code _____
Home Phone _____ Work Phone _____
Applicant's Name & Mailing Address, (if other than stated hereon): _____
Phone _____ Fax _____
Contractor Company _____
Contact Person _____
Address _____
City _____ State _____ Zip Code _____
License No. CAS 4083
Phone _____ Fax _____
Engineer or Architect Company _____
Contact Person _____
Address _____
City _____ State _____ Zip Code _____
Phone _____ Fax _____

BUILDING DESCRIPTION - COMMERCIAL

Building Characteristics

Utilities

BUILDING DESCRIPTION - RESIDENTIAL

Building Characteristics

Utilities

THE UNDERSIGNED HEREBY CERTIFIES AND AGREES AS FOLLOWS: (1) THAT HE/SHE IS AUTHORIZED TO MAKE THIS APPLICATION; (2) THAT THE INFORMATION IS CORRECT; (3) THAT HE/SHE WILL COMPLY WITH ALL REGULATIONS OF HOWARD COUNTY WHICH ARE APPLICABLE THERETO; (4) THAT HE/SHE WILL PERFORM NO WORK ON THE ABOVE REFERENCED PROPERTY NOT SPECIFICALLY DESCRIBED IN THIS APPLICATION; (5) THAT HE/SHE GRANTS COUNTY OFFICIALS THE RIGHT TO ENTER ONTO THIS PROPERTY FOR THE PURPOSE OF INSPECTING THE WORK PERMITTED AND POSTING NOTICES.

Applicant's Signature
Title/Company

Print Name
Date

Checks payable to: DIRECTOR OF FINANCE OF HOWARD COUNTY
** PLEASE WRITE NEATLY AND LEGIBLY. **
FOR OFFICE USE ONLY

AGENCY
Land Development DPZ
State Highway
Building Official
Dev. Engineering DPZ
Health 10/13/2009
Fire Protection
Is Sediment Control approval required prior to issuance?
YES ☐ NO ☐
CONTINGENCY CONSTRUCTION START: ☐
ONE STOP SHOP: ☐
Distribution of Copies: White: Building Official Green: LDD, DPZ
T:\forms\PERMIT.FRM

DPZ SETBACK INFORMATION
Front: _____ Filing fee \$ _____
Rear: _____ Permit fee \$ _____
Side: _____ Excise tax \$ _____
Side St: _____ Add'l per. fee \$ _____
All minimum setbacks met? YES ☐ NO ☐ TOTAL FEES \$ _____
Is Entrance Permit required? YES ☐ NO ☐ Sub-total paid \$ _____
Historic District? YES ☐ NO ☐ Balance due \$ _____
Lot Coverage for New Town Zone _____ Check # _____
SDP/Red-line approval date _____ Validation # _____
Accepted by _____


Rev. 11/4/04

SADDLEBRED COURT

50' RIGHT-OF-WAY

R=50.00'

L=26.18'

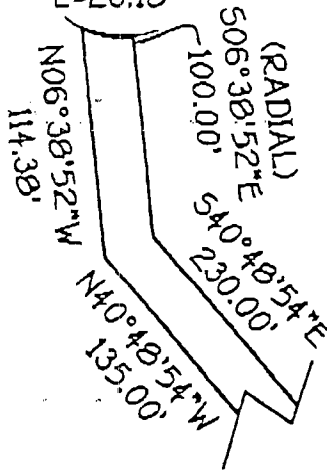


PROPOSED 1000 GAL.
UG PROPANE TANK

Approved Septic System Plan
Howard County Health Department

LP tank (1000 gal, underground)
approved as shown

R. Buckner
Signature

10/13/2009
Date

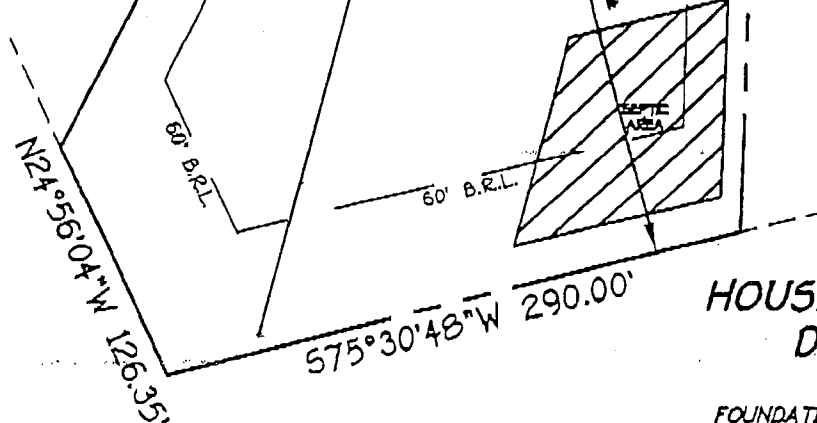

HOUSE LOCATION
DRAWING

LOT 14
GLENWOOD SPRINGS
SECTION ONE, AREA ONE
LOTS 1 THRU 44
FOURTH ELECTION DISTRICT
HOWARD COUNTY, MARYLAND
PLAT. NO. 7679-7681

FOUNDATION LOCATION:
FINAL LOCATION: *09/23/09*
BOUNDARY SURVEY:

SCALE: 1"=100'
DATE: *9/25/09*
DRAWN BY: *VLJ*
CHECKED BY: *MLR*
PROJECT No.: *09033-7001*



RECEIVED
HOWARD COUNTY HEALTH DEPT
ENVIRONMENTAL HEALTH

2009 OCT -2 PM 1:32

Approved for release by the
Howard County Health Department

2