

Bureau of Environmental Health
7178 Gateway Drive Columbia, MD 21046
(410) 313-2640 Fax (410) 313-2648
TDD (410) 313-2323 Toll Free 1-866-313-6300
website: www.hchealth.org

Maura J. Rossinan, M.D., Acting Health Officer

APPLICATION

FOR PERCOLATION TESTING AND SITE EVALUATION

PROPERTY LOCATION

SUBDIVISION/PROPERTY NAME _____

LOT # _____

PROPERTY ADDRESS 1026 St Michaels Rd MT AIRY MD 21771
STREET TOWN ZIP

TAX ACCOUNT # _____ TAX MAP 7 GRID 2 PARCEL 23 ZONING DESIGNATION _____

PROPERTY OWNER(S) Patricia Roozer

DAYTIME PHONE 410-840-9220 CELL _____ EMAIL Pa.Roozer@comcast.net

MAILING ADDRESS 1026 St Michaels Rd CITY, STATE _____ ZIP _____
STREET

APPLICANT Fogle's Septic Clean RELATIONSHIP TO OWNER: Contractor

DAYTIME PHONE 410-795-5670 CELL _____ EMAIL Kim@foglesinc.com

MAILING ADDRESS 580 Obrecht Rd. Sykesville MD 21784
STREET CITY, STATE ZIP

I HEREBY APPLY FOR THE NECESSARY TESTING/EVALUATION PRIOR TO ISSUANCE OF SEWAGE DISPOSAL SYSTEM PERMIT(S):

BUILDING:

- ☒ RESIDENTIAL WITH 3 EXISTING OR PROPOSED BEDROOMS IN THE COMPLETED STRUCTURE
☐ COMMERCIAL (PROVIDE DETAIL OF TYPE OF USE AND NUMBERS OF EMPLOYEES/CUSTOMERS ON ACCOMPANYING PLAN)

PROPERTY:

- ☐ SUBDIVISION: NUMBER OF LOTS INCLUDING RESIDUE: _____
☐ CONSTRUCT NEW OSDS ON UNDEVELOPED LOT
☒ REPAIR OR REPLACE FAILING OSDS
☐ UPGRADE EXISTING OSDS

IS THE PROPERTY WITHIN 2500 FEET OF ANY RESERVOIR?

- ☒ YES
☐ NO

AS APPLICANT, I UNDERSTAND THE FOLLOWING:


- THIS APPLICATION IS VALID FOR TWO(2) YEARS FROM DATE OF FEE PAYMENT AND APPROVAL IS BASED UPON HEALTH OFFICER SIGNATURE OF A PERC CERTIFICATION PLAN PRIOR TO EXPIRATION OF THIS PERMIT.
- THE APPLICATION FEE IS NON-REFUNDABLE
- THIS APPLICATION MUST BE ACCOMPANIED BY ALL APPLICABLE FEES AND A SUITABLE SITE PLAN IN ORDER TO BE PROCESSED
- THIS IS A PUBLIC DOCUMENT

I declare and affirm that to the best of my knowledge, the information contained herein is correct. I declare that I am the owner of the property or duly authorized to make this application on behalf of the owner. I agree to comply with all applicable state and county regulations.

By signature of this application, I hereby grant Howard County Health Department officials the right to enter onto the property for the purpose of inspecting the property as directly related to the requested permit/service.

SIGNATURE OF APPLICANT

DATE

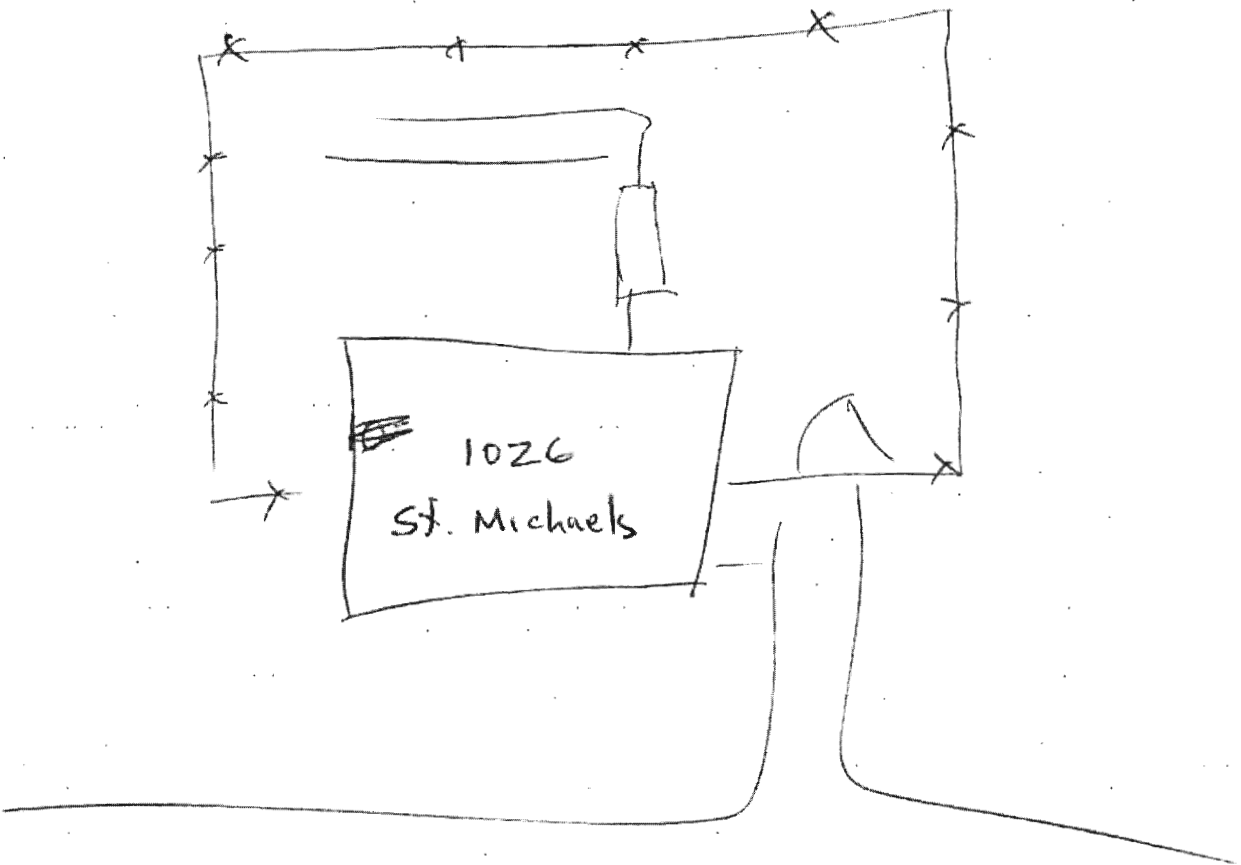



2600 LONGSTONE LANE, #204
MARRIOTTSVILLE, MD 21104

WWW.HUNTSENDREMODELING.COM

July 6, 2018

Michael J. Davis
Assistant Director
Howard County Health Department
Bureau of Environmental Health
8930 Stanford Blvd, Columbia, MD 21045

RE: Request For Percolation Certification Waiver for Addition

Mr. Davis,

We are proposing to build a 12x24' addition off the left side of the existing house at 1026 Saint Michaels Road, Mount Airy, MD 21771. We are seeking a waiver for the percolation certification test to enable the homeowner to obtain a building permit for the purpose of additional family room space and a laundry room over a crawl space. The existing septic system was recently repaired in 2015 and due to the lot size of 7.5 acres, there is ample room for future improvements if necessary.

The records from the 2015 repair, as well as the proposed drawings and site plan are attached.

If there is any additional information needed, please let me know.

Sincerely,

A handwritten signature in black ink, appearing to read "M. Birner", with a horizontal line extending to the right.

Michael J. Birner
Architect, CGR
President
Hunt's End Remodeling, LLC

THIS DOCUMENT IS CERTIFIED TO:



**CLASSIC
SETTLEMENTS**

Papadimitriou & Associates

"Experience the Classic Difference"

CASE #: 152473JSW



**CLASSIC
SETTLEMENTS**

Papadimitriou & Associates

"Experience the Classic Difference"



N 19°39' E
300' (Record)

100' 200'
P/O LOT E
LOT D


N 69°46' W (Record)
1105.68' (Comp)

LOT D & P/O LOT E
A.K.A. PARCEL 23
LIBER 15558,
FOLIO 267

EXISTING SEPTIC
SHED 8
SHED 8

#1026
1 1/2 STORY
FRAME

S 69°46' E
1100' (Record)

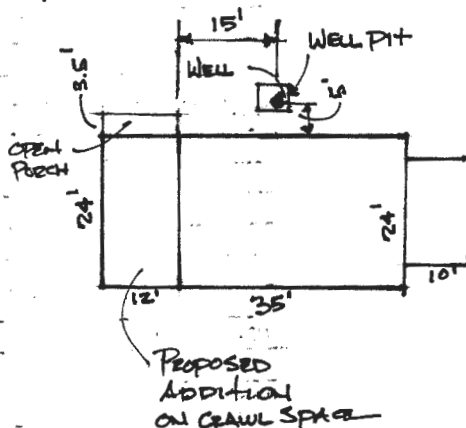

ENLARGED VIEW @ House
1"=30'

S 17°30' W (Record) S 19°39' W (Record)
151.27' (Comp) 148.89' (Comp)

SAINT MICHAELS ROAD

LOCATION DRAWING OF:

#1026 SAINT MICHAELS ROAD

LOT D & PART OF LOT E

POPLAR HEIGHTS

A.K.A. PARCEL 23, TAX MAP 7

N/F PROPERTY OF

PATRICIA A. ROUZER

LIBER: 15558 FOLIO: 267

HOWARD COUNTY, MARYLAND

SCALE: 1"=180' DATE: 08-19-2015

DRAWN BY: CPI/AP FILE #: 155033-334

LEGEND:

— FENCE
BE - BASEMENT ENTRANCE
BW - BAY WINDOW
BR - BRICK
BRL - BLDG. RESTRICTION LINE
BSMT - BASEMENT
CB - CONCRETE STOOP
CONC - CONCRETE
DNW - DRIVEWAY
FR - FRAME
MAC - MACADAM
OH - OVERHANG
PUE - PUBLIC UTILITY EMB.

COLOR KEY:

(RED) - RECORD INFORMATION
(BLUE) - IMPROVEMENTS
(GREEN) - EMBTS & RESTRICTION LINES

A Land Surveying Company

DULEY

and

Associates, Inc.

Serving D.C. and MD.

14804 Elm Street, Upper Marlboro, MD 20772

Phone: 301-888-1111

Fax: 301-888-1114

Email: orders@duley.biz

On the web: www.duley.biz

SURVEYOR'S CERTIFICATE

I HEREBY STATE THAT I WAS IN RESPONSIBLE CHARGE OVER THE PREPARATION OF THIS DRAWING AND THE SURVEY WORK REFLECTED HEREIN AND IT IS IN COMPLIANCE WITH THE REQUIREMENTS SET FORTH IN REGULATION 12 CHAPTER 08-13.06 OF THE CODE OF MARYLAND ANNOTATED REGULATIONS. THIS SURVEY IS NOT TO BE USED OR RELIED UPON FOR THE ESTABLISHMENT OF FENCES, BUILDING, OR OTHER IMPROVEMENTS. THIS PLAT DOES NOT PROVIDE FOR THE ACCURATE IDENTIFICATION OF PROPERTY BOUNDARY LINES, BUT SUCH IDENTIFICATION MAY NOT BE REQUIRED FOR THE TRANSFER OF TITLE OR SECURING FINANCING OR REFINANCING. THIS PLAT IS OF BENEFIT TO A CONSUMER ONLY INsofar AS IT IS REQUIRED BY A LENDER OR A TITLE INSURANCE COMPANY OR ITS AGENTS IN CONNECTION WITH THE CONTEMPLATED TRANSFER, FINANCING OR REFINANCING. THE LEVEL OF ACCURACY FOR THIS DRAWING IS 2". NO TITLE REPORT WAS FURNISHED TO ME BY THE COMPANY. SAID PROPERTY SUBJECT TO ALL NOTICES, RESTRICTIONS AND EASEMENTS OF RECORD. BUILDING RESTRICTION LINES AND EASEMENTS MAY NOT BE SHOWN ON THIS SURVEY. IMPROVEMENTS SHOWN IN THE SURVEYOR'S OPINION APPEAR TO BE BY A STATE OF DISREPAIR OR MAY BE CONSIDERED "TEMPORARY" MAY NOT BE SHOWN. IF IT APPEARS ENCROACHMENTS MAY EXIST, A BOUNDARY SURVEY IS RECOMMENDED.


DULEY & ASSOC.

WILL GIVE YOU A 100%
FULL CREDIT TOWARDS
UPGRADING THIS
SURVEY TO A
"BOUNDARY/STAKE"
SURVEY FOR ONE
YEAR FROM THE DATE
OF THIS SURVEY

(EXCLUDING D.C. & BALT CITY)



FILE INQUIRY NOTES

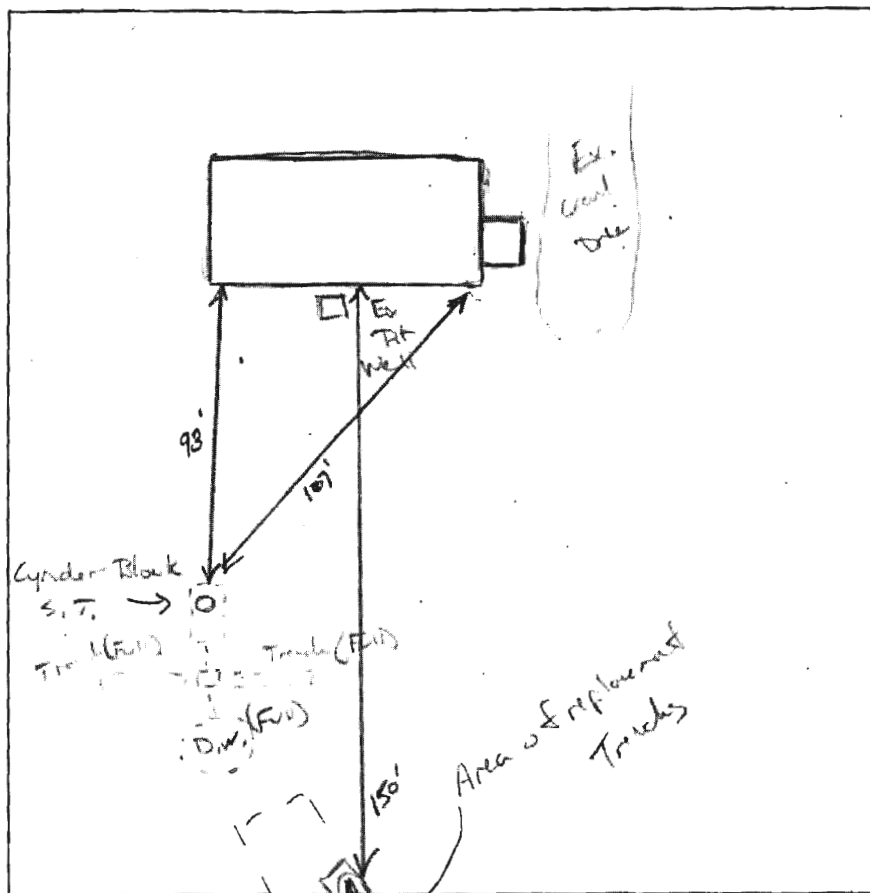

11"
2.5'
4'
7'
15'

(A)
BR WK 2500
Fricable, rock
Dry
BR/Y L
CS, Fricable
WK platy, light
100% shale, Dry
1 BR/Y SL
WBK, Fricable
massive, Dry
light.
BR/Y SL
WK platy,
20-30% shale
BR/Y/RFSL
WK platy
Highly micaceous
Dry
consistent
↓

| DATE | TEST # | DEPTH | START | BREAK 1" DROP | STOP 2" DROP | TIME OF 2ND INCH | P/F/H |
|---------|--------|-------|-------|------------------|-----------------|---------------------|-------|
| 7/23/15 | (A) | 5'15" | 00:01 | 00:07 | 00:15 | 8 | (P) |
| | | | | | | | |
| | | | | | | | |
REMARKS FSL soil below 5'. Ex SP. Black tank will need to be replaced.

SANITARIAN: K. Wolf BACKHOE: Smiley OTHERS: Helper

TEST HOLES USED IN SDA: 1 AVG. PERC TIME: 8 SQ. FT/BR: 0.8

TRENCH WIDTH: 2 INLET DEPTH: 4 MAX. BOT DEPTH: 8' EFFECTIVE S/W: 5-8'

3BR Design

$$4150 \div 0.8 = 562.5 \div 281 \cdot (.44) = 124 LF$$



HOWARD COUNTY HEALTH DEPARTMENT

56525

DATE 7/19/15

115 185

Received From Ms Geo Septic Clean PHONE # 410 745-5690

For

Plow Repair - 10360 St. Michael
Plow lot 101 18 Box

☐ CASH

☒ CHECK

NO.

50177 Twenty-six Dollars

\$ 26.10

Received By

Q. J. [Signature]