

MARYLAND DEPARTMENT OF THE ENVIRONMENT, WATER MANAGEMENT ADMINISTRATION
1800 Washington Blvd., Baltimore, Maryland 21230 (410) 537-3784

WATER WELL ABANDONMENT-SEALING REPORT FORM

SUBMIT COPIES OF COMPLETED FORM TO:

- * COUNTY ENVIRONMENT AGENCY (contact MDE, WMA if address needed)
- * WELL OWNER
- * MDE, WATER MANAGEMENT ADMINISTRATION, WELL PROGRAM

DATE WELL ABANDONED: 4/23/19 (month/day/year)

* PERMIT NUMBER OF ABANDONED WELL (if any) _____

* PERMIT NUMBER OF REPLACEMENT WELL _____

* PERSON ABANDONING WELL: Franklin Phillips


WELL DRILLERS LICENSE NUMBER: 579
CIRCLE MWD / MSD / MGD

* OWNER'S NAME: Chadha Narinder P
Rhanna Kirti

* WELL LOCATION:
COUNTY: Howard
NEAREST TOWN: Ellicott City
TAX MAP 0028 BLOCK _____ PARCEL 0050
SUBDIVISION: _____
SECTION: _____ LOT: _____
NEAREST ROAD: Hayland Farm Way

5000 wild olive?

SITE LOCATION MAP

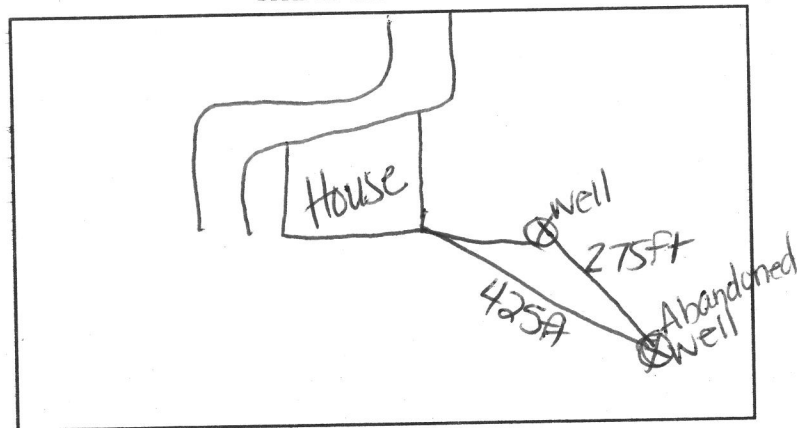

* TYPE OF WELL BEING ABANDONED:

☒ DRILLED _____ JETTED _____
_____ BORED/AUGERED _____ HAND DUG _____
_____ OTHER (specify) _____

* USE CODE:

☒ DOMESTIC _____ MUNICIPAL/PUBLIC _____
_____ IRRIGATION _____ INDUSTRIAL _____
_____ TEST/OBSERVATION _____ GEOTHERMAL _____

* TYPE OF CASING:

☒ STEEL _____ PLASTIC _____
_____ CONCRETE _____ OTHER (specify) _____

* SIZE OF CASING: 8" INCHES IN DIAMETER

* DEPTH OF WELL: 40 FEET DEEP

* WAS ANY CASING REMOVED? _____ YES ☒ NO
if yes, length removed, in feet: _____

* WAS CASING RIPPED OR PERFORATED? _____ YES ☒ NO

SIGNATURE-MASTER WELL DRILLER OR SUPERVISING SANITARIAN Franklin Phillips

LICENSE # 579 CIRCLE MWD / MSD / MGD

DATE 4/23/19

LOG OF SEALING MATERIAL

MATERIAL	FEET	
	FROM	TO
Portland Type II	40	0
VOLUME OF MATERIAL USED		
29 bags	2726 lbs	377 gals.