COMPLETE THIS FORM WHEN DROPPING OFF ANY CORRESPONDENCE AND/OR PLANS TO THE HOWARD COUNTY DEPARTMENT OF INSPECTIONS, LICENSES AND PERMITS COUNTER:

Date:	9/3/20
То:	Person's Name and Division)
From:	(Your Name, Company Name and Telephone Number)
Subject:	Project site address 7425 Haven Ct.
	Permit # B 760 7 0 2 SDP # Other information pertinent to this project
✓ Please	e check the attachments below that you are submitting with this transmittal:
	Letter of response to address plan review comment letter
	Revised plans and/or revised details: When submitting for a complete re-review, duplicate sets shall be submitted. Letter Summarizing Changes
	Energy conservation calculations
2	Copies of Ooty (be specific).
	Health Department Request DPZ/ DED Request Applicant's Request
	Two sets of single family dwelling model plans to be placed on permanent file: Model name and/or #
	Other
	Contact Person Information: (Required)
:	Please Print Name E-Mail Address:

PLEASE ASSURE ALL DOCUMENTS AND/OR REVISIONS ARE APPROPRIATELY SIGNED AND SEALED, IF NECESSARY, BY A LICENSED ARCHITECT OR ENGINEER. PLEASE BE ADVISED THAT INSUFFICIENT INFORMATION MAY RESULT IN THE DELAY OF REVIEW BY THE PLANS EXAMINER. THE DEPARTMENT OF INSPECTIONS, LICENSES AND PERMITS WILL CONTACT YOU IF THERE IS A PROBLEM. IN ADDITION, ONCE THE BUILDING PERMIT IS APPROVED BY THE PLAN REVIEW DIVISION AND ALL OTHER REQUIRED SIGNATORY AGENCIES, AND THE BUILDING PERMIT IS READY FOR ISSUANCE, THE PERMIT DIVISION WILL NOTIFY THE APPROPRIATE CONTACT PERSON FOR PERMIT PICK UP. ALL PERMIT STATUS INQUIRIES SHALL BE DIRECTED TO THE PERMIT DIVISION AT 410-313-2455. CODE RELATED QUESTIONS AND PLAN REVIEW INQUIRIES SHALL BE DIRECTED TO THE PLAN REVIEW DIVISION AT 410-313-2436. PLEASE ALLOW A MINIMUM OF FIVE (5) WORKING DAYS FOR ANY PLAN SUBMITTALS TO BE REVIEWED. THANK YOU.

RECEIVED

SEP 03 2020

White-Plan Review / Yellow-Applicant / Pink-Permit Division ENSES & PERMITS t:\Operations\Updated forms\transmit.frm - Rev. 04/2014

restruda

NON-BUILDABLE PRESERVATION PARCEL B

32.42

CONTROL

PANEL

CLEANOUTS

R+C SET

PREPARED FOR: WILLIAMSBURG GROUP, LLC 5485 HAPERS FARM RD SUITE 200 COLUMBIA, MD 21044 RODGER HENRITZ (410) 997-8800

For Gutschick, Little and Weber, P.A.: Thomas C. O'Connor, Jr., Professional Land Surveyor, No. 10954 (EXP. DATE: 07/03/2022)

THIS BOUNDARY SURVEY WHICH INCLUDES A LOCATION DRAWING IS VALID ONLY WITH AN ORIGINAL SIGNATURE AND EMBOSSED SEAL OF THE ABOVE SURVEYOR.

6/15 ToLC

SURVEYOR'S CERTIFICATE THIS IS TO CERTIFY TO:

"WILLIAMSBURG GROUP, LLC',

THAT TO THE BEST OF MY KNOWLEDGE, INFORMATION AND BELIEF, THIS BOUNDARY SURVEY WHICH INCLUDES A LOCATION DRAWING WAS PREPARED

ID' PUBLIC DRAINAGE, STREET TREE, & UTILITY EASEMENT

R+C SET

LOT

S 17'34'53" E

X-MARK SET ON BIG ROCK

-R+C SET

REVISED

Date: 9-2-20

Comments:

-S 2775'52" E


55.69

30.87

CLEANOUT (

THIS BOUNDARY SURVEY WHICH INCLUDES A LOCATION DRAWING WAS PREPARED WITHOUT THE BEHEFIT OF A CURRENT TITLE REPORT. THIS PROPERTY IS SUBJECT TO ANY AND ALL EASEMENTS, RIGHTS-OF-WAY, COVENANTS, AND RESTRICTIONS, ETC. OF RECORD, SOME OR ALL OF

ALL IP+C (IRON PIPE & CAP) AND R+C (REBAR & CAP) SET ARE TOPPED WITH A YELLOW CAP READING "PROPMARK LS 163"

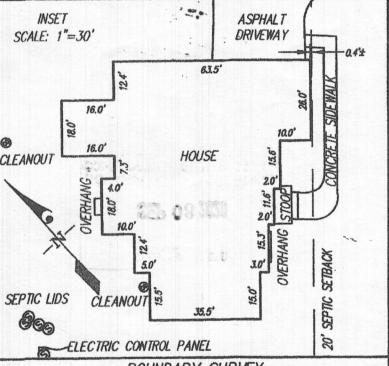

BOUNDARY SURVEY (WHICH INCLUDES A LOCATION DRAWING)

ESTATES AT SCHOOLEY MILL

LOT 6 7425 HAVEN COURT

HOWARD COUNTY, MARYLAND

DATE OF LATEST FIELD WORK: 6/19/2020

G.L.W. FILE No.

REFERENCE: PLAT No.: 24583

SCALE: 1"=50"

17-06

OGLW 2018

WHICH MAY OR MAY NOT BE SHOWN AND/OR REFERENCED HEREON. THE LICENSEE BELOW WAS IN RESPONSIBLE CHARGE OVER THE PREPARATION OF THIS BOUNDARY SURVEY WHICH INCLUDES A LOCATION DRAWING AND THE SURVEYING WORK REFLECTED IN IT, ALL IN COMPLIANCE WITH REQUIREMENTS SET FORTH IN COMAR TITLE 09, SUBTITLE 13, CHAPTER 06, REGULATION .12. THE PROPERTY SHOWN HEREON LIES WITHIN ZONE X (AREAS DETERMINED TO BE OUTSIDE THE 0.28 ANNUAL CHANCE FLOODPLAIN) AS SHOWN ON THE F.E.M.A. FLOOD INSURANCE RATE MAP, MAP NO. 24027C0140D, EFFECTIVE DATE NOVEMBER 6, 2013. BUILDING SETBACKS (BRL's) SHOWN HEREON PER PLAT No. 24583.
WELL & SEPTIC SETBACK'S (BRL's) SHOWN HERON PER PLOT PLAN.
SETBACK DISTANCES SHOWN HEREON ARE TO THE OUTERMOST FACE OF THE FOUNDATION WALLS
AND HAVE AN ACCURACY OF ± 1 FOOT.

CLEANOUT