**Bureau of Environmental Health**

8930 Stanford Boulevard, Columbia, MD 21045

Main: 410-313-2640 | Fax: 410-313-2648

TDD 410-313-2323 | Toll Free 1-866-313-6300

www.hchealth.org

Facebook: www.facebook.com/hocohealth

Twitter: HowardCoHealthDep

Maura J. Rossman, M.D., Health Officer**APPLICATION****FOR PERCOLATION TESTING AND SITE EVALUATION****PROPERTY LOCATION**SUBDIVISION/PROPERTY NAME Morgan + Matt WesselPROPERTY ADDRESS 14070 Stearns Valley Ct Glenwood 21238
STREET TOWN ZIPTAX ACCOUNT # _____ TAX MAP _____ GRID _____ PARCEL _____ LOT NO. _____ PROPOSED LOT
SIZE (ACRES) _____

ZONING CATEGORY _____ TIER _____

PROPERTY OWNER(S) Morgan + Matt WesselDAYTIME PHONE 301-366-9040 CELL _____ EMAIL _____MAILING ADDRESS _____ 21238
STREET CITY, STATE ZIPAPPLICANT South Carol Backhoe RELATIONSHIP TO OWNER: _____DAYTIME PHONE _____ CELL 410-596-3118 EMAIL _____MAILING ADDRESS 44105 Columbia Rd Westminster 21157
STREET CITY, STATE ZIP**I HEREBY APPLY FOR THE NECESSARY TESTING/EVALUATION PRIOR TO ISSUANCE OF SEWAGE DISPOSAL SYSTEM PERMIT(S):****PROPERTY:**

- ☐ SUBDIVISION: NUMBER OF LOTS INCLUDING RESIDUE: _____
SUBDIVISION CLASSIFICATION (PER DEPT. OF PLANNING AND ZONING) ☐ MAJOR ☐ MINOR
- ☐ CONSTRUCT NEW OSDS ON UNDEVELOPED LOT
- ☐ REPAIR OR REPLACE FAILING OSDS
- ☐ UPGRADE EXISTING OSDS

BUILDING:

- ☐ RESIDENTIAL WITH _____ EXISTING OR PROPOSED BEDROOMS IN THE COMPLETED STRUCTURE
- ☐ COMMERCIAL (PROVIDE DETAIL OF TYPE OF USE AND NUMBERS OF EMPLOYEES/CUSTOMERS ON ACCOMPANYING PLAN)

IS THE PROPERTY WITHIN 2500 FEET OF ANY RESERVOIR?

- ☐ YES
- ☐ NO

AS APPLICANT, I UNDERSTAND THE FOLLOWING:

- THIS APPLICATION IS VALID FOR TWO(2) YEARS FROM DATE OF FEE PAYMENT AND APPROVAL IS BASED UPON HEALTH OFFICER SIGNATURE OF A PERC CERTIFICATION PLAN PRIOR TO EXPIRATION OF THIS PERMIT.
- THE APPLICATION FEE IS NON-REFUNDABLE
- THIS APPLICATION MUST BE ACCOMPANIED BY ALL APPLICABLE FEES AND A SUITABLE SITE PLAN IN ORDER TO BE PROCESSED
- THIS IS A PUBLIC DOCUMENT

I declare and affirm that to the best of my knowledge, the information contained herein is correct. I declare that I am the owner of the property or duly authorized to make this application on behalf of the owner. I agree to comply with all applicable state and county regulations.

By signature of this application, I hereby grant Howard County Health Department officials the right to enter onto the property for the purpose of inspecting the property as directly related to the requested permit/service.

Kenneth J. Schmitt

SIGNATURE OF APPLICANT

9-18-18


DATE

Stevens Valley, CA

A/P

- 0' (A)
dk brn loam
mslk
roots
1.5' lt brn sct
mslk
roots
3' brn sct
few mica
roots
4' red brn vfst
many mica
lgs rock
roots
consistent
↓
Min deposits
Moist @
bottom
14'

Gravel Dr.

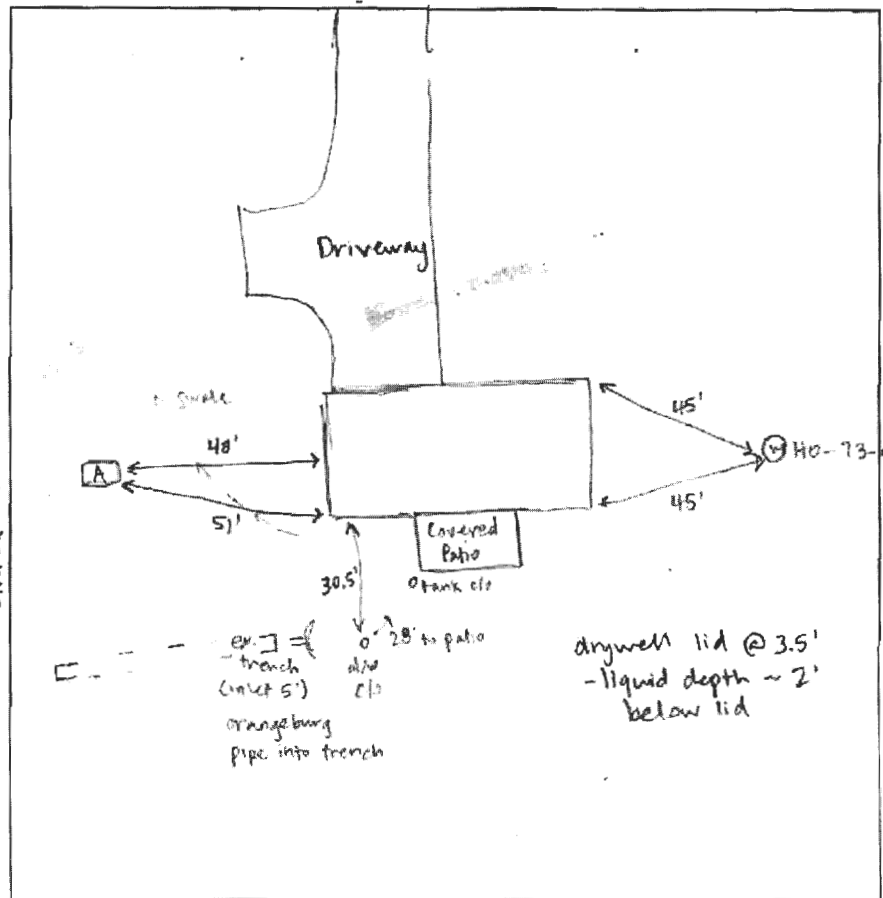

DATE	TEST #	DEPTH	START	BREAK 1" DROP	STOP 2" DROP	TIME OF 2ND INCH	P/F/H
11/13/18	A	6' / 14'	0:00	7:20	19:15	11:55	P

REMARKS Swale cut into yard in 2015 by previous homeowner (for basement flooding)
 SANITARIAN Sarah Collins BACKHOE Ken Schissler OTHERS Dave (helper) + Matt West
 TEST HOLES USED IN SDA A AVG. PERC TIME 12 min/SQ. FT/BR 4 BR
 TRENCH WIDTH 2' INLET DEPTH 5' MAX. BOT DEPTH 10' EFFECTIVE SW @ 4'



