

11/20/02 10AM

PUB. SEWER STATUS VERIFIED BY

NA

ISSUE DATE: 11/8/02

PERMIT

P 517992-A

APPROVAL DATE: 11/20/02

A REPAIR A03198

ON-SITE SEWAGE DISPOSAL SYSTEM HOWARD COUNTY HEALTH DEPARTMENT BUREAU OF ENVIRONMENTAL HEALTH

03-297446

Fogles Septic Clean, Inc

IS PERMITTED TO INSTALL ☐ ALTER ☒

ADDRESS: 580 Obrecht Road, Sykesville

PHONE NUMBER: 410-795-5670

SUBDIVISION: River Park Estates

LOT NUMBER: 5

ADDRESS: 1121 River Road

PROPERTY OWNER: Craig Vaselaros

SEPTIC TANK CAPACITY (GALLONS):

existing 1000 g?

PUMP CHAMBER CAPACITY (GALLONS):

NA

NUMBER OF BEDROOMS:

3

SQUARE FEET PER BEDROOM:

$180 \times 3 = 540 \div 2 = 270 \times .24 = 64.8'$

LINEAR FEET OF TRENCH REQUIRED:

65±

TRENCHES:	Trench to be 2 feet wide. Inlet 3 feet below original grade. Bottom maximum depth 10 feet below original grade. Effective area begins at 3-4 feet below original grade. 7 feet of stone below distribution pipe.
LOCATION:	
PURPOSE:	Existing septic system has failed. Call for inspection when ground is opened so sanitarian can recommend repair.

PLANS APPROVED:

Steven R. Krieg

DATE:

11/20/02

NOTE: PERMIT VOID AFTER 2 YEARS

NOTE: CONTRACTOR RESPONSIBLE FOR SCHEDULING A PRE-CONSTRUCTION INSPECTION FOR ALL INSTALLATIONS

NOTE: WATERTIGHT SEPTIC TANKS REQUIRED

NOTE: ALL PARTS OF SEPTIC SYSTEM SHALL BE 100 FEET FROM ANY WATER WELL


NOTE: MANHOLE RISERS REQUIRED ON ALL SEPTIC TANKS AND PUMP CHAMBERS

NEITHER THE HOWARD COUNTY COUNCIL NOR THE HEALTH DEPARTMENT IS
RESPONSIBLE FOR THE SUCCESSFUL OPERATION OF ANY SYSTEM
PERMITTEE RESPONSIBLE FOR OBTAINING FINAL APPROVAL ON THIS PERMIT
CALL 410-313-2640 FOR INSPECTION OF SEPTIC SYSTEM

P517992-A

NOT TO SCALE

INDEX

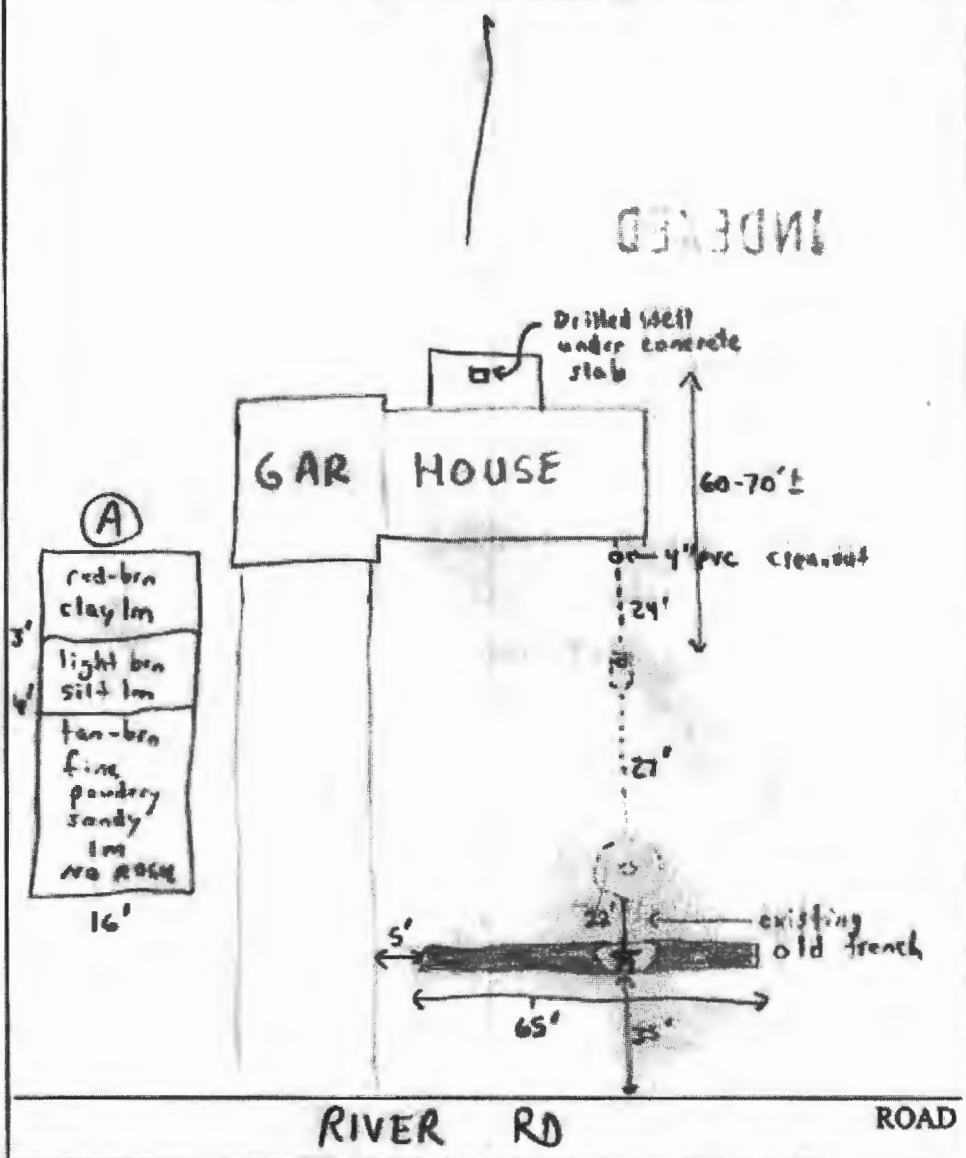

TRENCH/DRAINFIELD DATA		
WIDTH	INLET	BOTTOM
2	3-4	10
NUMBER OF TRENCHES		
1		
TOTAL LENGTH		
65		
ABSORPTION AREA		
4554		
DISTRIBUTION BOX LEVEL		
NA		
DISTRIBUTION BOX BAFFLE		
NA		
DISTRIBUTION BOX PORT		
NA		

SEPTIC TANK DATA	
SEPTIC TANK 1 LEVEL	existing
CAPACITY	1000? GAL
SEAM LOC	Midseam?
TANK LID DEPTH	?
BAFFLES	OK
BAFFLE FILTER	NA
MANHOLE LOC	NA
6" PORT LOC	lid on front
WATERTIGHT TEST	NA
SEPTIC TANK 2 LEVEL	NA
CAPACITY	_____ GAL
SEAM LOC	_____
TANK LID DEPTH	_____
BAFFLES	_____
BAFFLE FILTER	_____
MANHOLE LOC	_____
6" PORT LOC	_____
WATERTIGHT TEST	_____


PRE-CONSTRUCTION 11/20/02 - MET CONTRACTOR (KENNY MAYNE) DUG PERC HOLE
 IN LOCATION (A) INSTALL AS DISCUSSED. A DRILLED WELL WAS OBSERVED
 INSTALLATION - 7100' SLIGHTLY DOWNSLOPE OF PROPOSED SEPTIC BUT NOT
 IN DIRECT DRAINAGE PATH OK (FA/SRK)
 INSTALLATION - 11/20/02 - OK TO COVER ALL WORK - (SRK)

FINAL INSPECTOR

Steven R. King


DATE OF APPROVAL

11/20/02

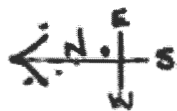

Scale: 1" = 50'

Neighbor
1127
River Rd

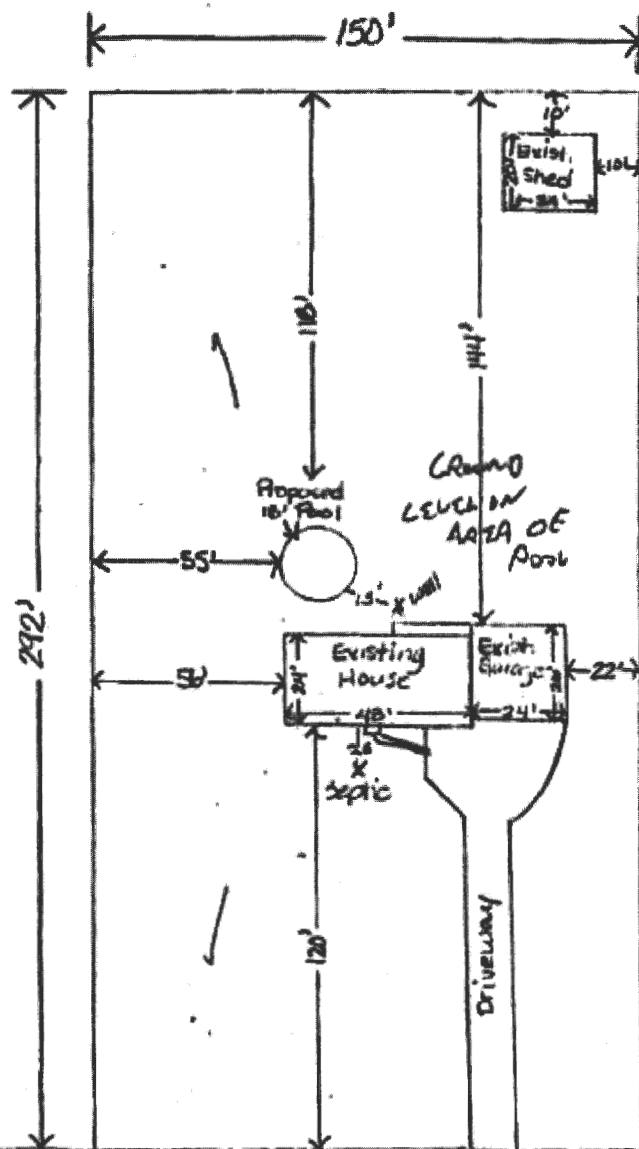

- Dimension of Property: 150' x 292'
- Distance from front of Pool to front property line = 102'
- Distance from center of front street to pool = 102'
- Distance from well to pool = 18'
- Distance from house to well = 15'
- Distance from corner of lot to nearest state road = 105.6'

- 3RD Election District
- Property zoned residential
- No access to public water or sewer

6/29/17

ONE SEPTIC CLEANOUT IS UNDER YARD ORNAMENT IN FRONT OF HOUSE

WELL IS CLOSER - OWNER SAYS NO PIT, 1' FROM HOUSE, 7' FROM PORCH

PROPOSED POOL IS NO CLOSER TO WELL THAN EXISTING HOUSE SCORRATH OK TO ACCESS

River Rd.

1127 River Rd.
Lot 4
River Park Estates
Lot 4, Parcel 97, Sect I

State Road 32