

DEPT. OF INSPECTIONS, LICENSES AND PERMITS
3430 COURT HOUSE DRIVE
ELLCOTT CITY, MD 21043
PERMITS (410) 313-2455
INSPECTIONS (410) 313-1810
AUTOMATED INFORMATION (410) 313-3800

HOWARD COUNTY
PERMIT APPLICATION

B0902559
PERMIT NUMBER

Building Address 1970 Sand Hill Road

Suite/Apt. #: SDP/WP/Petition #:

Census Tract Subdivision

Section Area Lot

Tax Map Parcel Grid

Zoning Map Coordinates Lot Size

Existing Use SFD

Proposed Use

Estimated Construction Cost \$ 18000

Description of Work Wind Turbine
54' High

Occupant or Tenant

Contact Name

Address

City State Zip Code

Phone Fax

Property Owner's Name Laura Warfield

Address 1970 Sand Hill Road

City MD State MD Zip Code 21044

Home Phone 410-442-5505 Work Phone

Applicant's Name & Mailing Address, (if other than stated herein):

Phone Fax

Contractor Company Pioneer Home Solutions

Contact Person C. A. McGinn

Address 2915 Potomac Road

City MD State MD Zip Code 20771

License No. 93508

Phone 301-775-2099 Fax 301-529-9821

Engineer or Architect Company

Contact Person

Address

City State Zip Code

Phone Fax

BUILDING DESCRIPTION - COMMERCIAL

Building Characteristics

Utilities

Height: Water Supply: Public Private
No. of stories: Sewage Disposal: Public Private
Gross area, sq. ft. per floor: Electric Yes No Gas Yes No
Use group: Heating System: Electric Oil Natural Gas Propane Gas
Construction type: Reinforced Concrete Masonry Wood Frame State Certified Modular
Sprinkler system: N/A Full Partial Other Suppression # of Heads

BUILDING DESCRIPTION - RESIDENTIAL

Building Characteristics

Utilities

SF Dwelling SF Townhouse
Depth Width
1st floor: 2nd floor: Basement:
Finished Basement Unfinished Basement Crawl space Slab on Grade
No. of Bedrooms
Multi-family dwellings:
No. of efficiency units: No. of 1 BR units: No. of 2 BR units: No. of 3 BR units:
Other Structure: Dimensions: Footings: Roof:
State Certified Modular Manufactured Home
Water Supply: Public Private
Sewage Disposal: Public Private
Electric Yes No Gas Yes No
Heating System: Electric Oil Natural Gas Propane Gas
Sprinkler system: N/A NFPA #13D NFPA #13R Other:

THE UNDERSIGNED HEREBY CERTIFIES AND AGREES AS FOLLOWS: (1) THAT HE/SHE IS AUTHORIZED TO MAKE THIS APPLICATION; (2) THAT THE INFORMATION IS CORRECT; (3) THAT HE/SHE WILL COMPLY WITH ALL REGULATIONS OF HOWARD COUNTY WHICH ARE APPLICABLE THERETO; (4) THAT HE/SHE WILL PERFORM NO WORK ON THE ABOVE REFERENCED PROPERTY NOT SPECIFICALLY DESCRIBED IN THIS APPLICATION; (5) THAT HE/SHE GRANTS COUNTY OFFICIALS THE RIGHT TO ENTER ONTO THIS PROPERTY FOR THE PURPOSE OF INSPECTING THE WORK PERMITTED AND POSTING NOTICES.

Applicant's Signature C. A. McGinn

Print Name C. A. McGinn

Title/Company Project Manager

Date 9/19/09

Checks payable to: DIRECTOR OF FINANCE OF HOWARD COUNTY
PLEASE WRITE NEATLY AND LEGIBLY.

AGENCY DATE SIGNATURE APPROVAL

Land Development, DPZ

State Highways

Building Officials

Dev. Engineering, DPZ

Health 10/8/2009 RBucher

Fire Protection

Is Sediment Control approval required prior to issuance?
YES NO

DPZ SETBACK INFORMATION

Front: Rear: Side: Side St: All minimum setbacks met?
YES NO
Is Entrance Permit Required?
YES NO
Historic District?
YES NO
Lot Coverage for New Town Zone
SDP/Red-line approval date

Filing fee \$

Permit fee \$

Excise tax \$

Add'l per fee \$

TOTAL FEES \$

Sub-total paid \$

Balance due \$

Check #


Validation #

Accepted by

CONTINGENCY CONSTRUCTION START: ONE STOP SHOP:

Distribution of Copies: White: Building Officials Green: LDD, DPZ Yellow: DED, DPZ Pink: Health Gold: SHA
T:\Operations\Updated forms

Health

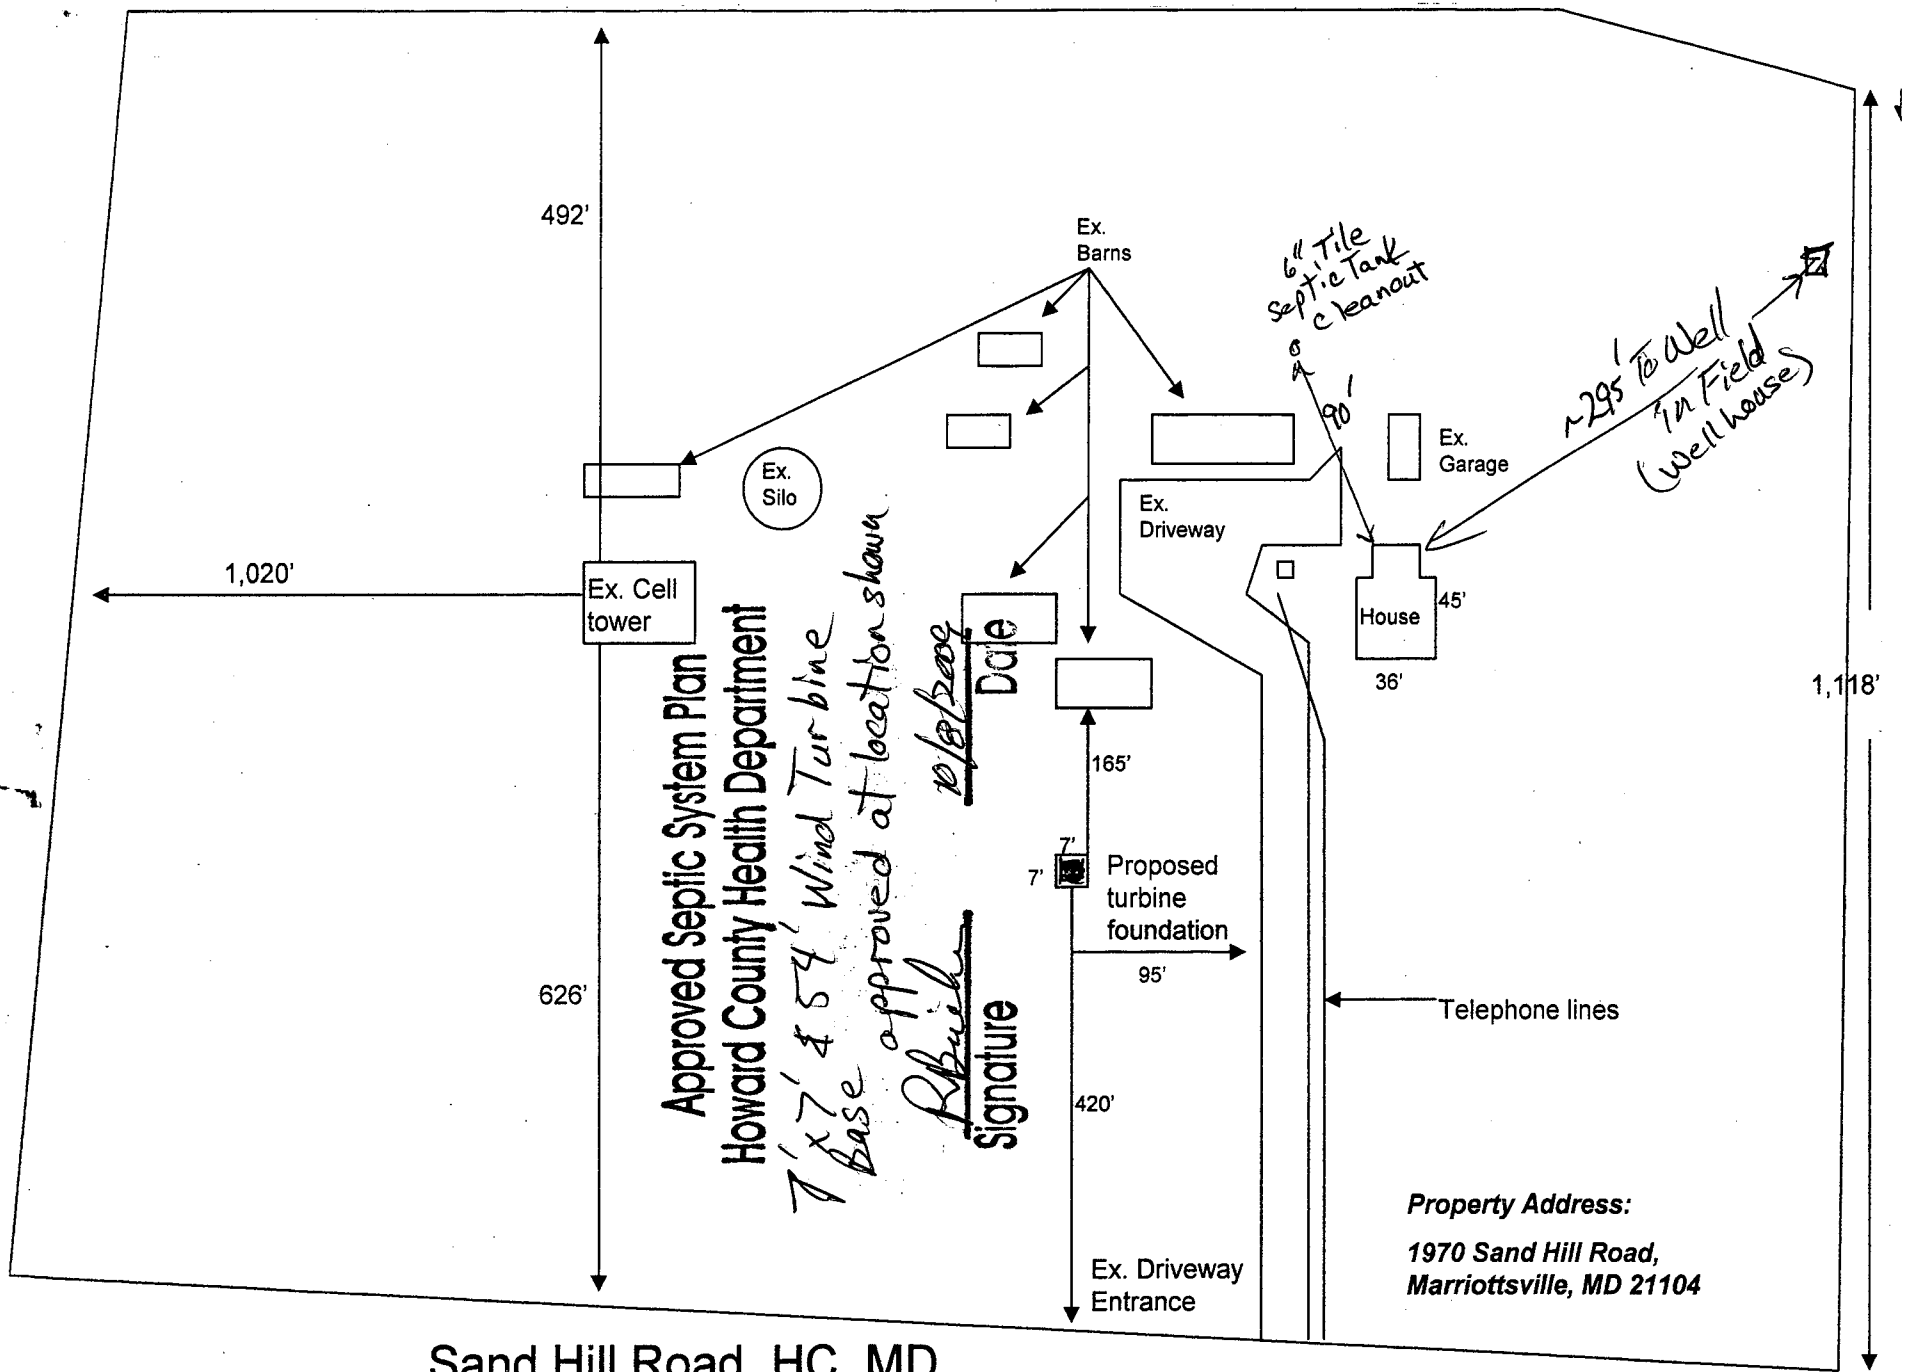

Approved Septic System Plan
Howard County Health Department
7' x 7' & 54' Wind Turbine
Base approved at location shown

R. B. Buehler
Signature
Date

Property Address:
1970 Sand Hill Road,
Marriottsville, MD 21104

Sand Hill Road, HC, MD


1855'

B09002534

SITE INSPECTION SHEET

OWNER: Laura Warfield PHONE #: 410-442-5505
 ADDRESS: 1970 Sand Hill Rd CONTRACTOR: _____
Marriottsville 21104 WELL TAG #: HO-21-0621
 SUBDIVISION: _____ LOT: _____ COUNTY #: Howard
 PROPOSAL: Install concrete base for Wind Turbine
BO9002534

LOCATION DIAGRAM

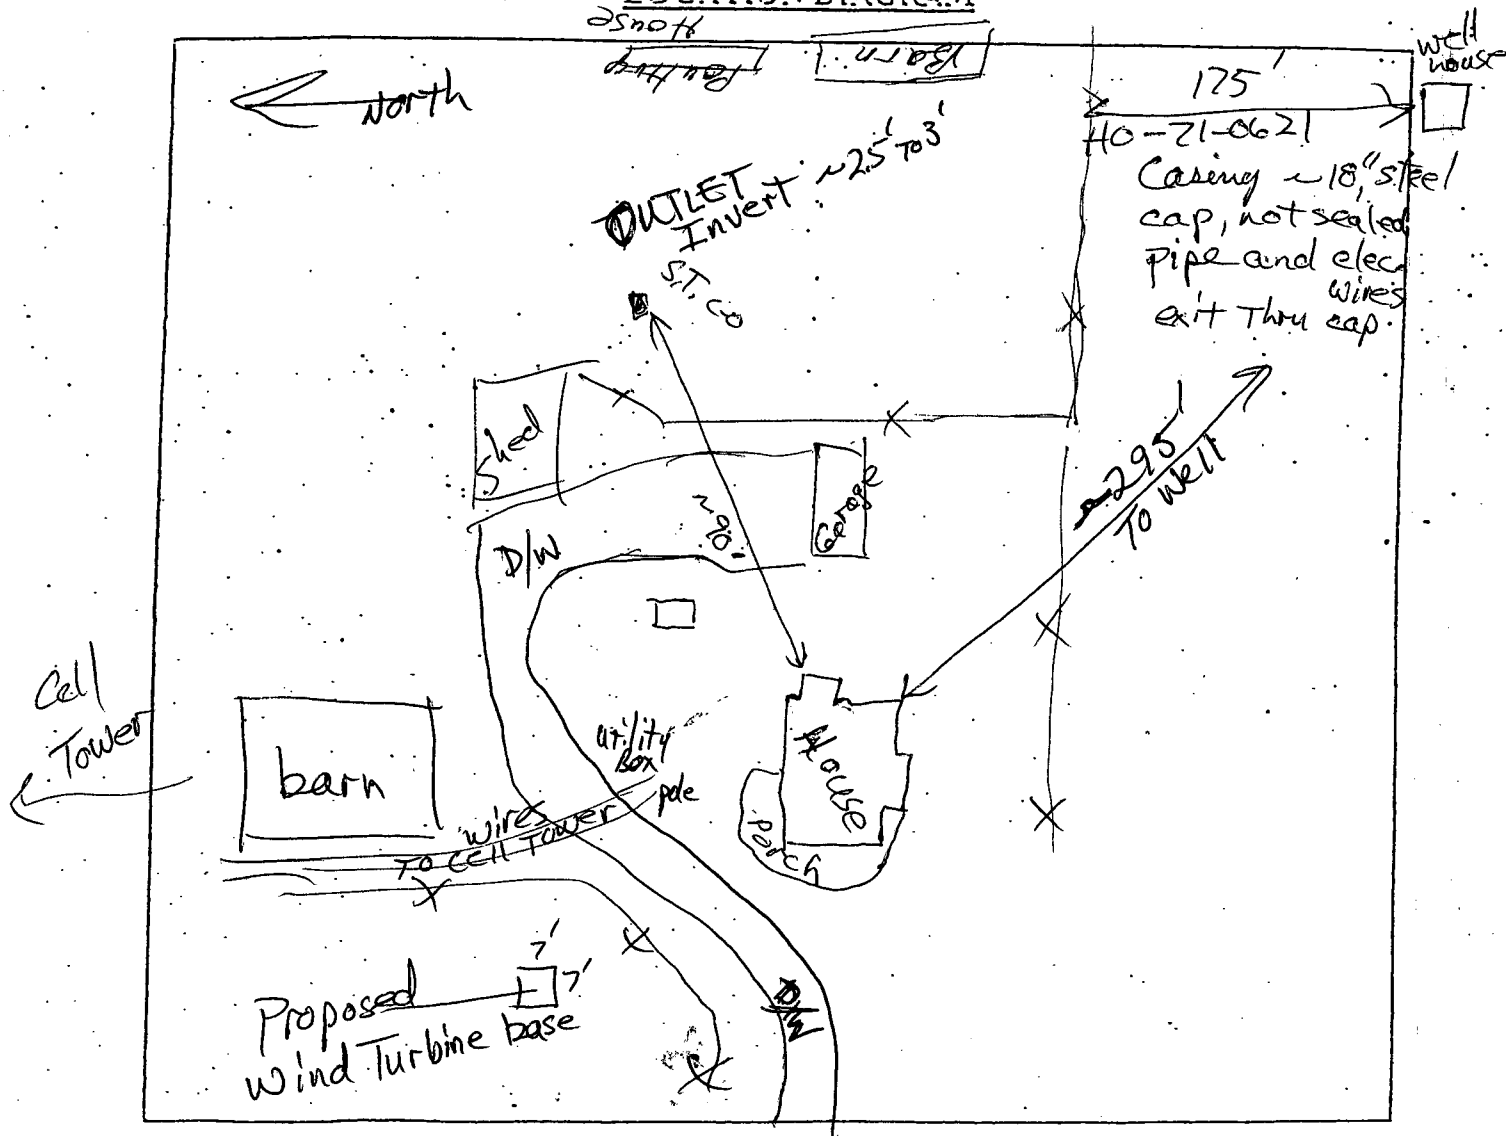

COMMENTS: See Well description. No records found for property. (Shown on HoCo GIS as 2115*)
Oct 8, 2009

RB 10/8/2009

Septic system distribution not observed.
 Septic Tank in pasture; no indicators of failure observed.