

PERMIT

SEWAGE DISPOSAL SYSTEM

MARYLAND STATE DEPARTMENT OF HEALTH

HOWARD COUNTY
BUREAU OF ENVIRONMENTAL HEALTH
992-2330

INDEXED

ELLICOTT CITY

DISTRICT

DATE 4/19/85

PURPOSE FIX OVERFLOWING

Carroll County Septic Tank Service

IS PERMITTED TO INSTALL

ALTER X

ADDRESS 10150 Route 99, Ellicott City, MD 21043

PHONE 461-9282

SUBDIVISION ROAD 1995 Sand Hill Road LOT

PROPERTY OWNER Mr. & Mrs. Grace PHONE: 442-1514

ADDRESS 1995 Sand Hill Road
Marriottsville, Maryland 21104

IF GARBAGE GRINDER IS USED INCREASE SEPTIC TANK CAPACITY BY 50% AND ABSORPTION AREA BY 22%.

GARBAGE GRINDER? YES NO X

SEPTIC TANK CAPACITY GALLONS NUMBER OF BEDROOMS 2

REPAIR - CALL FOR INSPECTION WHEN GROUND IS OPENED UP SO SANITARIAN CAN RECOMMEND REPAIR.

DEEP TRENCH 9-10 FT DEEP 2 FT WIDE
60 FT LONG INLET 3 FT
DEEP RUN TRENCH OFF
OLD DRY WELL TOWARD
SIDE LINE FENCE ON LEFT
SIDE OF THE LOT AS SEEN
FROM SAND HILL RD

PLANS APPROVED BY Craig Williams DATE 4/15/85

COVER NO WORK UNTIL INSPECTED AND APPROVED.

NEITHER THE HOWARD COUNTY COUNCIL NOR THE HEALTH DEPARTMENT IS RESPONSIBLE FOR THE SUCCESSFUL OPERATION OF ANY SYSTEM.

NOTE: IF TRENCH IS USED CALL FOR INSPECTION BEFORE AND AFTER PLACING GRAVEL IN TRENCH.

NOTE: NO DRY WELL SHALL EXCEED 15 FOOT IN DIAMETER. NO ABSORPTION TRENCH TO EXCEED 100 FEET IN LENGTH.

NOTE: ALL PIPE FROM HOUSE TO SEPTIC TANK MUST BE CAST IRON OR SCHEDULE 40 PVC OR ABS.

PERMIT VOID AFTER THREE YEARS.

NOTE: INSTALL STAND PIPE ON SEPTIC TANK AND DRY WELL. STAND PIPES MUST BE 6 INCHES IN DIAMETER. CAST IRON, CONCRETE OR TERRA COTTA, OR PVC OR ABS ACCEPTED. IF TOP OF SEPTIC TANK IS DEEPER THAN 3 FEET MANHOLE TO GRADE REQUIRED.

*INSTALLER IS RESPONSIBLE FOR OBTAINING FINAL APPROVAL ON THIS PERMIT


*CALL 992-2330 FOR INSPECTION OF SEPTIC SYSTEMS.

EH-2-1082

ADD. TO
BLDG. PERMIT SIGNED
AND RETURNED 5-21-96
Serial # 65054

35323

①
TOP
SOIL
& CLAY
BROWN
SAND
LOAM
& MILK

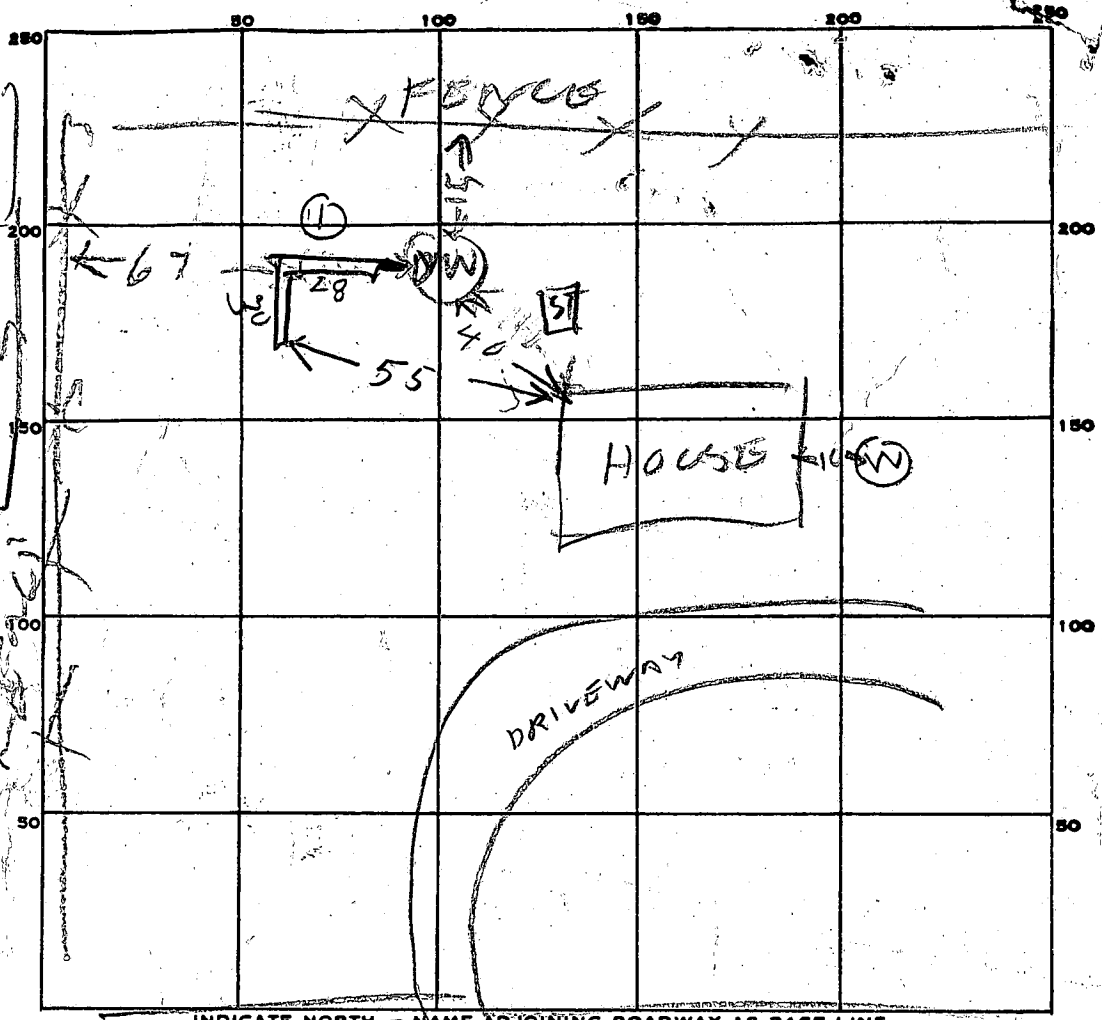

INDICATE NORTH. - NAME ADJOINING ROADWAY AS BASE LINE.

PERMIT CARD YES SAND HILL RD

SEPTIC TANK, LEVEL _____ CLEANOUTS _____

DISTRIBUTION BOX, LEVEL _____

TILE FIELD, DEPTH 1'0 FT. TRENCH WIDTH 2-5 FT.

GRAVEL DEPTH 6 1/2 IN. TOTAL LENGTH 58 FT.

NUMBER OF TRENCHES 1 TOTAL BOTTOM AREA 377 ^{ONE SIDE}

SEEPAGE PITS, INSIDE DIAMETER _____ FT. DEPTH BELOW INLET _____ FT.

ABSORBENT AREA _____ SQ. FT.

REMARKS 4/17/85 VISUAL HOLE OK 50
50
34290

4/17/85 HOLE DUG ABOUT 30 FT LONG BUT 377

CAVED IN

4/19/85 - HOME OWNER MEASURED DEPTH TRENCH

OK

DATE SYSTEM APPROVED 4/19/85 INSPECTOR Raymond Hodges

4/10/85

I have inspected the
trench to be 10'
deep from end to
end -

Rich Buckner