

APPLICATION

A26000

SEWAGE DISPOSAL TESTING

P _____

STATE OF MARYLAND - DEPARTMENT OF HEALTH AND MENTAL HYGIENE

HOWARD COUNTY HEALTH DEPARTMENT
ENVIRONMENTAL HEALTH SERVICES

DISTRICT 3rd

P. O. BOX 476, ELLICOTT CITY, MARYLAND 21043
TELEPHONE: 465-5000, EXT. 356

DATE 6-3-77

TO: THE COUNTY HEALTH OFFICER
ELLICOTT CITY, MARYLAND

I, HEREBY, APPLY FOR THE NECESSARY TEST IN ORDER TO CONSTRUCT (OR RECONSTRUCT) A SEWAGE DISPOSAL SYSTEM.

PROPERTY OWNER SAND HILL JOINT VENTURE

ADDRESS 51 MONROE STREET, ROCKVILLE, MD PHONE 424-5103

PROPERTY LOCATION:

SUBDIVISION SAND HILL ACRES LOT NO. 2 Now 8 Mon

ROAD AND DESCRIPTION LAMPLIGHTERS DRIVE, SECTION III

SIZE OF LOT 3.8 ACRES TYPE BLDG. 4
NUMBER OF BEDROOMS

IF NOT SINGLE RESIDENCE DESCRIBE _____

THE SYSTEM INSTALLED UNDER THIS APPLICATION IS ACCEPTABLE ONLY UNTIL PUBLIC FACILITIES BECOME AVAILABLE.

SIGNATURE OF APPLICANT Martin F. Lynett

APPROVED BY _____ FOR _____ DATE _____
(KIND OF SYSTEM)

REJECTED BY _____ FOR _____ DATE _____
(KIND OF SYSTEM)


HOLD PENDING FURTHER TESTS 2704 - Needs 2 4 1/2 holes DATE 6/8/77

REASONS FOR REJECTION OR HOLDING 5/11/79 (H) 1 hole dug - shallow - no

(Test holes ready) C.B.D. Recommended dig low
hole out. due to previous water problem of D.T.O. Hill. C.B.D.

Nonbuildable

THIS IS NOT A PERMIT

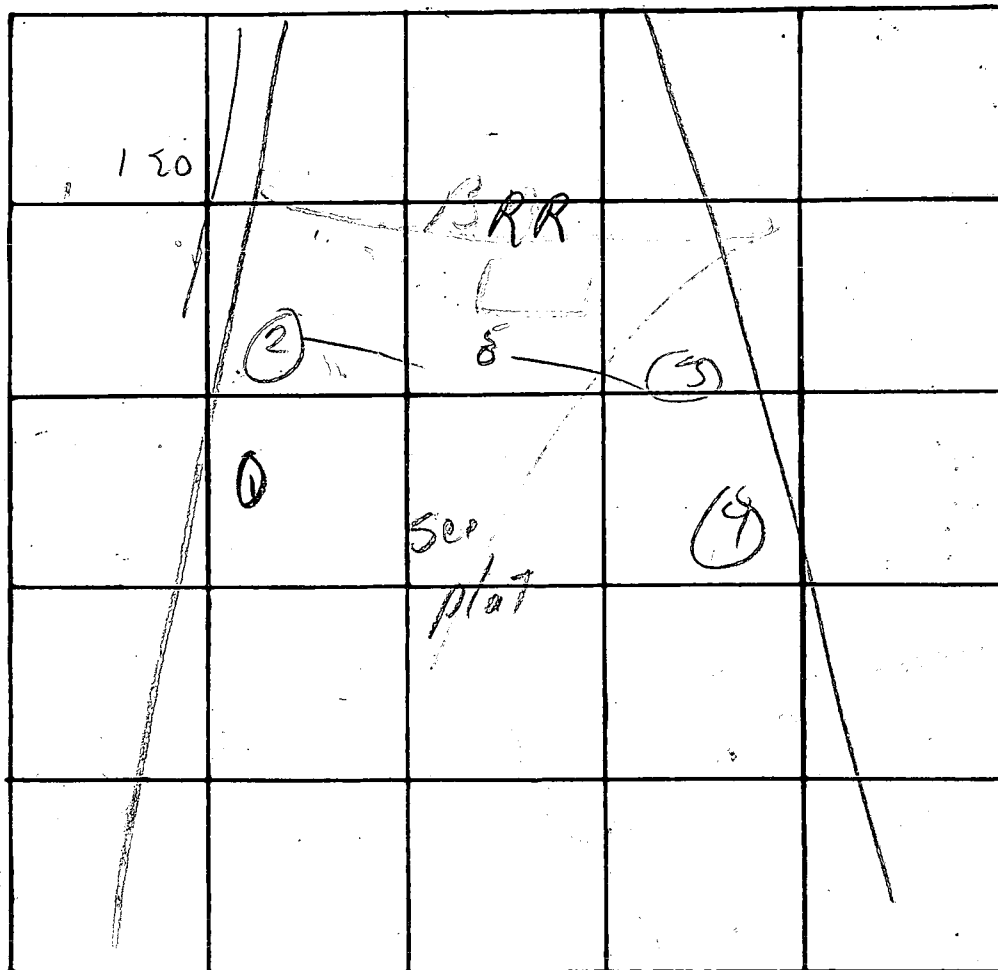

INDICATE NORTH. - NAME ADJOINING ROADWAY AS BASE LINE.

DATE	TEST NO.	DEPTH	PRE-WET		TEST - 1" DROP		TIME
			START	STOP	START	STOP	
6/8/44	1 55	2'	3 29	3 35	3 35	3 50	15
	2	9	3 30	3 55	3 35	3 48	13
		11'	WATER				
	4 5	2	4 01	4 04	4 04	4 09	5
	d	9	4 02	4 12	4 12	4 28	16
7/15/44	2	10'	10 09	10 12	10 12	10 17	7
		4'	10 16	10 23	10 23	10 42	19
	3	2'	10 42	10 55	10 55	11 23	28
		9'	10 45	- (out in)			
		11'	11 48	11 51	11	USE	22 min.

soil
OK 11'

dog
to
11'

REMARKS #5 Used pool 3-11'

TYPE OF SOIL

TESTED BY

ALSO PRESENT: