

APPLICATION

PERCOLATION TESTING

HOWARD COUNTY HEALTH DEPARTMENT
BUREAU OF ENVIRONMENTAL HEALTH
P.O. BOX 476 ELLICOTT CITY, MARYLAND, 21043
TELEPHONE 461-9933

A 40941

P _____

DISTRICT 4

DATE 1-29-88

TO: THE COUNTY HEALTH OFFICER
ELLICOTT CITY, MARYLAND

I, HEREBY, APPLY FOR THE NECESSARY TEST IN ORDER TO CONSTRUCT (OR RECONSTRUCT) A SEWAGE DISPOSAL SYSTEM.

PROPERTY OWNER Hilltop Development Corp Trinity Builders
ADDRESS P.O. Box 208 CLARKSVILLE Md 21024 PHONE 410-313-8222
531-5539

PROSPECTIVE BUYER _____

ADDRESS _____ PHONE _____

PROPERTY LOCATION:

SUBDIVISION SAND HILL ACRES LOT NO. 8/10
ROAD AND DESCRIPTION 2435 SAND HILL ROAD & LAMPLIGHTERS DRIVE

TAX MAP 16 PARCEL # 5

SIZE OF LOT 3 Acres TYPE BLDG Single Family
(SINGLE FAMILY DWELLING OR COMMERCIAL)

THE SYSTEM INSTALLED UNDER THIS APPLICATION IS ACCEPTABLE ONLY UNTIL PUBLIC FACILITIES BECOME AVAILABLE. I FULLY UNDERSTAND THE

FEE CONNECTED WITH THE FILING OF THIS PERC TEST APPLICATION IS NON-REFUNDABLE UNDER ANY CIRCUMSTANCES. I ALSO AGREE TO COMPLY

WITH ALL M.O.S.H.A. REQUIREMENTS IN TESTING THIS LOT. Richard J. Demmitt
(SIGNATURE OF APPLICANT)

APPROVED BY _____ FOR _____ DATE _____

REJECTED BY _____ FOR _____ DATE _____

HOLD PENDING FURTHER TESTS _____ DATE _____

REASONS FOR REJECTION OR HOLDING: _____

BLDG. PERMIT SIGNED
AND RETURNED 6/13/94
Serial # 54627
SFD



BLDG. PERMIT SIGNED
AND RETURNED 9/12/89
Serial # 27118-SFD
3 Bedrooms

THIS IS NOT A PERMIT

A4094H


#1

SOIL PROFILE

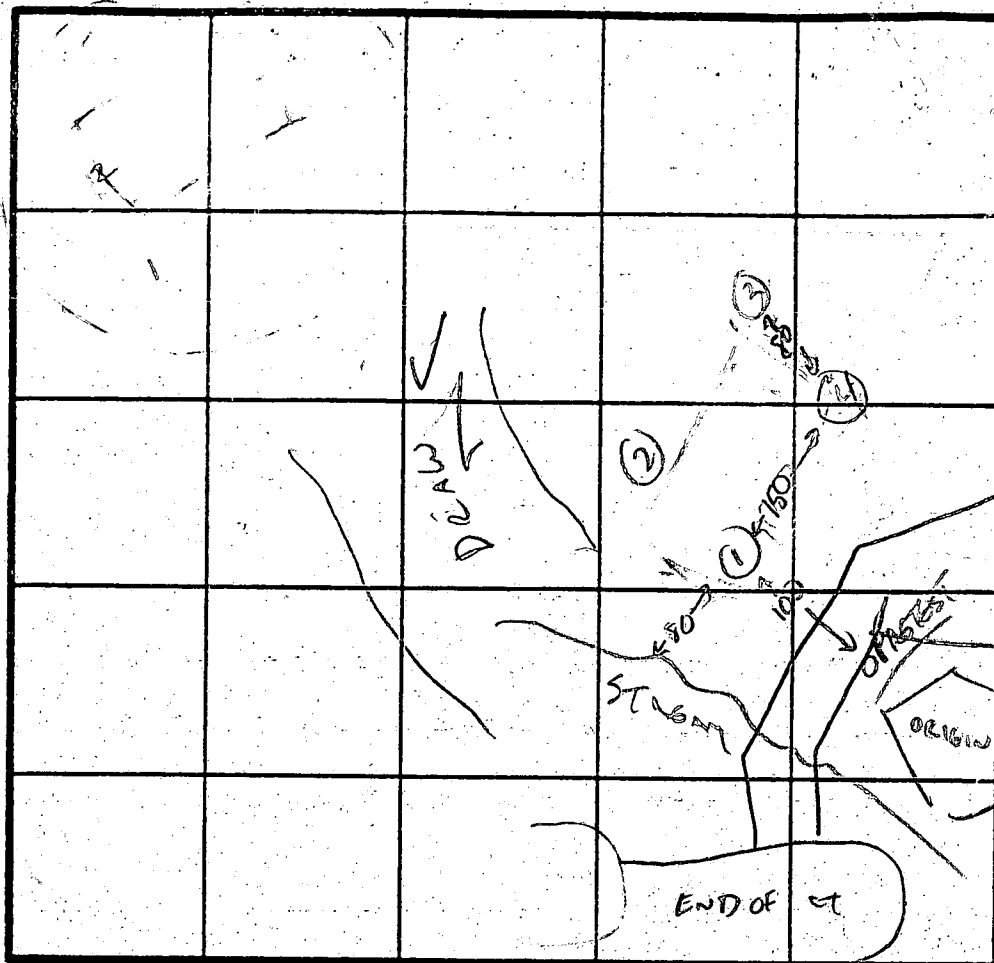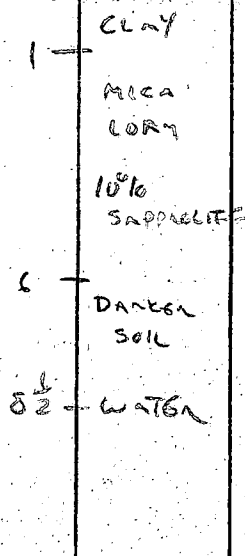


INDICATE NORTH - NAME ADJOINING ROADWAY AS BASE LINE.

#2

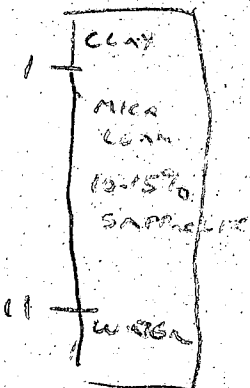

#3

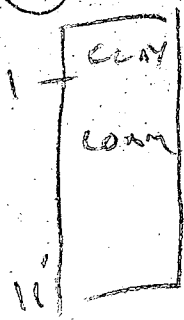


DATE	TEST NO.	DEPTH	PRE-WET		TEST - 1" DROP		TIME
			START	STOP	START	STOP	
MARCH 29/30 1988	1	2 1/2	2:14	2:16	2:16	2:20	4 MIN
		8 1/2	WATER	POSSIBLE WETNESS	TO 6' OL	HIGH	OK
	2	2 1/2	2:23:20	2:23:20	2:23:20	2:23:40	20 SEC
		NEW HOLE 2 1/2	2:25:30	2:25:30	2:25:50	2:26:40	50 SEC
		NEW HOLE 1 1/2	2:28:11	2:30:30	2:30:36	2:35	4 1/2 MIN
		11	WATER	NOT LIKELY TO BE WET	HIGH		OK
	3	3	2:39	2:41	2:41	2:46	4 MIN
		7	2:37	2:38	2:38	2:40	2 MIN
		11	VIS OK TO 11'				OK
	4	3	2:46	2:50	2:50	2:59	9 MIN
		7	VIS OK				
		10 SOIL	WET, 11 1/2 WATER				QUESTIONABLE
			POSSIBLE WETNESS TO 7 1/2				

LOW SIDE OF

REMARKS: APPROXIMATE AREA NO MORE THAN 1/2 DISTANCE BETWEEN 2#1
TYPE OF SOIL: MICA LOAM
TESTED BY: C. W. [Signature]
ALSO PRESENT: JEFF ALLEN, DEANETT

#4

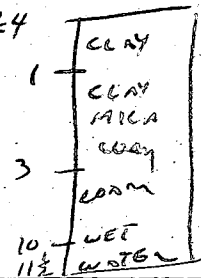

APPLICATION

PERCOLATION TESTING

A 40942

P _____

HOWARD COUNTY HEALTH DEPARTMENT
BUREAU OF ENVIRONMENTAL HEALTH
P.O. BOX 476 ELLICOTT CITY, MARYLAND 21043
TELEPHONE 461-9933

DISTRICT 4

DATE 1-29-88

TO: THE COUNTY HEALTH OFFICER
ELLICOTT CITY, MARYLAND

I HEREBY APPLY FOR THE NECESSARY TEST IN ORDER TO CONSTRUCT (OR RECONSTRUCT) A SEWAGE DISPOSAL SYSTEM.

PROPERTY OWNER Hilltop Development Corp

ADDRESS P.O. Box 208 CLARKSVILLE Md 21029 PHONE 531-5539

PROSPECTIVE BUYER _____

ADDRESS _____ PHONE _____

PROPERTY LOCATION:

SUBDIVISION SAND HILL ACRES LOT NO. 9

ROAD AND DESCRIPTION SAND HILL ROAD & LAMPLIGHTERS DRIVE

TAX MAP 16 PARCEL # 5

SIZE OF LOT 3 acres TYPE BLDG Single Family
(SINGLE FAMILY DWELLING OR COMMERCIAL)

THE SYSTEM INSTALLED UNDER THIS APPLICATION IS ACCEPTABLE ONLY UNTIL PUBLIC FACILITIES BECOME AVAILABLE. I FULLY UNDERSTAND THE FEE CONNECTED WITH THE FILING OF THIS PERC TEST APPLICATION IS NON-REFUNDABLE UNDER ANY CIRCUMSTANCES. I ALSO AGREE TO COMPLY

WITH ALL M.O.S.H.A. REQUIREMENTS IN TESTING THIS LOT. Richard J. Demmitt
(SIGNATURE OF APPLICANT)

APPROVED BY _____ FOR _____ DATE _____

REJECTED BY _____ FOR _____ DATE _____

HOLD PENDING FURTHER TESTS _____ DATE _____

REASONS FOR REJECTION OR HOLDING FALL 60 SEE A 40941
COMBINED WITH LOT 10



HD-216

THIS IS NOT A PERMIT

A40942


①

SOIL PROFILE

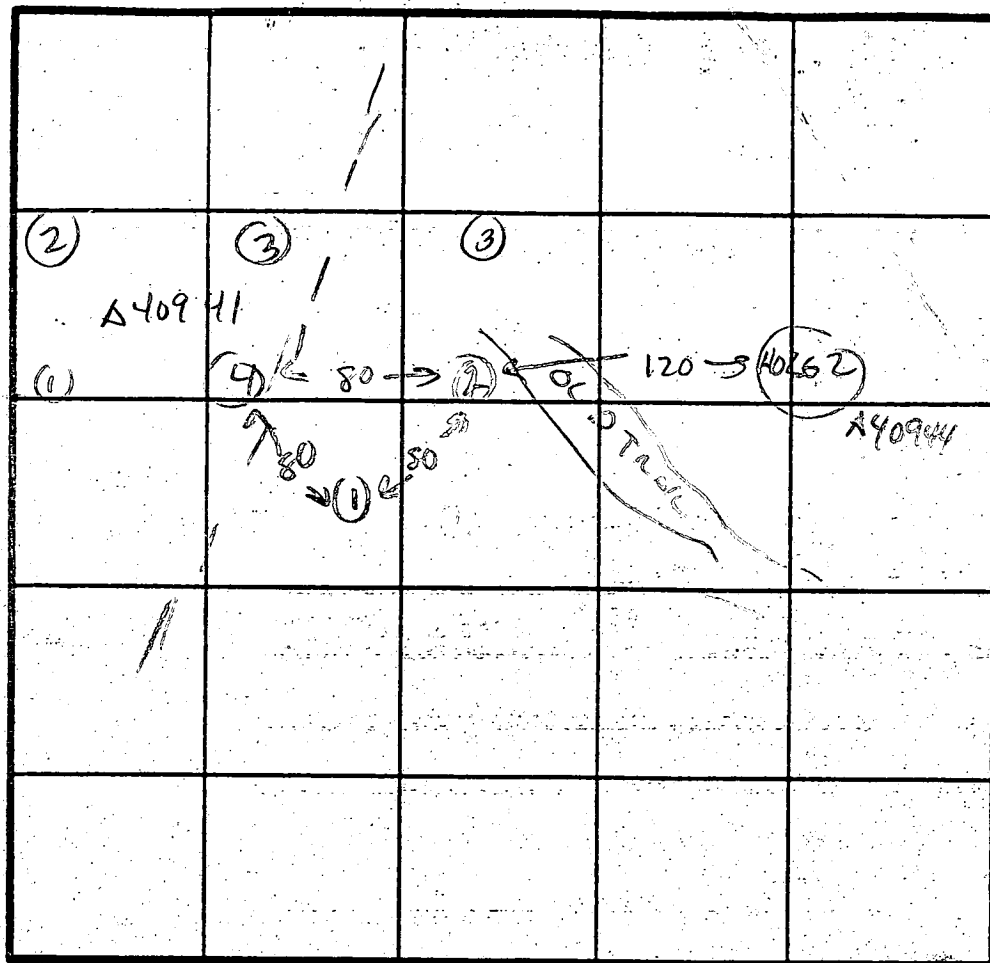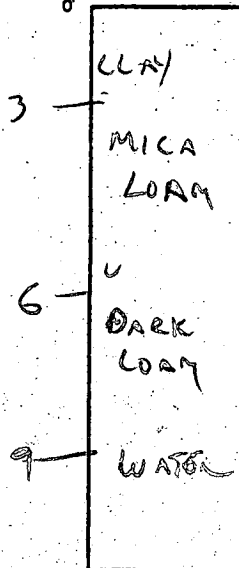

INDICATE NORTH - NAME ADJOINING ROADWAY AS BASE LINE.

2, 3

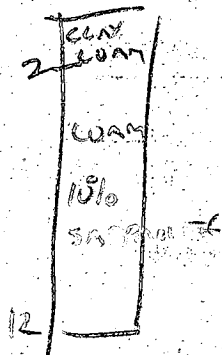

DATE	TEST NO.	DEPTH	PRE-WET		TEST - 1" DROP		TIME
			START	STOP	START	STOP	
3/29	1	ABANDONED - WATER	9'	WET TO 6'			
			MOTTLED, PATCHY	SOIL			
3/30	2	3	2:58	EST 10 MIN			
		7	VIS OK	LOAM			
		12	LOAM -	NO SIGN OF WATER			
	3	3	VIS OK -	LOAM			
		12	LOAM, SOILS DARKER -	REMOTE POSSIBILITY OF WATER			

REMARKS

TYPE OF SOIL

MICA SILT LOAM

TESTED BY

C. WILLIAMS

ALSO PRESENT

R. DEMMITT