

Menu Save Reset Cancel Help

Record Detail * (This section is required.)

Permit Type	Permit Number	Opened Date
Building/Residential/Misc/Deck	220000062	01/07/2020
Description of Work		
SFD/20x18 deck, 22x16 deck with landing, steps to grade		

[check spelling](#)

Address * (This section is required.)

Search Reset Clear Get Parcel & Owner

Street #	Street Name	Street Type
13717	WYE RIVER	DR
Unit Type	Unit #	X Coordinate
-Select-		78.9871
		Y Coordinate
		39.2574
City	State	Zip Code
DAYTON	MD	21036
		Primary
		Yes

Parcel * (This section is required.)

Search Reset Clear Get Address & Owner

GIS ID *	Parcel	Parcel Area	Land Value	Improved Value	Exemption Value	Plan Area
924311	80,90,551	1.36	266100	852700	588600	RURAL
Legal Description						
IMPSLOT 8 1.3662 A[]13717 WYE RIVER DR[]CASTLEBERRY AT TEN OAKS						

[check spelling](#)

Block	Lot	Census Tract	Council Dist	Inspection Dist	Supervisor Dist	Map #	DAP Zone
	8	605101	5				
Plan Area	State Tax Id	Subdivision Name					
	1405447097	Castleberry At Ten Oaks					
Section	Area	Tax Map					
		22					
Grid	Zoning District	ADC Map					
22-20	RR-DEO	4813-C9					
SDP No.	Final Plan No.	WP File No.					
	F-06-130						
Record Plat No.	WS Contract No.	FDP No.					
19096-1910		Yes					
Owner Occupied	Year Built	Historic District					
☐ Yes ☐ No	2012	☐ Yes ☒ No					
Historic District Registry No.	Stat Area	Flood Plain					
	5-01	☐ Yes ☒ No					
Building No							

Owner * (This section is required.)

Search Reset Clear

Name *		
BLOOM ALEXIS		
Address Line 1		
13717 WYE RIVER DRIVE		
Address Line 2		
Address Line 3		
Mail City	Mail State	Mail Zip Code
DAYTON	MD	21036
Phone	Primary	
443-934-2104	Yes	
E-mail		
Cell Number	Fax Number	

Professionals (This section is not required.)

Search Reset Clear

License # *	Business Name		
08010095285	TIMELESS CONSTRUCTION		
License Type *	First Name	Middle Name	Last Name
MHC Ind ☒	DAVID		BENFER
Primary	Address Line 1		
Yes ☒	5364 HESPERUS DRIVE		
	Address Line 2		
	City	State	ZIP Code
	COLUMBIA	MD	21044-0000
	Phone 1	Phone 2	Fax
	3016743604		4432838022
	E-mail		
	DCBENFER@HOTMAIL.COM		

Applicant (This section is not required.)

Search As Owner As Lic. Prof As Contact

Type *	First Name	MI	Last Name
Applicant ☒	DAVID	CHRIS	BENFER
Relationship	Full Name		
Applicant ☒	DAVID CHRISTOPHER BENFER		
Primary	Organization Name		
Yes ☒	TIMELESS CONSTRUCTION		
	Street Address		
	5364 HESPERUS DRIVE		
	Address Line 2		
	City	State	Zip Code
	COLUMBIA	MD	21044(-1846)
	Phone	Cell	Fax
	301-874-3604		
	E-mail *		
	DCBENFER@GMAIL.COM		

Addtl Info

Est Construction Cost *	Housing Units *	Number of Buildings *	Public Owned
24000	0	0	No ☒
Construction Type			
--Select--			



MISC PERMIT INFO

MISCELLANEOUS PERMIT INFORMATION				
Capital Project-No Fee *	Capital Project Number	Fee Exempt *	Roadside Tree Project Permit *	Roadside Tree Project Permit #
☐ Yes ☒ No		☐ Yes ☒ No	☐ Yes ☒ No	
Existing Use *	Water	Sewage	Expiration Date	
SFD ☒	Private ☒	Private ☒	7/16/2020	

PAYMENT INFORMATION

Check 1	Payee 1	Check 2	Payee 2	SAP Doc No	SAP Entered


Submit Cancel

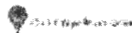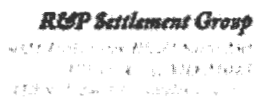

SURVEY NUMBER: 1806.1389

REVISION HISTORY: (REV.1 7/5/2018)


CASTLEBERRY AT TEN OAKS
HOWARD COUNTY, MARYLAND
07-05-2018 SCALE 1"=60'

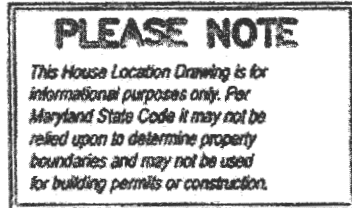

on-line
APR

APPROVED

~~WALKER-HAY~~ BUILDING PERMIT

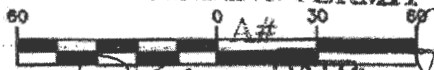


~~GRAPHIC SCALE (in feet)~~

1 inch = 30' ft

ACCURACY=3'

BH000065

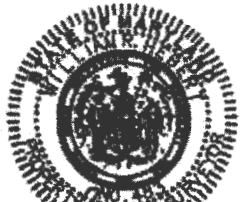

William J. Hall
EXPIRES 1-14-2019