



PROFESSIONAL CERTIFICATION: I HEREBY CERTIFY THAT THESE DOCUMENTS WERE PREPARED BY ME OR UNDER MY RESPONSIBLE CHARGE, AND THAT I AM A FULLY LICENSED PROFESSIONAL (LAND) SURVEYOR UNDER THE LAWS OF THE STATE OF MARYLAND, LICENSE NO. 21245, EXPIRATION DATE 1/27/15

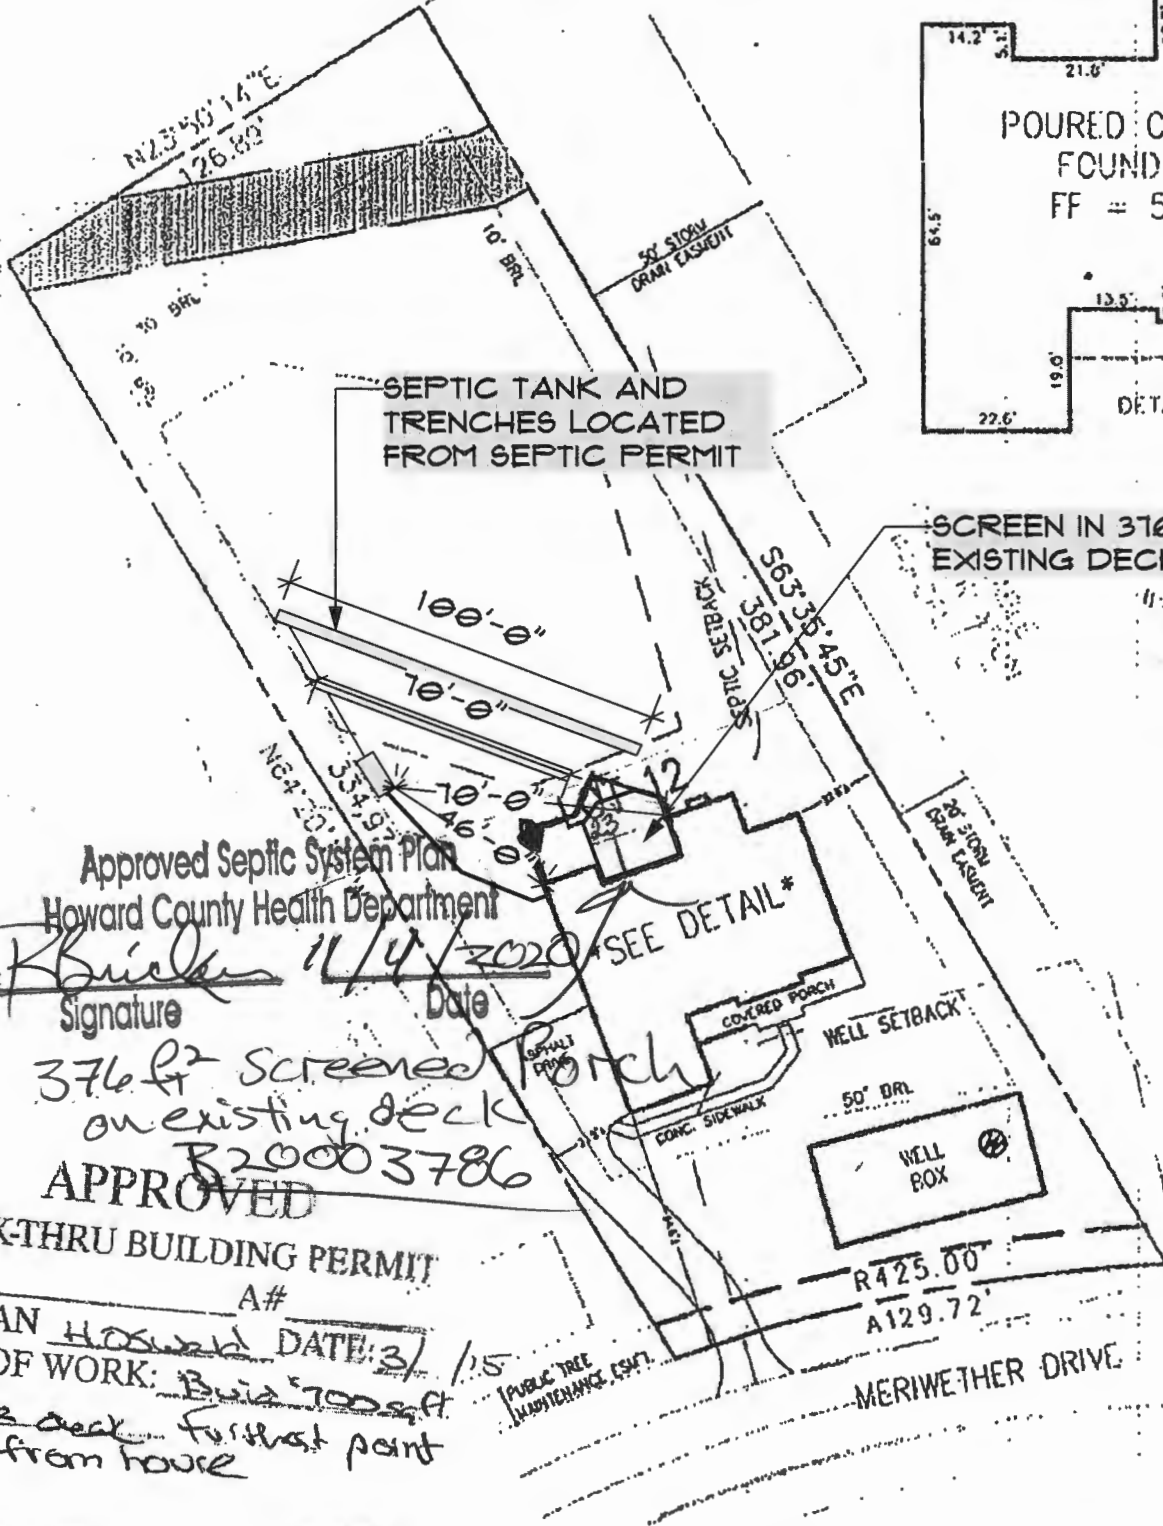

= SEPTIC AREA

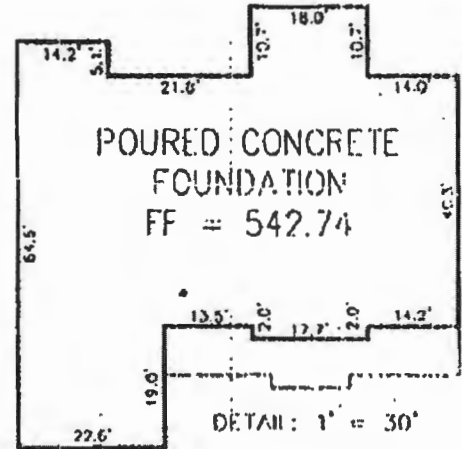

= STORM EASEMENT

#### SURVEYOR'S NOTE

I HEREBY CERTIFY THAT THE POSITION OF THE EXISTING IMPROVEMENTS SHOWN HEREON HAVE BEEN CAREFULLY ESTABLISHED BY ACCEPTED LAND SURVEYING PRACTICES AND THAT, UNLESS SHOWN, THERE ARE NO VISIBLE ENCROACHMENTS (OTHER WAY ACROSS THE PROPERTY LINES). THE PLANS IS OF BENEFIT TO A CONSUMER ONLY INsofar AS IT IS REQUIRED BY A LENDER OR A TITLE INSURANCE COMPANY OR ITS AGENT IN CONNECTION WITH CONTEMPLATED

#### LOCATION DRAWING

LOT 12

MERIWETHER FARMS

14809 Meriwether  
ADDRESS: 14809 MERIWETHER DRIVE  
GENEVA, MD 21727

Menu Save Reset Cancel Help

## Record Detail \* (This section is required.)

Permit Type	Permit Number	Opened Date
Building/Residential/Misc/Porch	B20003786	11/02/2020
Description of Work		
SFD//CONSTRUCT A 376 SQFT SCREENED PORCH ON TOP OF EXISTING DECK.		

[check spelling](#)

## Address \* (This section is required.)

Search Reset Clear Get Parcel &amp; Owner

Street #	Street Name	Street Type
14809	MERIWETHER	DR
Unit Type	Unit #	X Coordinate
--Select--		77.03122
		Y Coordinate
		39.25575
City	State	Zip Code
GLENELG	MD	21737
	Primary	
	Yes	

OK  
reb  
11/4/2020

## Parcel \* (This section is required.)

Search Reset Clear Get Address &amp; Owner

GIS ID *	Parcel	Parcel Area	Land Value	Improved Value	Exemption Value	Plan Area
1056871	28	44197	225100	978500	753400	RURAL
Legal Description						
IMPSLOT 12, 1.014 A.[ ]14809 MERIWETHER DR[ ]MERIWETHER FARM, SEC 2,						

[check spelling](#)

Block	Lot	Census Tract	Council Dist	Inspection Dist	Supervisor Dist	Map #	DAP Zone
	12	605601	5				
Plan Area	State Tax Id	Subdivision Name					
	1404593653	Meriwether Farm					
Section	Area	Tax Map					
		21					
Grid	Zoning District	ADC Map					
21-22	RC-DEO	4812-E10					
SDP No.	Final Plan No.	WP File No.					
	F-08-198						
Record Plat No.	WS Contract No.	FDP No.					
21762-2177							
Owner Occupied	Year Built	Historic District					
<input type="radio"/> Yes <input type="radio"/> No	2014	<input checked="" type="radio"/> Yes <input type="radio"/> No					
Historic District Registry No.	Stat Area	Flood Plain					
	4-09	<input type="radio"/> Yes <input checked="" type="radio"/> No					
Building No							

## Owner \* (This section is required.)

Search      Reset      Clear

## Name \*

TEDROW CHRISTOPHER T

## Address Line 1

14809 MERIWETHER DR

## Address Line 2

## Address Line 3

Mail City	Mail State	Mail Zip Code
GLENELG	MD	21737

Phone	Primary
410-984-5813	Yes

E-mail

Cell Number	Fax Number

## Professionals (This section is not required.)

Search      Reset      Clear

License # *	Business Name		
08010091659	MCWHORTER CONSTRUCTION LLC		
License Type *	First Name	Middle Name	Last Name
MHIC Ind	RYAN		MCWHORTER
Primary	Address Line 1		
Yes	6851 REDBERRY ROAD		
	Address Line 2		
	City	State	ZIP Code
	CLARKSVILLE	MD	210290000
	Phone 1	Phone 2	Fax
	4109845813		3018543449
	E-mail		

## Applicant (This section is not required.)

Search      As Owner      As Lic. Prof      As Contact

Type *	First Name	MI	Last Name
Applicant	MICHELLE		CLANCY
Relationship	Full Name		
Applicant	MICHELLE CLANCY		
Primary	Organization Name		
Yes	APPLIED & APPROVED PERMITS LLC		
	Street Address		
	P.O. BOX 310		
	Address Line 2		
	City	State	Zip Code
	PERRY HALL	MD	21128
	Phone	Cell	Fax
	443-340-1229		
	E-mail *		

MICHELLE@APPLIEDANDAPPROVED.COM

## Addtl Info

Est Construction Cost *	Housing Units *	Number of Buildings *	Public Owned
15000	0	0	No
Construction Type			
434 - Additions, Alterations and Conversions - Residential			

## PORCH INFORMATION

## PORCH INFORMATION

Capital Project-No Fee *	Capital Project Number	Fee Exempt *	Roadside Tree Project Permit *	Roadside Tree Project Permit #
<input type="radio"/> Yes <input checked="" type="radio"/> No		<input type="radio"/> Yes <input checked="" type="radio"/> No	<input type="radio"/> Yes <input checked="" type="radio"/> No	
Existing Use *	Type of Porch *	Type of Porch Foundation *	Total Square Footage *	
SFD	Screened Porch	Existing Deck	376 SQFT	
Water Supply	Sewage Disposal	Expiration Date		
Private	Private	5/2/2021		

## PAYMENT INFORMATION

Check 1	Payee 1	Check 2	Payee 2	SAP Doc No	SAP Entered

Submit

Cancel