

C 1 0210 SEQUENCE NO. (PEN USE ONLY)

1 2 3 4 5 6  
(THIS NUMBER IS TO BE PUNCHED  
IN COLS. 3-6 ON ALL CARDS)STATE OF MARYLAND  
WELL COMPLETION REPORT  
FILL IN THIS FORM COMPLETELY  
PLEASE PRINT OR TYPETHIS REPORT MUST BE SUBMITTED WITHIN  
45 DAYS AFTER WELL IS COMPLETED.COUNTY  
NUMBER A-34733ST/CO USE ONLY  
DATE Received

DATE WELL COMPLETED

8 13

07/28/99

Depth of Well  
22 285 26  
(TO NEAREST FOOT)PERMIT NO.  
FROM "PERMIT TO DRILL WELL"  
HO-88-0772OWNER C. Sharp Development Co.  
STREET OR RFD last name first name TOWN  
SUBDIVISION SECTION LOT 7

## WELL LOG

Not required for driven wells

STATE THE KIND OF FORMATIONS  
PENETRATED, THEIR COLOR, DEPTH,  
THICKNESS AND IF WATER BEARINGDESCRIPTION (Use  
additional sheets if needed)

FEET

FROM TO

Check  
if water  
bearing

SANDstone  
48  
Gray Mica  
Rock  
48 285

## GROUTING RECORD

WELL HAS BEEN GROUTED  
(Circle Appropriate Box)

TYPE OF GROUTING MATERIAL

CEMENT CM BENTONITE CLAY BC

NO. OF BAGS 9 NO. OF POUNDS 846

GALLONS OF WATER 54

DEPTH OF GROUT SEAL (to nearest foot)

from 0 ft. to 35 ft.  
(enter 0 if from surface)

## CASING RECORD

casing  
types  
insert  
appropriate  
code  
below  
ST CO  
STEEL CONCRETE  
PL OT  
PLASTIC OTHERMAIN CASING TYPE  
Nominal diameter top (main) casing (nearest inch)  
Total depth of main casing (nearest foot)  
54 6 55OTHER CASING (if used)  
diameter depth (feet)  
inch from toscreen type or open hole  
insert appropriate code below  
ST BR HO  
STEEL BRASS OPEN HOLE  
PL OT  
PLASTIC OTHER

C 2

DEPTH (nearest ft.)  
1 2 3 4 5 6 7 8 9 10 11 12 13 14 15 16 17 18 19 20 21  
H 0 53 285SLOT SIZE 1 2 3  
DIAMETER OF SCREEN (NEAREST INCH)  
from toGRAVEL PACK  
IF WELL DRILLED WAS FLOWING WELL INSERT F IN BOX 68OEP USE ONLY  
(NOT TO BE FILLED IN BY DRILLER)T (E.R.O.S.) W Q  
74 75 76  
70 72 OTHER DATA  
TELESCOPE CASING LOG INDICATOR

C 3

PUMPING TEST  
HOURS PUMPED (nearest hour) 2  
PUMPING RATE (gal. per min. to nearest gal.) 10  
METHOD USED TO MEASURE PUMPING RATE Bucket  
WATER LEVEL (distance from land surface)  
BEFORE PUMPING 20  
WHEN PUMPING 64  
TYPE OF PUMP USED (for test)  
A air P piston T turbine  
C centrifugal R rotary O other (describe below)  
J jet S submersible

## PUMP INSTALLED

DRILLER WILL INSTALL PUMP YES NO

IF DRILLER INSTALLS PUMP, THIS SECTION  
MUST BE COMPLETED FOR ALL WELLS  
EXCEPT HOME USE  
TYPE OF PUMP INSTALLED  
PLACE (A,C,J,P,R,S,T,O)  
IN BOX - SEE ABOVE:CAPACITY:  
GALLONS PER MINUTE (to nearest gallon)  
PUMP HORSE POWER  
PUMP COLUMN LENGTH (nearest ft.)CASING HEIGHT (circle appropriate box and enter casing height)  
above  
below  
LAND SURFACE (nearest foot)

## LOCATION OF WELL ON LOT

SHOW PERMANENT STRUCTURE SUCH AS  
BUILDING, SEPTIC TANKS, AND/OR  
LANDMARKS AND INDICATE NOT LESS  
THAN TWO DISTANCES  
(MEASUREMENTS TO WELL)I HEREBY CERTIFY THAT THIS WELL HAS BEEN CONSTRUCTED IN  
ACCORDANCE WITH COMAR 26.04.04 "WELL CONSTRUCTION"  
AND IN CONFORMANCE WITH ALL CONDITIONS STATED IN THE  
ABOVE CAPTIONED PERMIT, AND THAT THE INFORMATION PRE-  
SENTED HEREIN IS ACCURATE AND COMPLETE TO THE BEST OF  
MY KNOWLEDGE.

DRILLERS IDENT. NO. 238

DRILLERS SIGNATURE  
(MUST MATCH SIGNATURE ON APPLICATION)SITE SUPERVISOR (sign. of driller or journeyman  
responsible for sitework if different from permittee)

COUNTY

B 1 <b>5682</b> <small>(THIS NUMBER IS TO BE PUNCHED IN COLS. 3-6 ON ALL CARDS)</small>	SEQUENCE NO. (DP USE ONLY)	<b>STATE OF MARYLAND</b> <b>PERMIT TO DRILL WELL</b> please print or type	STATE PERMIT NUMBER <b>HO-98-0772</b> <small>fill in this form completely</small>
Date Received (APA) <b>052489</b>		B 3 <b>LOCATION OF WELL</b>	
<b>OWNER INFORMATION</b> CROSEN DEVELOPMENT CO 3775 SHADY LAKE GLENWOOD MD 21738		HOWARD COUNTY CHARLES SHARP SUB. SECTION 44 LOT 7 GLENMCKE MILES FROM TOWN (enter 0 if in town) <b>1 1/2</b> MI	
<b>DRILLER INFORMATION</b> Joseph L. Mayne 238 77 License No. 80 Joseph L. Mayne Well Drilling 5512 Ridge Rd. Mt. Airy 21771 Address Signature Date 5/22/89		B 4 <b>DIRECTION OF WELL FROM TOWN (CIRCLE BOX)</b> 	
B 2 <b>WELL INFORMATION</b> APPROX. PUMPING RATE (GAL. PER MIN.) <b>50</b> AVERAGE DAILY QUANTITY NEEDED (GAL. PER DAY) <b>500</b>		Sharp Road ON WHICH SIDE OF ROAD (CIRCLE APPROPRIATE BOX) NORTH WEST SOUTH EAST DISTANCE FROM ROAD <b>220</b> ENTER FT or MI <b>FT</b>	
<b>USE FOR WATER (CIRCLE APPROPRIATE BOX)</b> <input checked="" type="checkbox"/> HOME (SINGLE OR DOUBLE HOUSEHOLD UNIT ONLY) <input type="checkbox"/> FARMING (LIVESTOCK WATERING & AGRICULTURAL IRRIGATION) <input type="checkbox"/> INDUSTRIAL, COMMERCIAL, STATE AND FEDERAL GOV. OTHER (REQUIRES APPROPRIATION PERMIT) <input type="checkbox"/> PUBLIC OR PRIVATE WATER COMPANY (REQUIRES APPROPRIATION PERMIT AND STATE HEALTH DEPARTMENT APPROVAL) <input type="checkbox"/> TEST, OBSERVATION, MONITORING (MAY REQUIRE APPROPRIATION PERMIT)		NOT TO BE FILLED IN BY DRILLER HEALTH DEPARTMENT APPROVAL HOWARD COUNTY NAME A-34733 COUNTY NO. STATE SIGNATURE INSERT S DATE ISSUED <b>061689</b> CO SIGNATURE <b>Craig Walling</b> EXP. DATE <b>12/16/89</b> NORTH GRID <b>520000</b> EAST GRID <b>0497000</b>	
APPROXIMATE DEPTH OF WELL <b>200</b> FEET APPROXIMATE DIAMETER OF WELL <b>6</b> INCH		SHOW MAJOR FEATURES OF BOX & LOCATE WELL WITH AN X SOURCES OF DRILLING WATER 1. WELL 2. 3. WRITE THE BOX NUMBER FROM THE MAP HERE E <b>497</b> N <b>529 0</b>	
<b>METHOD OF DRILLING (circle one)</b> BORED (or Augered) JETTED Jetted & DRIVEN AIR-ROTARY AIR-PERCussion ROTARY (Hydraulic Rotary) CABLE REVERSE-ROTARY Drive-POINT other		DRAW A SKETCH BELOW SHOWING LOCATION OF WELL IN RELATION TO NEARBY TOWNS AND ROADS AND GIVE DISTANCE FROM WELL TO NEAREST ROAD JUNCTION 	
<b>REPLACEMENT OR DEEPEMED WELLS (CIRCLE APPROPRIATE BOX)</b> <input checked="" type="checkbox"/> THIS WELL WILL NOT REPLACE AN EXISTING WELL <input type="checkbox"/> THIS WELL WILL REPLACE A WELL THAT WILL BE ABANDONED AND SEALED <input type="checkbox"/> THIS WELL WILL REPLACE A WELL THAT WILL BE USED AS A STANDBY <input type="checkbox"/> THIS WELL WILL DEEPEMED AN EXISTING WELL PERMIT NUMBER OF WELL TO BE REPLACED OR DEEPEMED (IF AVAILABLE)		Not to be filled in by driller (OEP USE ONLY) APPROP. PERMIT NUMBER <b>GAP</b> FORCE <b>W</b> WRITE INITIALS IN BOX PERMIT NO. <b>HO-98-0772</b>	
SPECIAL CONDITIONS			

Well Permit No. HO - 48-0772

SHARP REV.

Lot 7

## Block

Plat

**Sec.**

Owner

## CROSEN DEVELOPMENT

Depth of well 285'

Distance of measuring point (M.P.) above ground 2

Static water level (S.W.L.) below M.P. 20

Time pump started 8:20

Pumping rate 20 gpm.

Total time 15 min to reach pumping water level 64 ft. below M.P.

[illegible]



Bureau of Environmental Health  
8930 Stanford Blvd | Columbia, MD 21045  
410.313.2640 - Voice/Relay  
410.313.2648 - Fax  
1.866.313.6300 - Toll Free

Maura J. Rossman, M.D., Health Officer

**Information Form for the Installation of the Well Pump, Pitless Adapter, and Supply Piping**

NOTE: The installer is responsible for requesting an inspection prior to 9 am on the day of the desired inspection. No work is to be covered until approved by the Health Department. All installations must comply with the National Standard Plumbing Code (NSPC, as amended locally) and COMAR 26.04.04 (MD Well Construction Regulations). Submission of a complete form is required prior to Use and Occupancy approval.

Company Name: K+T Plumbing Telephone # 443-8449073  
Address: P.O. Box 2153  
Westminster, MD 21157

Must circle one: Licensed Plumber / Licensed Well Driller / Licensed Well Pump Installer

License # and name of individual responsible for the field installation  
Name (Print): Tom Dumas License # 21451

\*A licensed individual must perform the actual installation. Apprentices must be under the supervision of a licensed journeyman or master plumber, pump installer or well driller. Licenses may be subjected to field verification. Unlicensed individuals may be reported to the appropriate licensing agency.

Name of Property Owner: 49061309 Telephone #: 303 390 6700  
Subdivision: \_\_\_\_\_ Lot #: \_\_\_\_\_ Well Tag #: HO-81-0772  
Site Address: 3985 Shump Rd  
Glenwood MD 21738

**Submersible Pump Data**

Make: Daton  
Model #: 1278-1  
Pump Capacity: 2  
Well Yield: 12 GPM

Depth of well encountered at time of pump installation: 300 (feet)

If pump capacity exceeds well yield, a low water cut-off switch is required by NSPC 1990 Section 17.8.4

Must circle one: Torque arrestors / Cable guards / Other acceptable method used

Safety rope, if used, attached to brass rope adapter or other acceptable method inside of well casing MA

**Pitless Adapter**

Make: Simons  
Model #: 1522SD  
GPM Depth: 43 (36" min)

GPM NSF/WSC approved: ✓

**Well Cap and Electric Conduit**

Two piece watertight cap: ✓  
Screened, vented well cap: ✓  
Cap secured to casing: ✓  
Conduit min 18" B.G.: ✓  
Conduit secured to well cap: ✓

**Piping to house**

Type: Poly  
PSI: 250 (160 psi min)  
Depth of supply line: 43 (36" min)

**House Connection**

PVC sleeve to undisturbed soil at wall penetration: ✓  
Length of sleeve (5' minimum from foundation): ✓  
Sleeve sealed properly: ✓

The water supply line is required to be at least ten feet from the septic tank, pump chamber, sewage piping, distribution box, drainfields, and sewage reserve area. If this cannot be accomplished, contact this office for approval prior to installation.

Signature of company representative responsible for installation: Thomas H. Dumas Jr. date: 3/30/20


**For Health Department Use Only - Not to be completed by installer**

Date Insp. Requested: \_\_\_\_\_ Date Insp. Approved: 3/30/20 Inspector: 1200  
Inspection Data: Pitless adapter watertight & water supply line at least 36" below grade ✓  
Two piece cap installed and attached to casing securely ✓  
Elec. conduit extends at least 18" below grade/attached to cap properly ✓  
Safety rope not outside of well cap/casing ✓  
Correct well tag attached properly and casing 8" above finished grade ✓  
Water supply line sleeved adequately at house connection ✓  
Adequate grout observed below pitless adapter ✓

(Revised form 10/24/2018)

Website: [www.hchealth.org](http://www.hchealth.org) Facebook: [www.facebook.com/hocohealth](https://www.facebook.com/hocohealth) Twitter: @HoCoHealth

COORDINATE TABLE			CURVE DATA					
PT	NORTH	EAST	CURVE	RADIUS	LENGTH	TANGENT	$\Delta$	CHORD BEARING & DISTANCE
218	520261.28	797017.02	210-157	500.00'	38.52'	19.27'	04°-24'-52"	S 76°-31'-40" W 38.51'
193	520576.96	797618.27						
192	520399.88	797711.24						
212	520327.05	797719.21						
211	520355.32	797899.42						
210	519724.16	798059.47						
157	519715.19	798022.02						
217	519693.83	798067.16						
147	519602.88	797611.75						
146	519623.49	797607.64						
15	519988.06	797403.27						
14	519946.34	797198.86						
143	519939.55	797185.94						
624	519940.10	797212.38						
638	520274.03	797041.31						

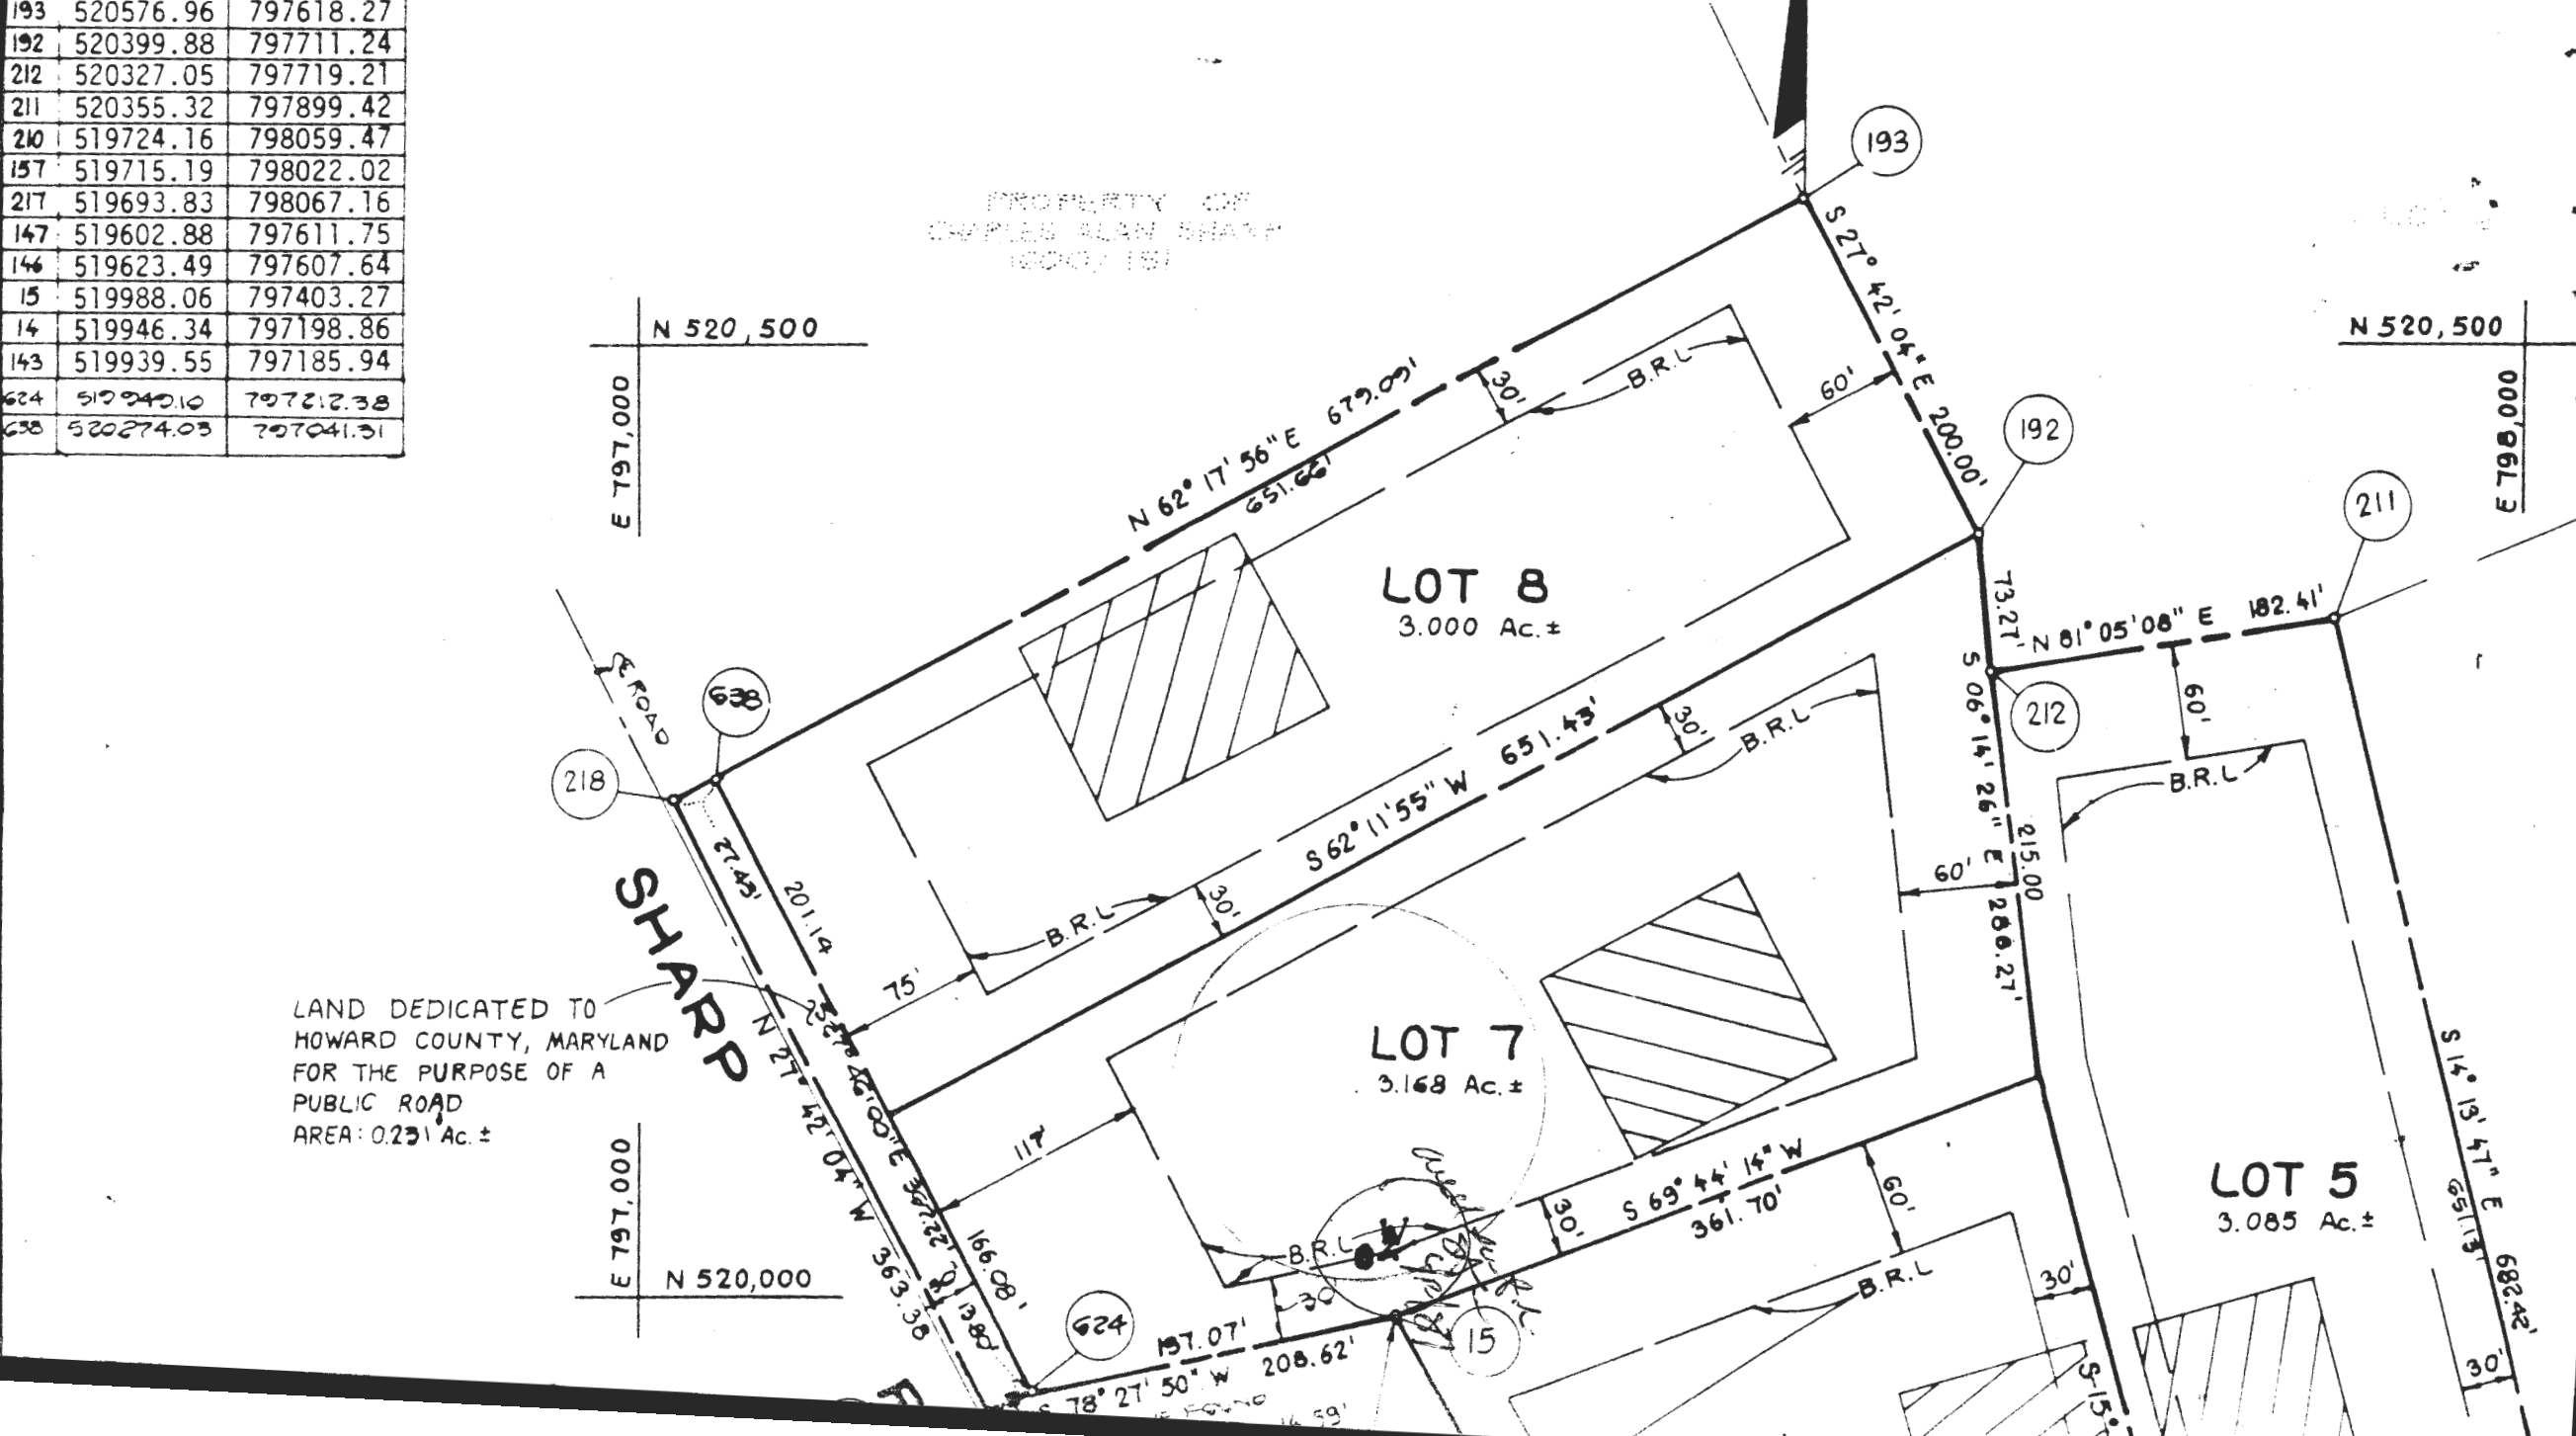

CHARLES SHARP  
SUBDIVISION: SHARP PROPERTY

A 34733  
LOT NUMBER: #5 LOT 7

DRY WELL OR DRY WELL AND TRENCH

	Septic Tank	_____ sq. ft./bedroom
		<u>Minimum Total square Feet</u>
3 bedroom	1000 gallon	_____
4 bedroom	1250 gallon	_____
5 bedroom	1500 gallon	_____

Inlet \_\_\_\_\_ feet below original grade.

Bottom maximum depth \_\_\_\_\_ feet below original grade.

Effective area begins at \_\_\_\_\_ feet below original grade.

NOTE: If trench is used to make up absorbent area, run the trench on level ground and leave a 5 foot earth buffer between dry well and trench. No trench is to exceed 100 feet in length. Trench inlet to be same as dry well, with \_\_\_\_\_ feet of stone below distribution pipe.

TRENCHES

180 sq. ft./bedroom

Trench to be 2 wide.

Inlet 3.5 feet below original grade.

Bottom maximum depth 7.5 feet below original grade.

Effective area begins at 3.5 feet below original grade.

4.0 feet of stone below distribution pipe.

- NOTE:
- (1) No trench to exceed 100 feet in length.
  - (2) If more than one trench used, a distribution box is required.
  - (3) Trenches to be installed on level ground.
  - (4) Call for inspection of trench before gravel is installed.
  - (5) Provide 6"-8" diameter cleanout and cap to grade or above on septic tank and drywell.
  - (6) If a Garbage disposal is used, increase septic tank capacity by 50% and increase absorbant sidewall area by 22%.

LOCATION: Beginning From THE REAR RIGHT CORNER PLACE THE FIRST  
TRENCH 215 FT DOWN THE RIGHT (361.70') LOT LINE AND 30  
FT FROM THE SAME LOT LINE AS SEEN WHEN FACING THE  
LOT FROM SHARP Rd. RUN TRENCHES ON CONTOUR TOWARD THE  
REAR LOT LINE. 7-21-88 S. Allen



