

C1 7986

SEQUENCE NO.
(MDE USE ONLY)STATE OF MARYLAND
WELL COMPLETION REPORT
FILL IN THIS FORM COMPLETELY
PLEASE PRINT OR TYPETHIS REPORT MUST BE SUBMITTED WITHIN
45 DAYS AFTER WELL IS COMPLETED.COUNTY
NUMBER **A45 760-A**SY/CO USE ONLY
DATE RECEIVED

082696

DATE WELL COMPLETED

081796

Depth of Well

22 400 26
(TO NEAREST FOOT)PERMIT NO.
FROM "PERMIT TO DRILL WELL"

H0-94-0874

OWNER **H.P. PARTNERSHIP**
STREET OR RFD **SANNER RD.** TOWN **SCAGESVILLE**
SUBDIVISION **CASHMARK** SECTION **1** LOT **1**

WELL LOG

Not required for driven wells

STATE THE KIND OF FORMATIONS
PENETRATED, THEIR COLOR, DEPTH,
THICKNESS AND IF WATER BEARING

DESCRIPTION (Use additional sheets if needed)	FEET		check if water bearing
	FROM	TO	
Top Soil	0	2	
Sandy	2	90	✓
Sand Stone	90	95	
MICKA	95	120	
Sand Stone	120	125	✓
MICKA	125	400	

GROUTING RECORD

WELL HAS BEEN GROUTED
(Circle Appropriate Box)yes ☒ no ☐

TYPE OF GROUTING MATERIAL (Circle one)

CEMENT ☒ BENTONITE CLAY ☐NO. OF BAGS **22** NO. OF POUNDS **2200**GALLONS OF WATER **132**

DEPTH OF GROUT SEAL (to nearest foot)

from **0** ft. to **40** ft.
(enter 0 if from surface)

CASING RECORD

casing
types
insert
appropriate
code
below☒ STEEL☐ CONCRETE☒ PLASTIC☐ OTHERMAIN
CASING
TYPENominal diameter
top (main) casing
(nearest inch)Total depth
of main casing
(nearest foot)☒**6****100**

OTHER CASING (if used)

EACH CASING
diameter depth (feet)
inch from toscreen type
or open hole
insert
appropriate
code
below

SCREEN RECORD

☒ STEEL☐ BRASS☐ OPEN☐ BRONZE☐ HOLE☐ PLASTIC☐ OTHERNUMBER OF UNSUCCESSFUL WELLS: **0**WELL HYDROFRACTURED ☒ ☐

CIRCLE APPROPRIATE LETTER.

- A** A WELL WAS ABANDONED AND SEALED
WHEN THIS WELL WAS COMPLETED.
- E** ELECTRIC LOG OBTAINED
- P** TEST WELL CONVERTED TO PRODUCTION
WELL.

I HEREBY CERTIFY THAT THIS WELL HAS BEEN CONSTRUCTED IN
ACCORDANCE WITH COMAR 26.04.04 "WELL CONSTRUCTION" AND
IN CONFORMANCE WITH ALL CONDITIONS STATED IN THE ABOVE
CAPTIONED PERMIT, AND THAT THE INFORMATION PRESENTED
HEREIN IS ACCURATE AND COMPLETE TO THE BEST OF MY
KNOWLEDGE.TYPE: MWD/MSD/MGD **116**DRILLERS LIC. NO. **116****Thad Meyer**DRILLERS SIGNATURE
(MUST MATCH SIGNATURE ON APPLICATION)LIC. NO. **117****Thad E Meyer**SITE SUPERVISOR (sign. of driller or journeyman
responsible for sitework if different from permittee)

C 2

DEPTH (nearest ft.)

1 2 3 4 5 6 7 8 9 10 11 12 13 14 15 16 17 18 19 20 21 22 23 24 25 26 27 28 29 30 31 32 33 34 35 36 37 38 39 40 41 42 43 44 45 46 47 48 49 50 51

SLOT SIZE 1 2 3
DIAMETER OF SCREEN (NEAREST INCH)

from to

GRAVEL PACK

IF WELL DRILLED WAS

FLOWING WELL INSERT

F IN BOX 68

MDE USE ONLY

(NOT TO BE FILLED IN BY DRILLER)

T (E.R.O.S.) W Q

70 72 74 75 76

TELESCOPE LOG OTHER DATA

CASING INDICATOR

C 3

PUMPING TEST

HOURS PUMPED (nearest hour) **6**PUMPING RATE (gal. per min.) **1.3**METHOD USED TO MEASURE PUMPING RATE **Bucket**

WATER LEVEL (distance from land surface)

BEFORE PUMPING **34** ft.WHEN PUMPING **245** ft.

TYPE OF PUMP USED (for test)

☒ air ☐ piston ☐ turbine☐ centrifugal ☐ rotary ☐ other (describe below)☐ jet ☒ submersible

PUMP INSTALLED

DRILLER WILL INSTALL PUMP (CIRCLE) (YES or NO)

IF DRILLER INSTALLS PUMP, THIS SECTION
MUST BE COMPLETED FOR ALL WELLS.TYPE OF PUMP INSTALLED
PLACE (A,C,J,P,R,S,T,O)
IN BOX 29CAPACITY:
GALLONS PER MINUTE
(to nearest gallon)

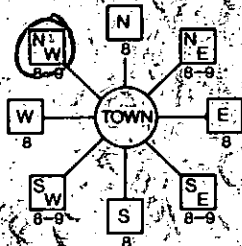
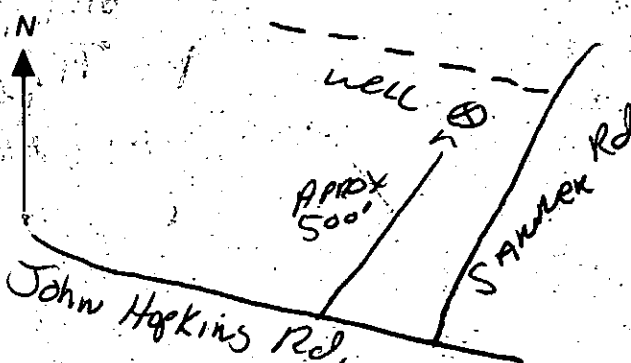
PUMP HORSE POWER

PUMP COLUMN LENGTH
(nearest ft.)CASING HEIGHT (circle appropriate box
and enter casing height)☒ above☐ belowLAND SURFACE **2** (nearest foot)

LOCATION OF WELL ON LOT

SHOW PERMANENT STRUCTURE SUCH AS
BUILDING, SEPTIC TANKS, AND /OR
LANDMARKS AND INDICATE NOT LESS
THAN TWO DISTANCES
(MEASUREMENTS TO WELL)**Prop Line**
55'
45'
well
Road

COUNTY

B 1 8300 (THIS NUMBER IS TO BE PUNCHED IN COLS. 3-6 ON ALL CARDS)		SEQUENCE NO. (MDE USE ONLY)		STATE OF MARYLAND PERMIT TO DRILL WELL please print or type		STATE PERMIT NUMBER HO-94-0874 fill in this form completely	
Date Received (APA) 062296				B 3 LOCATION OF WELL			
OWNER INFORMATION HOPKINS PLAZA PART. 15 Last Name 34 First Name 10805 HICKORY RIDGE 36 Street or RFD 56 COLUMBIA MD 21044 57 Town 70 State 72 Zip 78				HOWARD 8 COUNTY 21 CASHMARK PROPERTY 23 SUBDIVISION 42 SECTION + LOT 1 44 46 48 50 SODAGGSVILLE 52 NEAREST TOWN 71 MILES FROM TOWN (enter 0 if in town) 2 MI 73 76 77 78			
DRILLER INFORMATION Ralph MAYNE Driller's Name 77 License No. 80 Ralph MAYNE Well Drilling Firm Name 9120 Brown Church Rd. N.H. Aring Address Ralph Mayne 6/13/96 Signature Date				B 4 John Hopkins Rd. 11 NEAR WHAT ROAD 30 ON WHICH SIDE OF ROAD (CIRCLE APPROPRIATE BOX) 34 37 500 DISTANCE FROM ROAD ENTER FT OR MI FT 38 39 TAX MAP: 41 BLK: _____ PARCEL 121			
B 2 WELL INFORMATION APPROX. PUMPING RATE (GAL. PER MIN.) 5 8 12 AVERAGE DAILY QUANTITY NEEDED (GAL. PER DAY) 500 14 20				DIRECTION OF WELL FROM TOWN (CIRCLE BOX) 			
USE FOR WATER (CIRCLE APPROPRIATE BOX) ☒ D HOME (SINGLE OR DOUBLE HOUSEHOLD UNIT ONLY) ☐ F FARMING (LIVESTOCK WATERING & AGRICULTURAL IRRIGATION) ☐ I INDUSTRIAL, COMMERCIAL, STATE AND FEDERAL GOV. OTHER (REQUIRES APPROPRIATION PERMIT) ☐ P PUBLIC OR PRIVATE WATER COMPANY (REQUIRES APPROPRIATION PERMIT AND STATE HEALTH DEPARTMENT APPROVAL) ☐ T TEST, OBSERVATION, MONITORING (MAY REQUIRE APPROPRIATION PERMIT)				NOT TO BE FILLED IN BY DRILLER HEALTH DEPARTMENT APPROVAL Howard A45760-A COUNTY NAME COUNTY NO. STATE SIGNATURE _____ INSERT S ☐ DATE ISSUED 073096 C. Will 7/29/97 43 48 CO SIGNATURE EXP. DATE NORTH GRID 483000 EAST GRID 083000 50 55 57 63			
APPROXIMATE DEPTH OF WELL 1150 FEET 24 28				SHOW MAJOR FEATURES OF BOX & LOCATE WELL WITH AN X SOURCES OF DRILLING WATER well 2 3 WRITE THE BOX NUMBER FROM THE MAP HERE E 820 N 4803 000 000			
APPROXIMATE DIAMETER OF WELL 6" NEAREST INCH 30 37				METHOD OF DRILLING (circle one) BORED (or Augered) ☒ JETTED ☐ Jetted & DRIVEN ☐ AIR-ROTARY ☒ AIR-PERCussion ☐ ROTARY (Hydraulic Rotary) ☐ CABLE ☐ REVERSE-ROTARY ☐ DRIVE-POINT ☐ other _____			
REPLACEMENT OR DEEPEMED WELLS (CIRCLE APPROPRIATE BOX) ☒ N THIS WELL WILL NOT REPLACE AN EXISTING WELL ☐ Y THIS WELL WILL REPLACE A WELL THAT WILL BE ABANDONED AND SEALED ☐ S THIS WELL WILL REPLACE A WELL THAT WILL BE USED AS A STANDBY-CONTACT LOCAL APPROVING AUTHORITY FOR POLICY ON STANDBY WELLS ☐ D THIS WELL WILL DEEPEN AN EXISTING WELL PERMIT NUMBER OF WELL TO BE REPLACED OR DEEPEMED (IF AVAILABLE) _____				DRAW A SKETCH BELOW SHOWING LOCATION OF WELL IN RELATION TO NEARBY TOWNS AND ROADS AND GIVE DISTANCE FROM WELL TO NEAREST ROAD JUNCTION. 			
Not to be filled in by driller (MDE OR COUNTY USE ONLY) APPROX. PERMIT NUMBER _____ 54 63 FORCE CW WRITE INITIALS IN BOX HO-94-0874 PERMIT No. HO-94-0874 67 68 70 71 72 73 74 75 76 77 78 79				SPECIAL CONDITIONS NOTE - APPROVING AUTHORITIES SHOULD USE SEPARATE SHEET IF NEEDED			

HOWARD COUNTY HEALTH DEPARTMENT
Bureau of Environmental Health
3525-H Ellicott Mills Drive
Ellicott City, MD 21043

~~401-9900~~
313-2640

APPLICATION FOR PITLESS ADAPTER, WELL PUMP AND PRESSURE TANK INSTALLATION

New Installation ☒
Replacement ☐

Receipt # _____
Date 1/13/00

Name of Installer J.A. Smith + Co. Inc.

Telephone 410-796-7532

License Number 5581

Certified Well Pump Installer _____ Well Driller _____ Registered Plumber ☒

Name of Property Owner Marvek Property LLC

Telephone 410-480-9805

Subdivision Cashmark Property Lot #

Well Tag # HO-94-0874

Site Address 7598 Sander Road Clarksville, MD 21029

Pump

1. Type

- a. Deep well jet _____
b. Shallow well jet _____
c. Submersible ☒

2. Make Goulds

3. Model # 5G510412

4. Capacity 5 GPM

5. Pump exceeds well capacity Yes _____ No ☒

6. If Yes, is low pressure cutoff switch installed? Yes _____ No _____

7. What methods are used to protect the pump and electrical wiring from vibrations? Torque arrestors ☒ Cable guards ☒ Other _____

Motor

1. Horsepower 1HP

2. RPM _____

3. Voltage 230V

a. 110 _____

b. 220 ☒

Pitless Adapter

1. Make _____

2. Model # _____

3. Depth 4'

Tank

1. Capacity Wx 250

2. Pressure relief valve? YES

2/25/00 Safety line was
ran through cap sections.
Seal questionable. (BR)

Piping

1. Type Black Poly

2. Size 1"

3. NSF and/or BOCA

Code approved YES

4. Depth of supply

line 230'

Well data

1. Depth 400 ft. 250'

2. Yield 1.5 GPM

3. Static water

level 34 ft.

4. Will water supply

be disinfected by

installer? NO

I understand that it is my responsibility to notify the Howard County Health Department when the installation is ready for inspection (otherwise this permit is null and void).

All information given above is true to the best of my knowledge.

10/7/99-WPI OK-SRK

Signature of Applicant: J.A. Smith

2/28/00-Safety Rope Issue Resolved (SRK)

Date: 1-13-2000

Note: A sticker indicating approval/status of the installation will be placed on the well casing at the time of the inspection.